


NW 1/4, SEC. 10, TWP. 30, RGE. 23

CO. RD. "I"

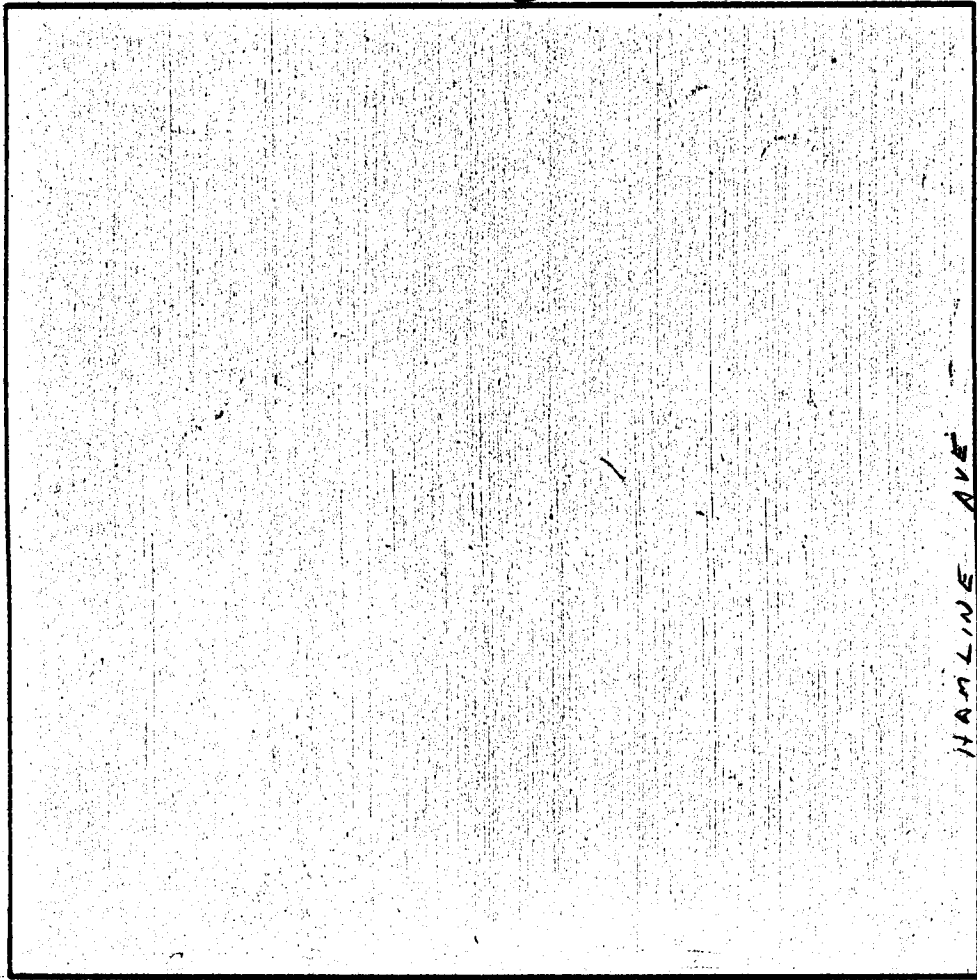

HAMLINE AVE