


SW 1/4, SEC. 10, TWP. 30, RGE. 23

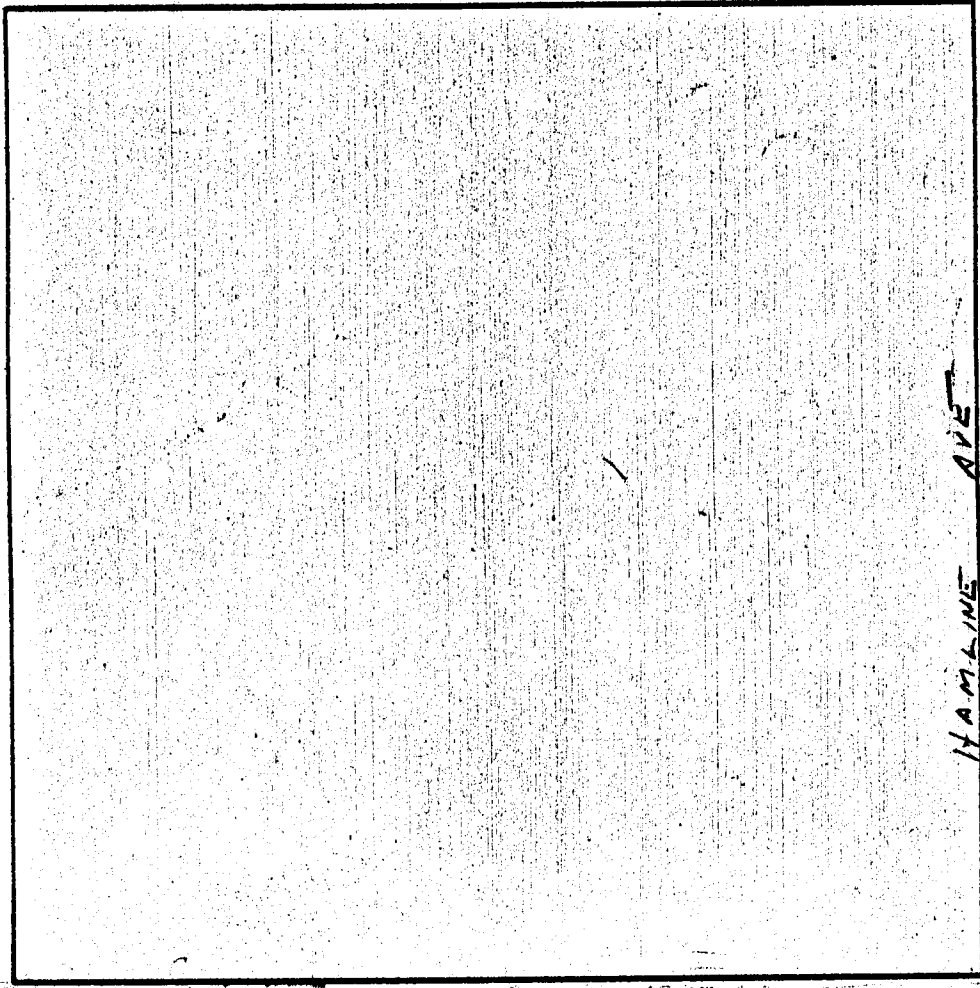

HAMILINE AVE