


SE 1/4, SEC. 14, TWP. 30, RGE. 23

Co RD "162"

 

SRP
PP
SRP
24' PP
145.02
134.06
Granite

105.81
SRP
PP

S.T.H. # 96

40.49
SRP
PP
Cty
M.H.
1975
17546
SRP
PP

DALE ST

C. I. Mon.

1236
SRP
PP