


NE 1/4, SEC. 15, TWP. 30, RGE. 23

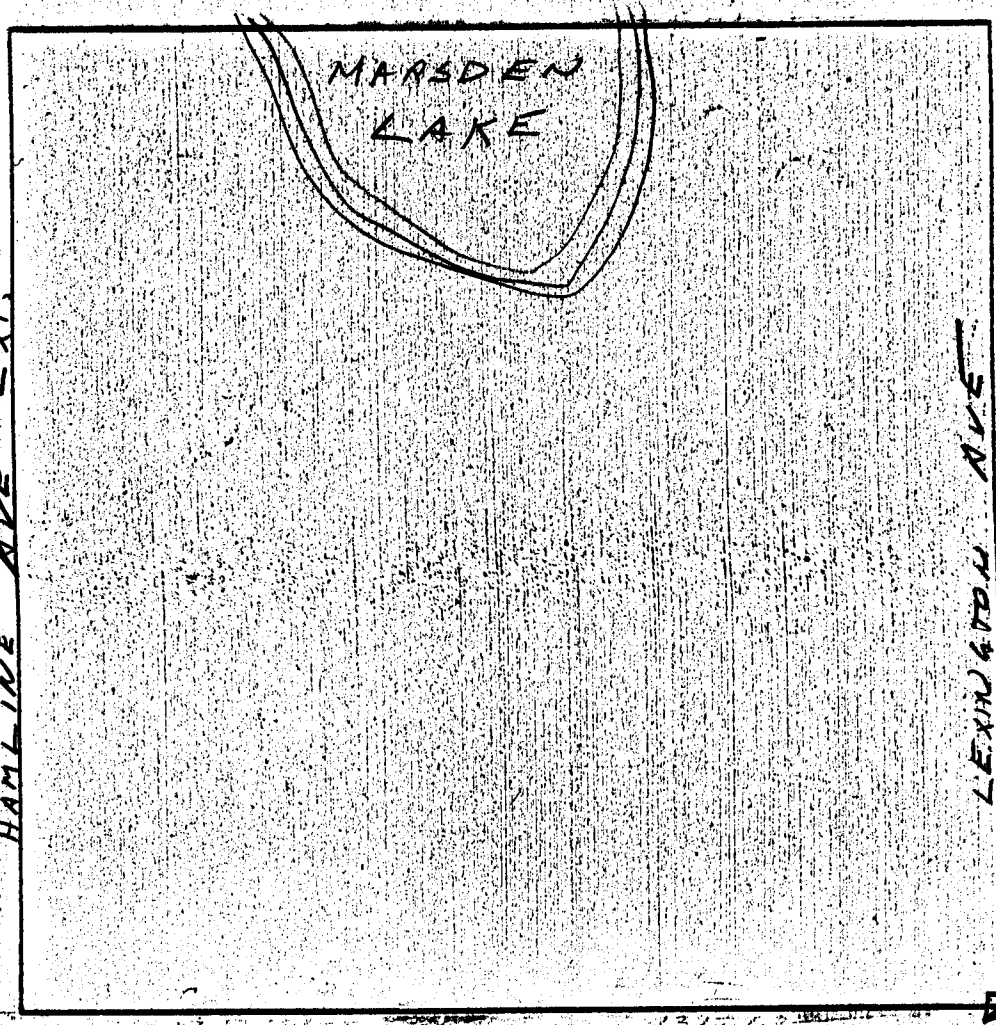

52.32
91.61
106.33
108.93
43.13
3N PP
3N GP
3N PP
3N PP