


SE 1/4, SEC. 15, TWP. 30, RGE. 23

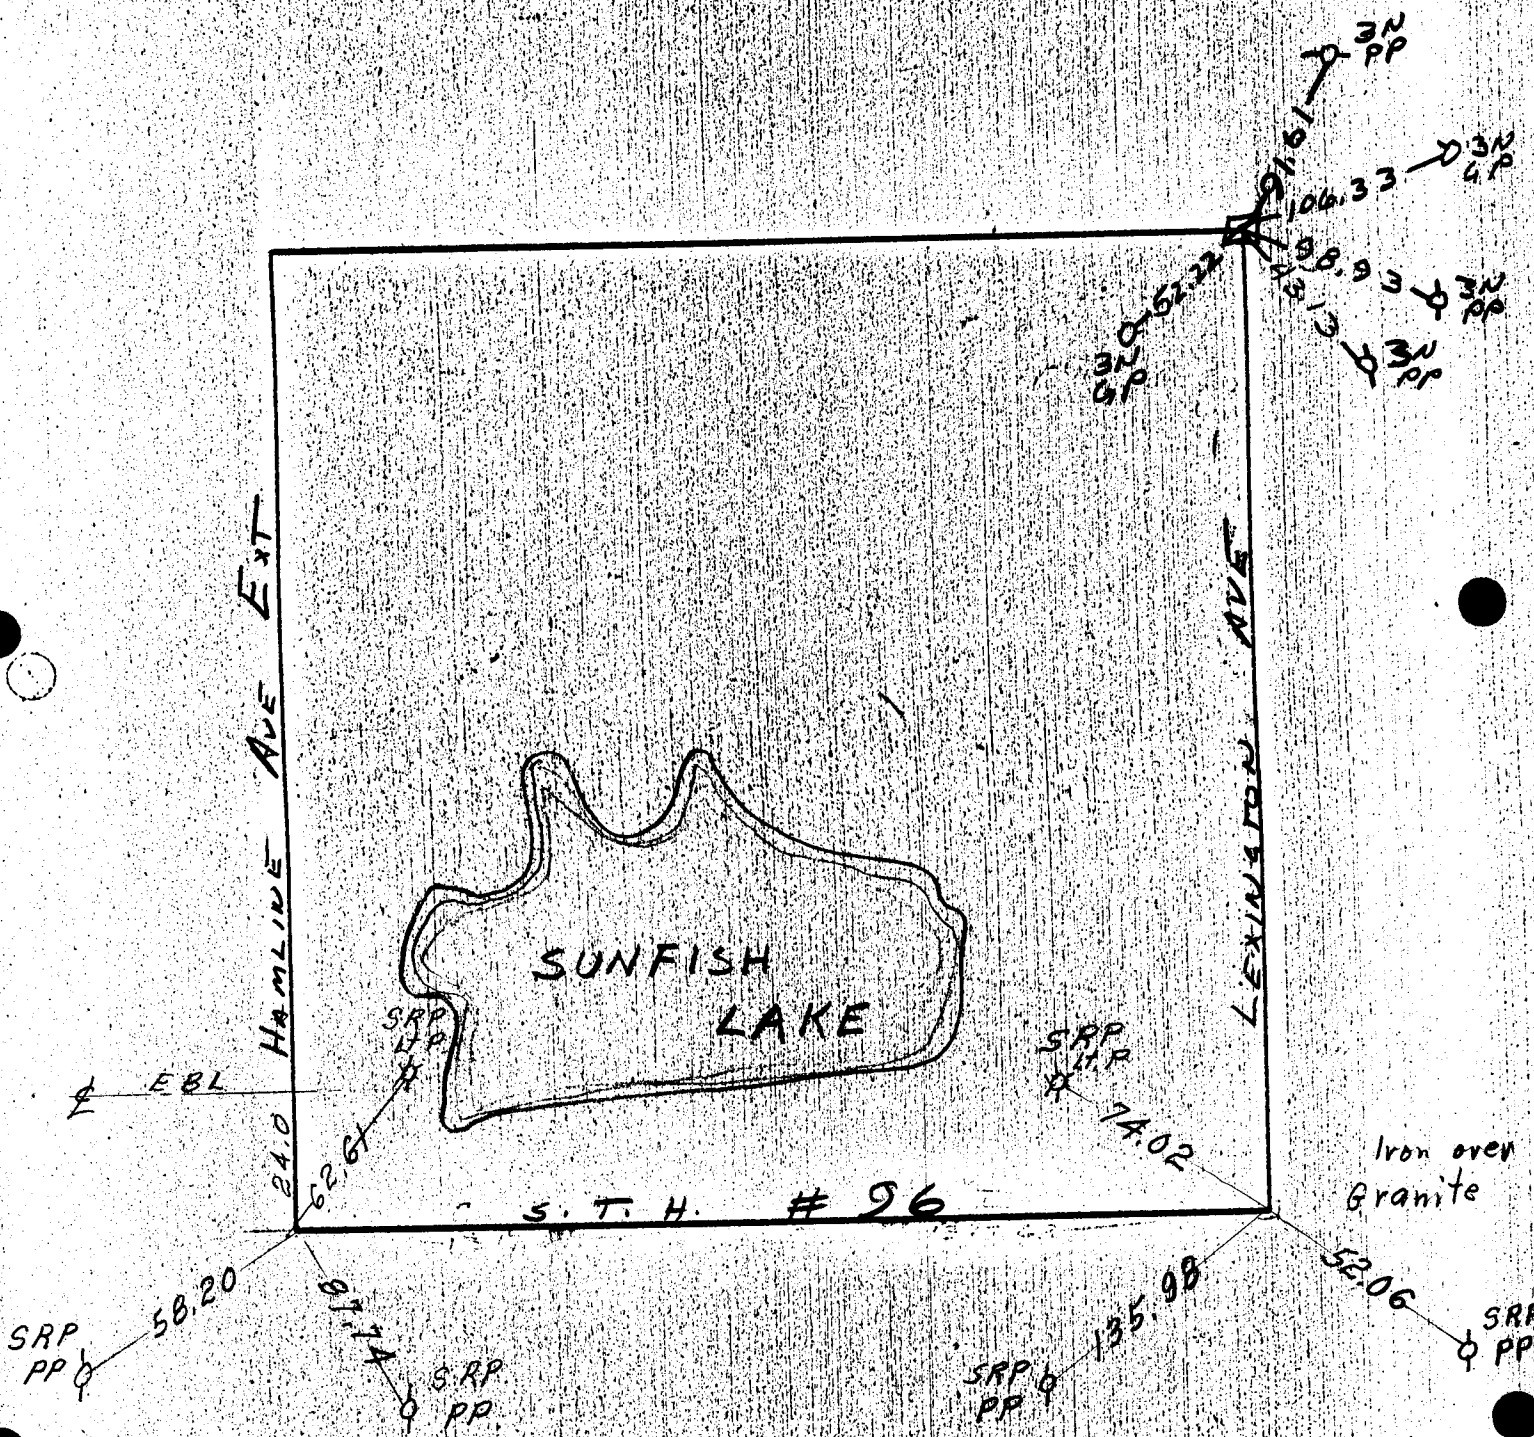

SUNFISH LAKE

24.0 Hamline Ave Ext

LEXINGTON AVE

S. T. H. # 96

Iron over Granite

EBL

91.61
106.33
81.93
81.61
3N PP
3N PP
3N PP
3N PP

SRP PP

SRP PP

SRP PP

SRP PP

SRP PP

SRP PP