


NE 1/4, SEC. 16, TWP. 30, RGE. 23

KETRE RIVER ROAD

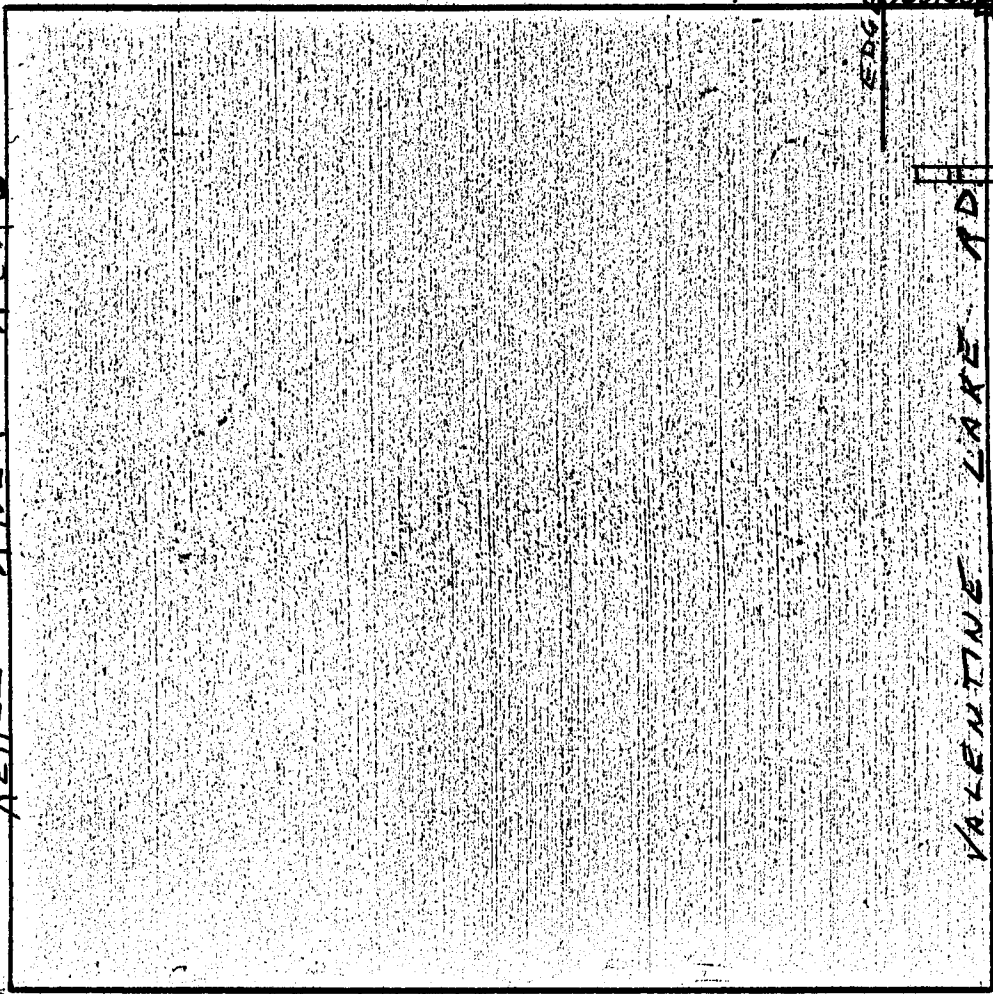

EDGE CON
PR MAIL
33.60
37.50
26.20
EDGE CON
PR MAIL

VALENTINE LAKE ADJ

137-6?