


SW 1/4, SEC. 20, TWP. 30, RGE. 23

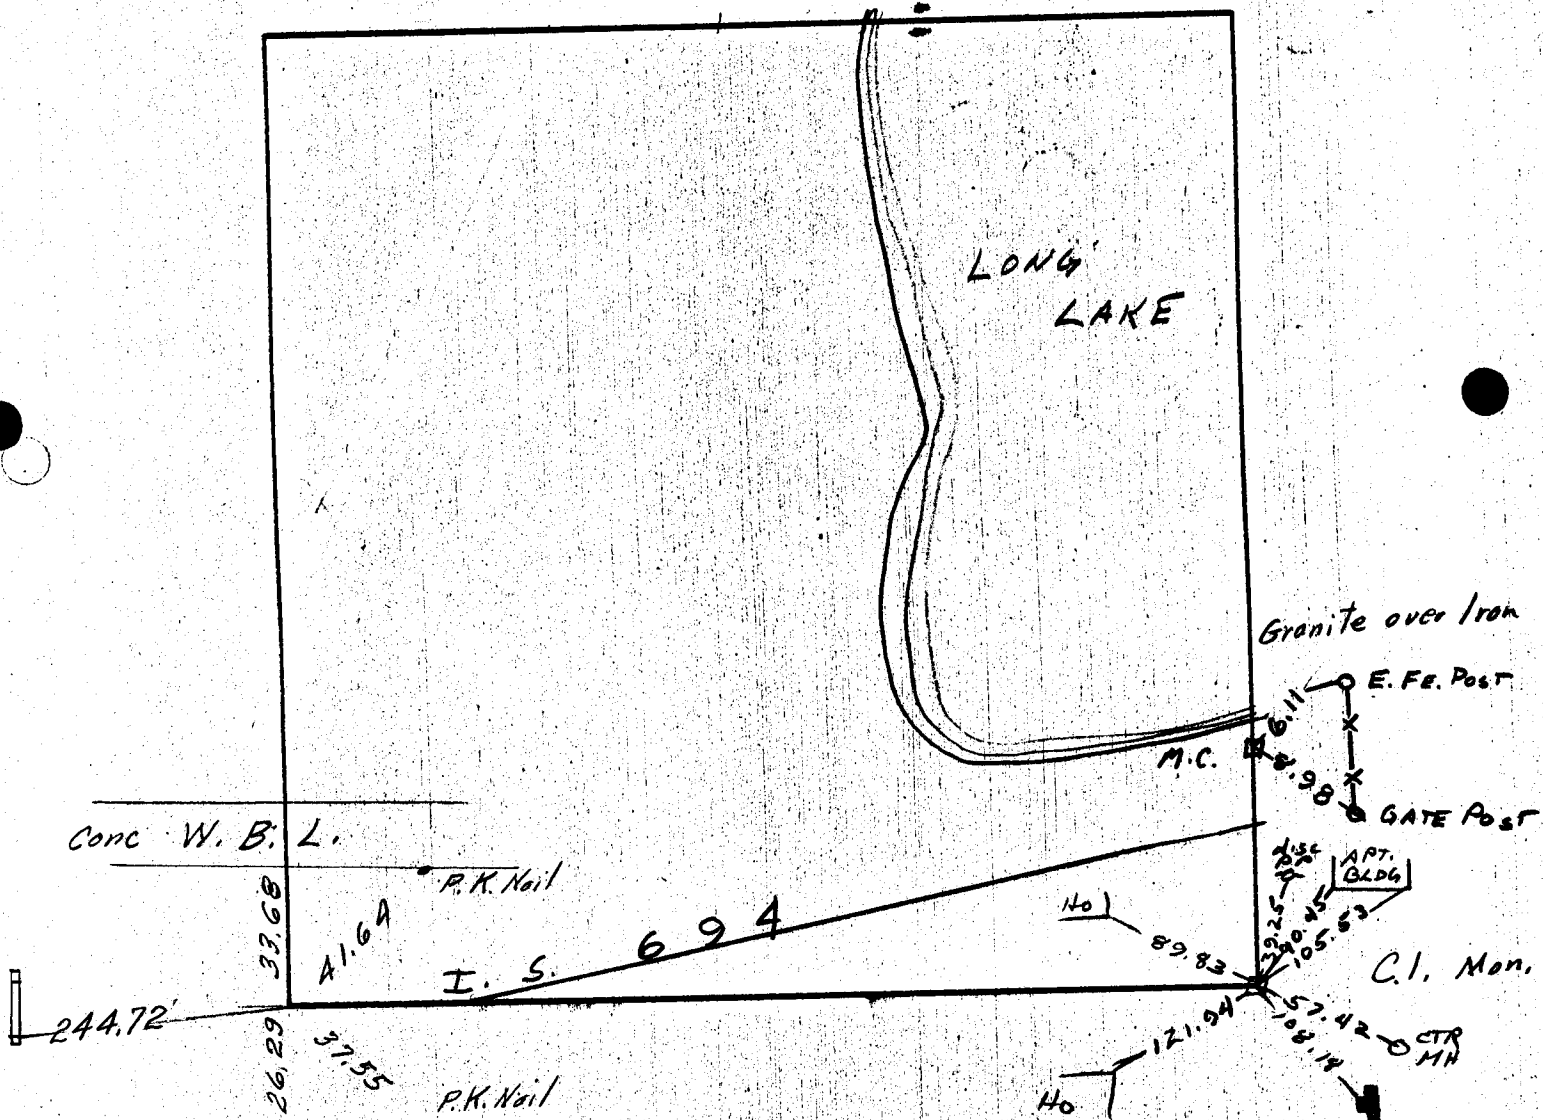

CONC E.B.L.

C.I. MON.