


SW 1/4, SEC. 21, TWP. 30, RGE. 23

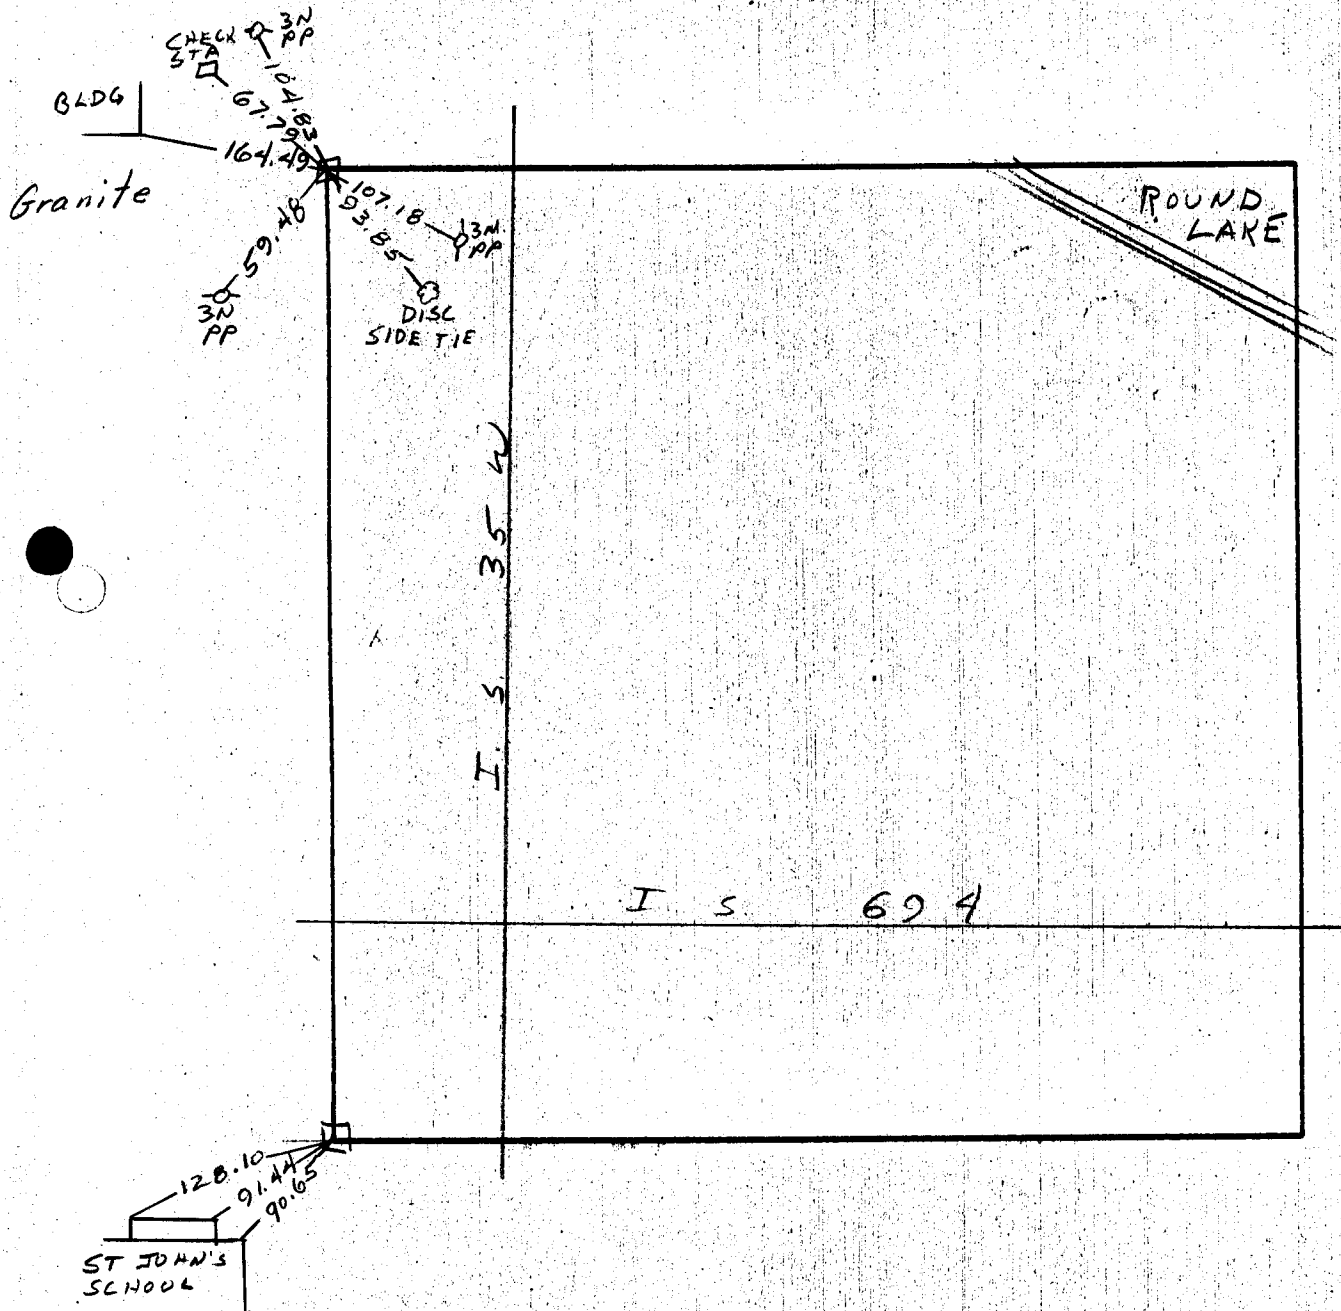

Found 3/4" Iron Pin
Punch Mark
10-28-64
Granite Buried Deep