


NE 1/4, SEC. 22, TWP. 30, RGE. 23

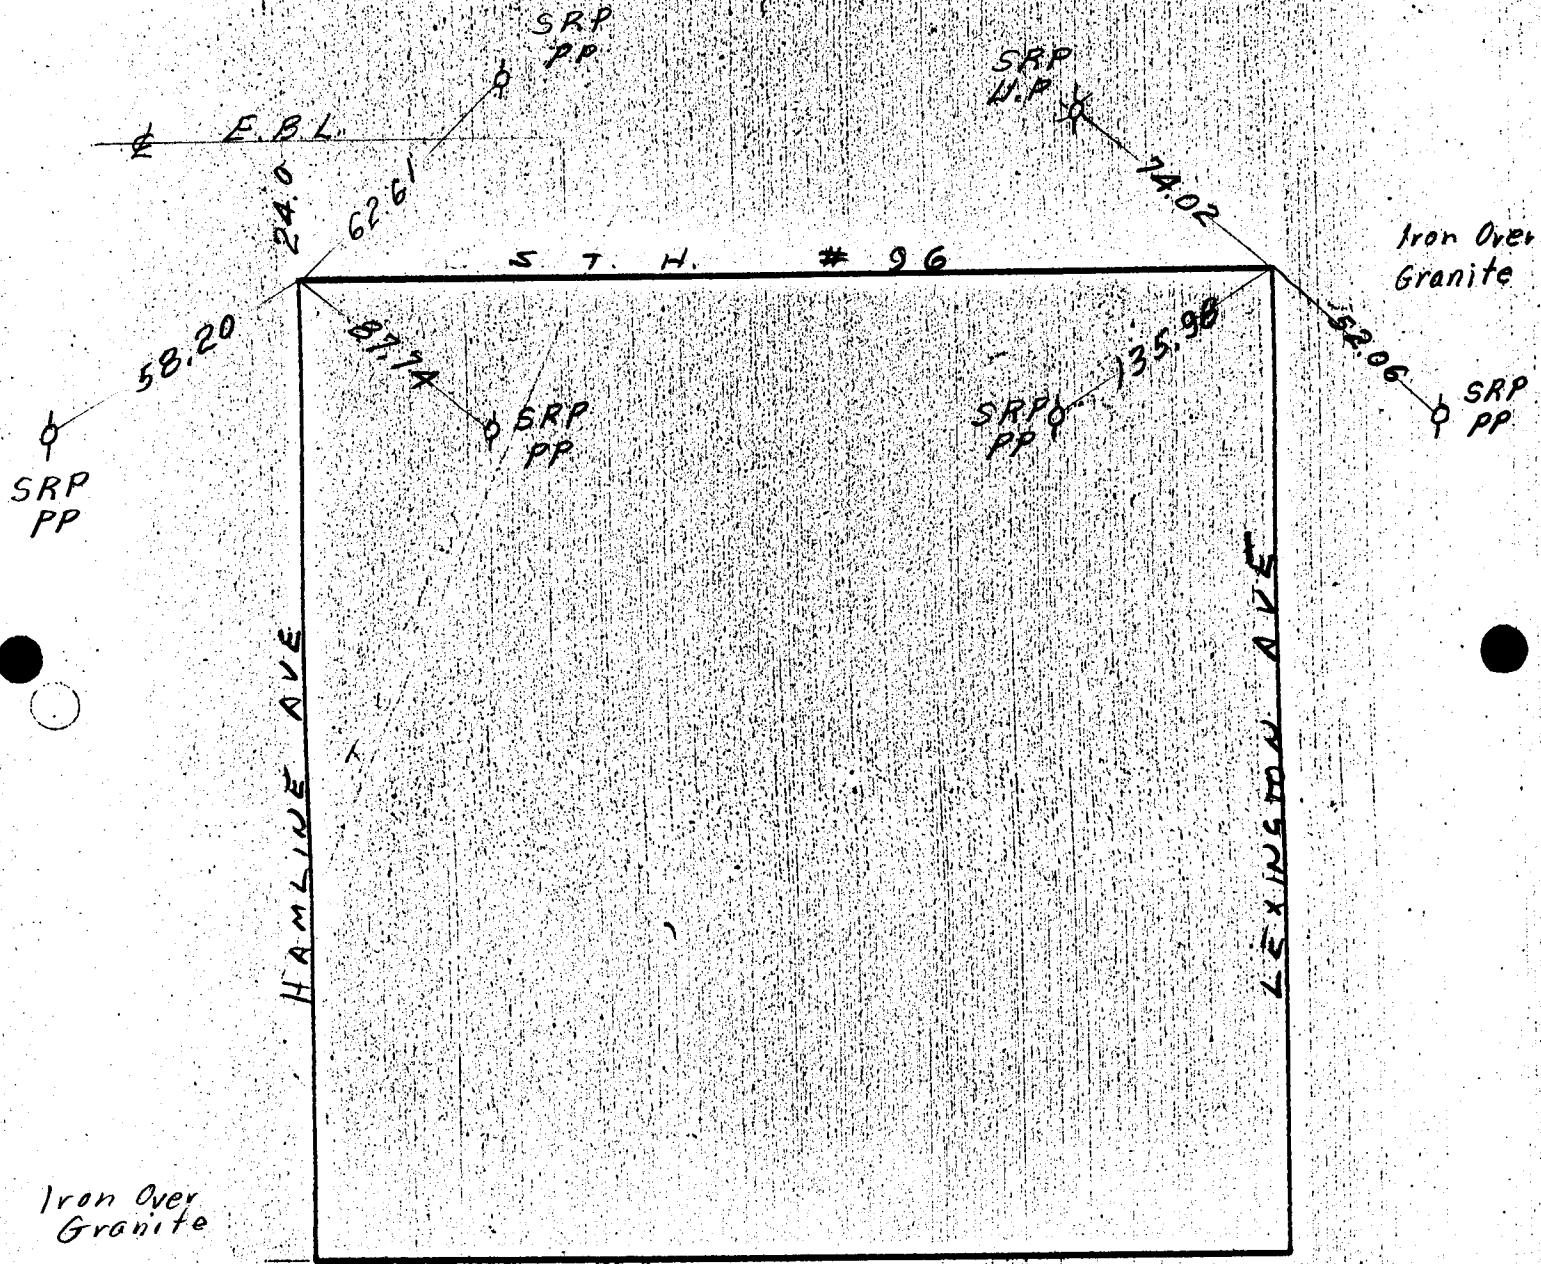

3N Side Tie PP

51.42

138.55

PP

102.85

Hyd