


SW 1/4, SEC. 22, TWP. 30, RGE. 23

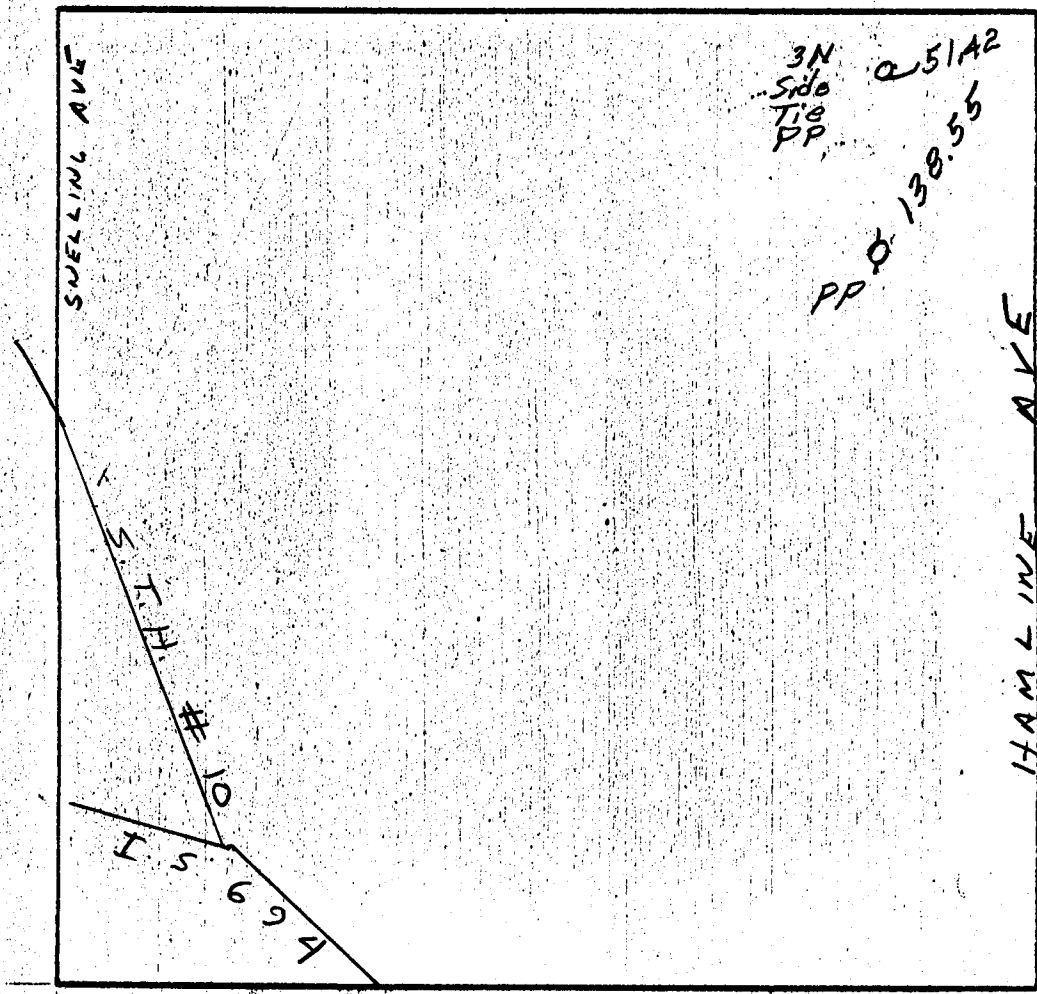

3N
Side
Tie
PP
Q 51A2
PP Q 138.55

Iron
over
Granite
102.85'
Hyd