


NE 1/4, SEC. 26, TWP. 30, RGE. 23

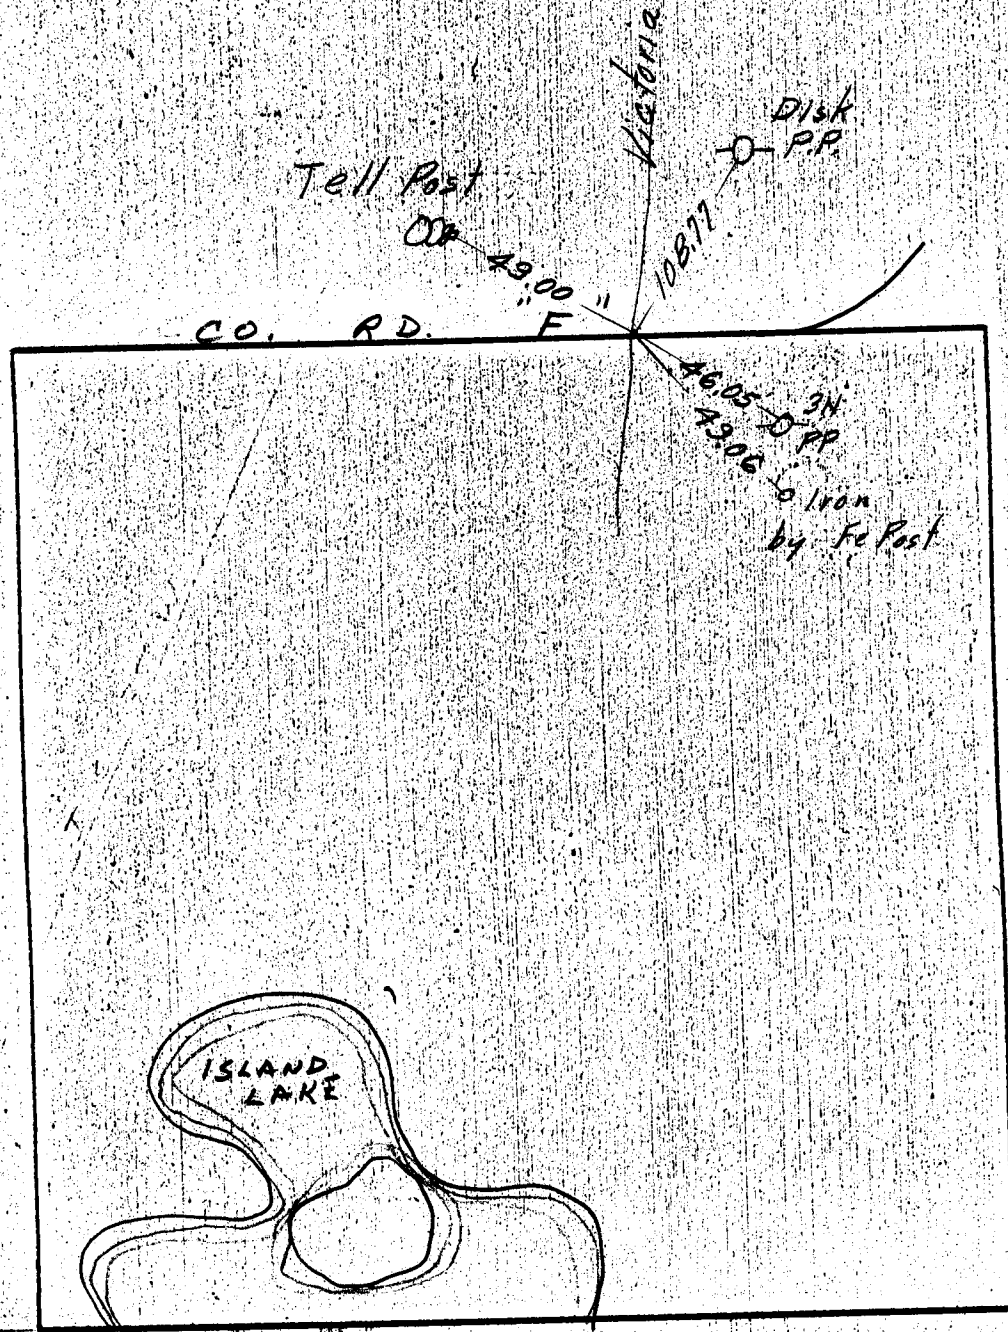

Tell Post

49.00 " F

CO. RD.

Victoria

Disk P.P.

108.77

3N  
46.05 Disk P.P.  
49.06 to Iron  
by Fe Post

ISLAND LAKE