


SE 1/4, SEC. 3, TWP. 30, RGE. 23

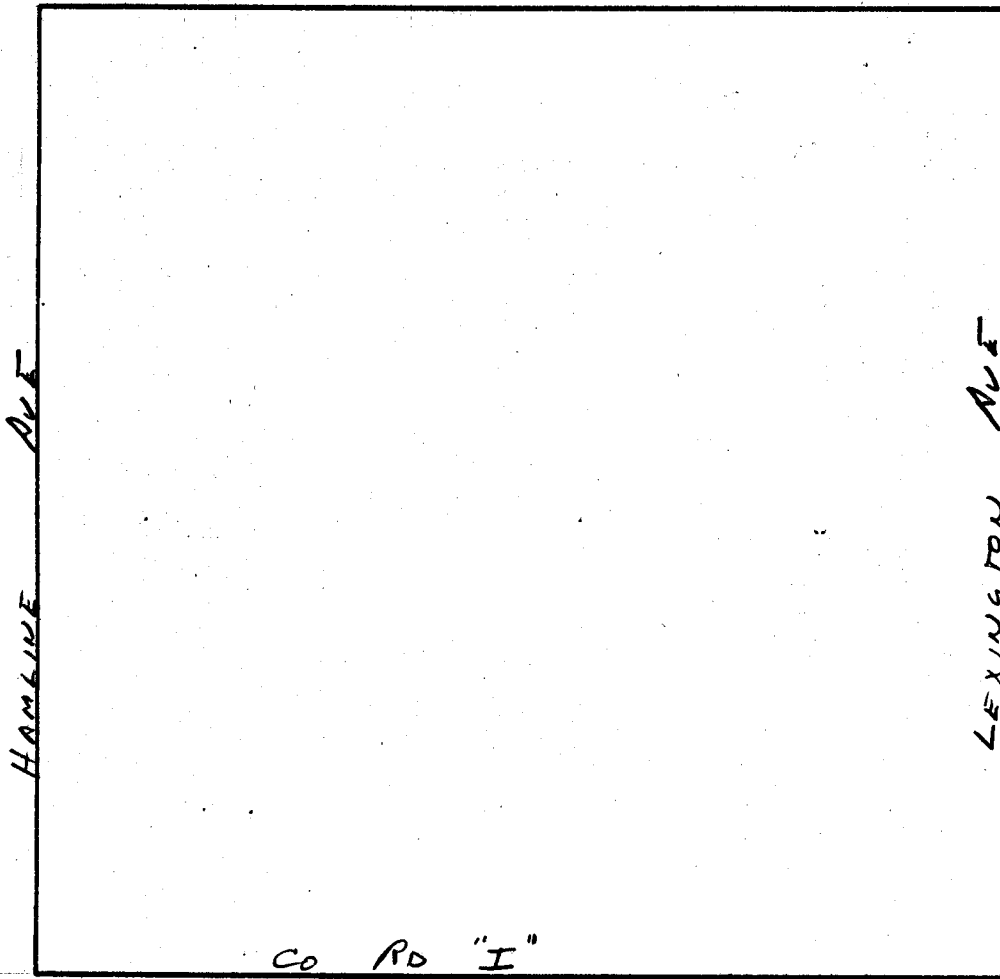

LEXINGTON AVE
2035.94-M