


NE 1/4, SEC. 30, TWP. 30, RGE. 23

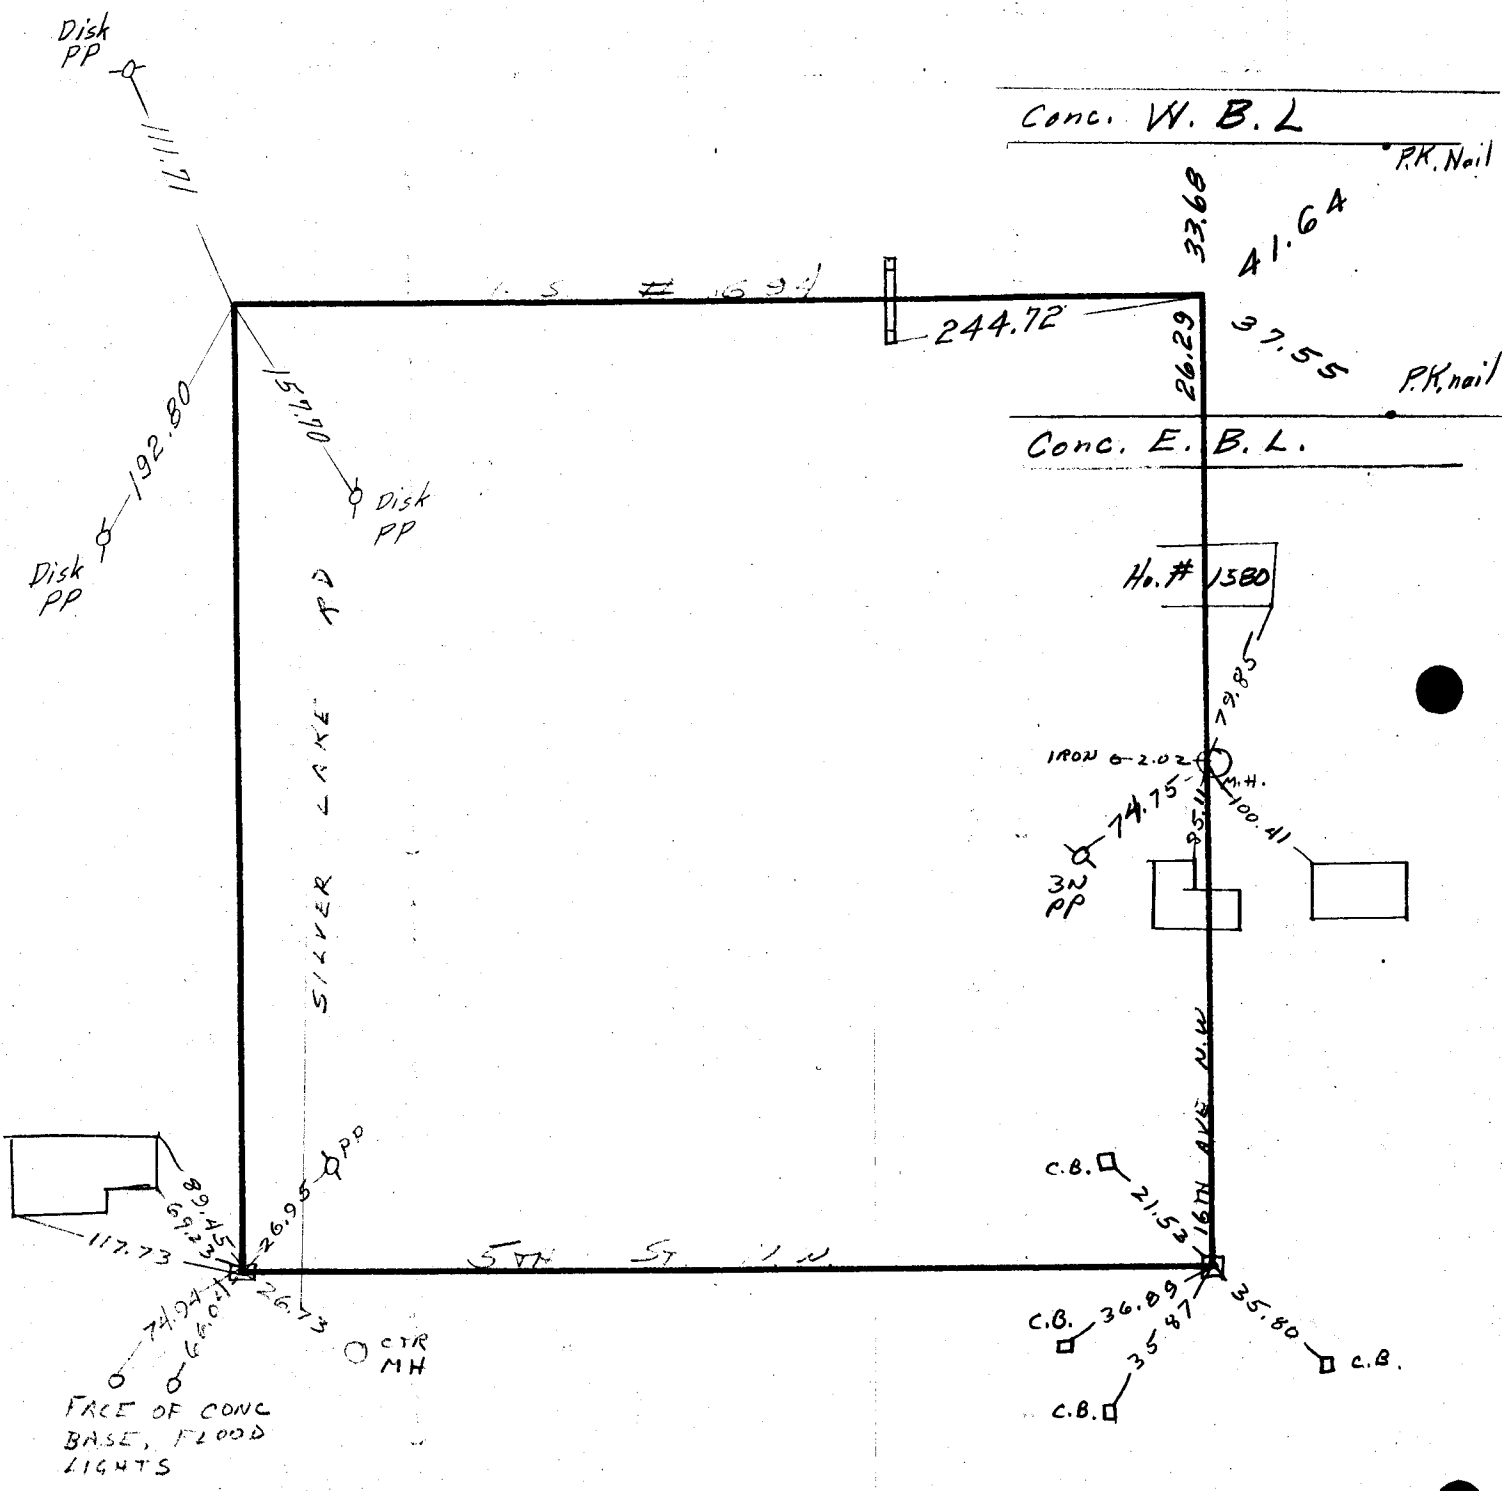

C. I. Mon