


NW 1/4, SEC. 31, TWP. 30, RGE. 23

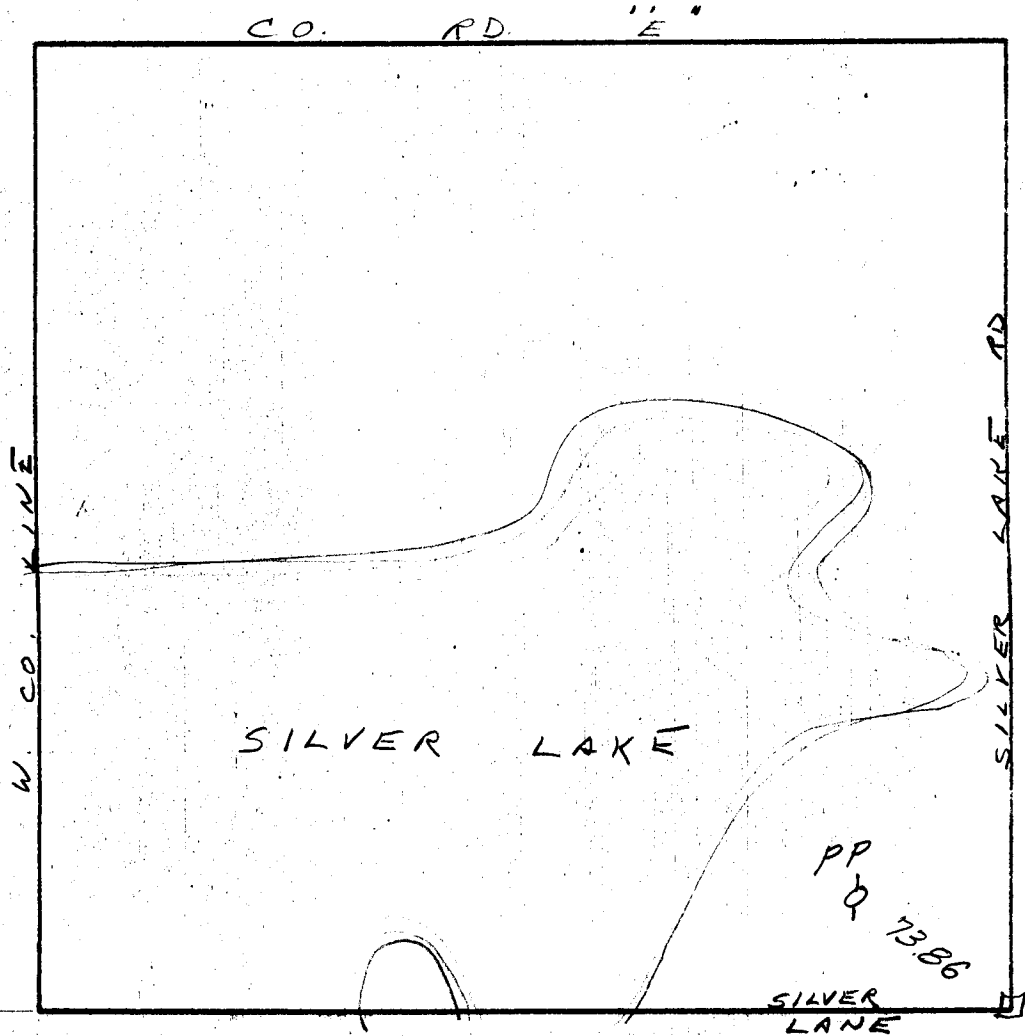

PP
O
52.90
58.7A Hyd

1975
Before Const
C.I. Mon.