


SW 1/4, SEC. 31, TWP. 30, RGE. 23

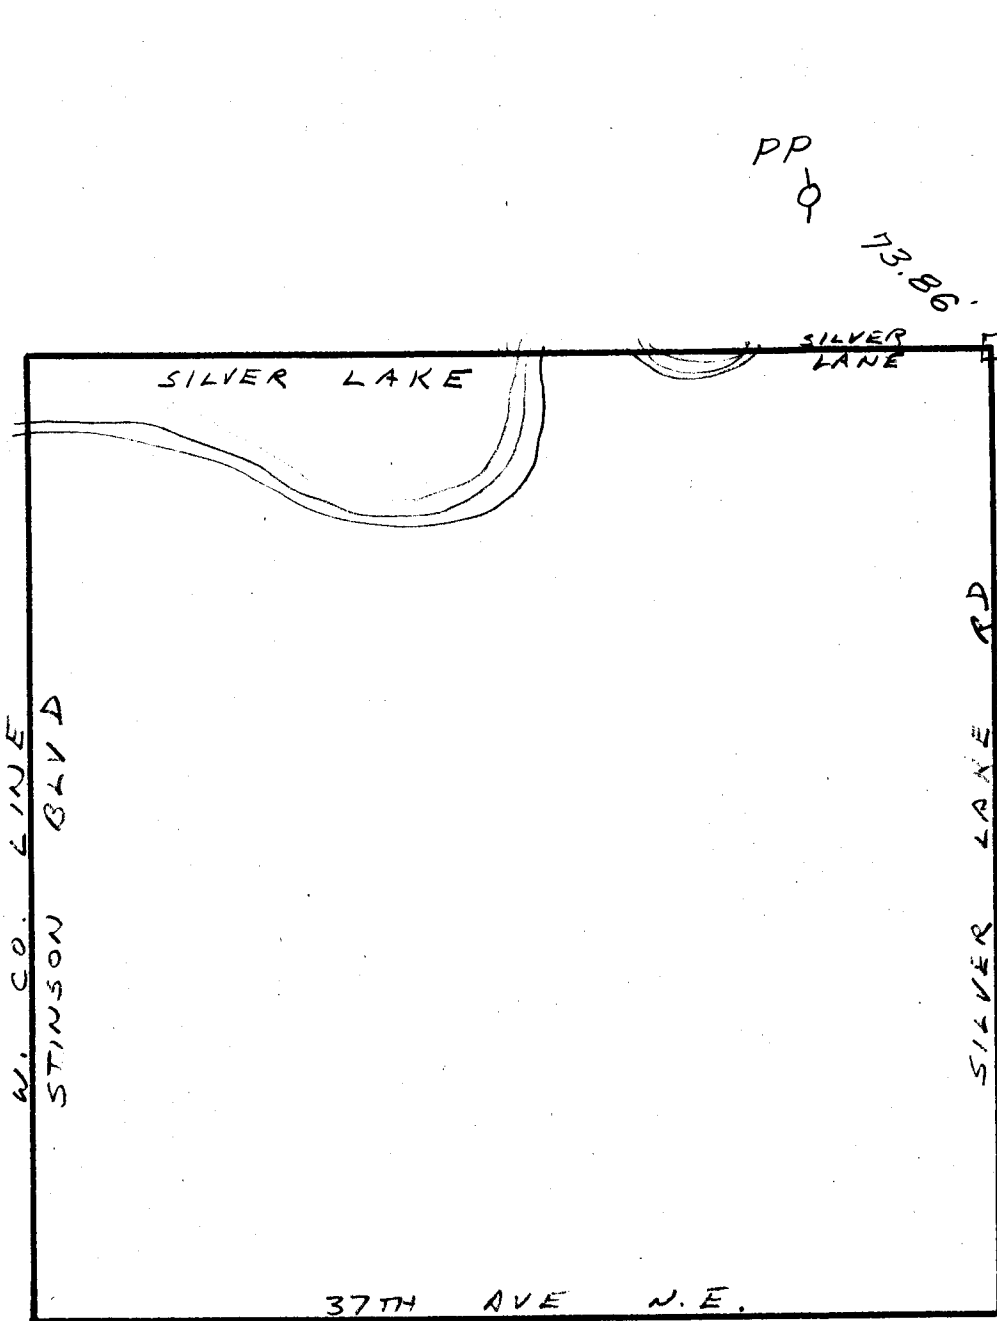

PP
PP
52.90
58.74
1975
Before Const.