


NW 1/4, SEC. 36, TWP. 30, RGE. 23

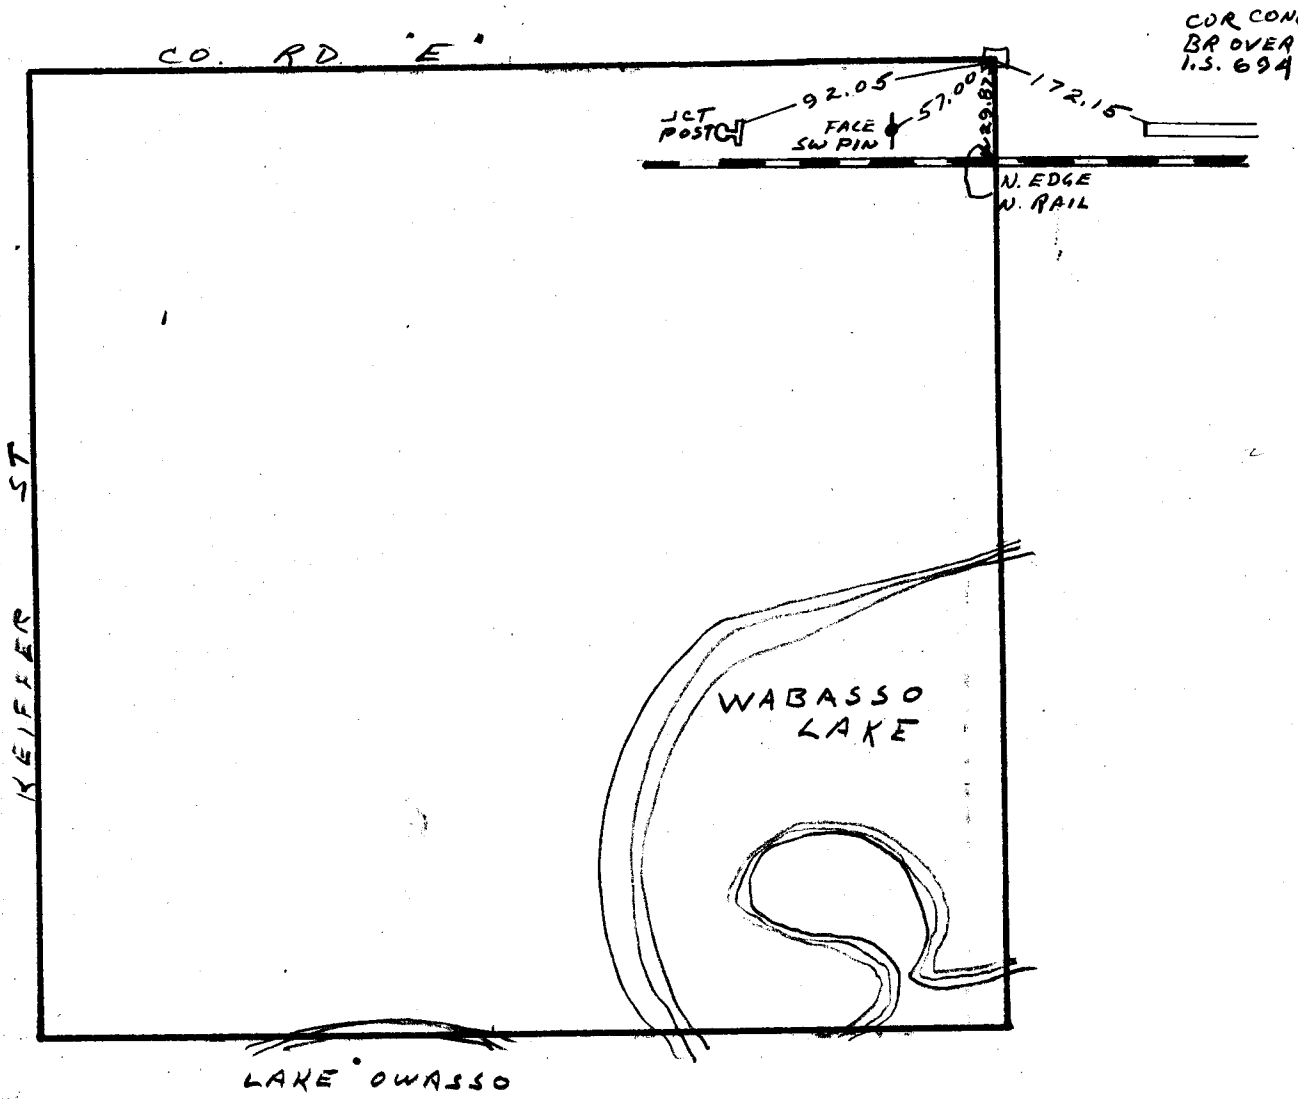

COR CONC
BR OVER
I.S. 694

KEIFER ST

CO. RD. 'E'

JCT POST

FACE SW PIN

N. EDGE N. RAIL

WABASSO LAKE

LAKE OWASSO