


NW 1/4, SEC. 4, TWP. 30, RGE. 23

Y

Anoka Co. C.I. Mon.
11+65.73

3N
0 Fe Post

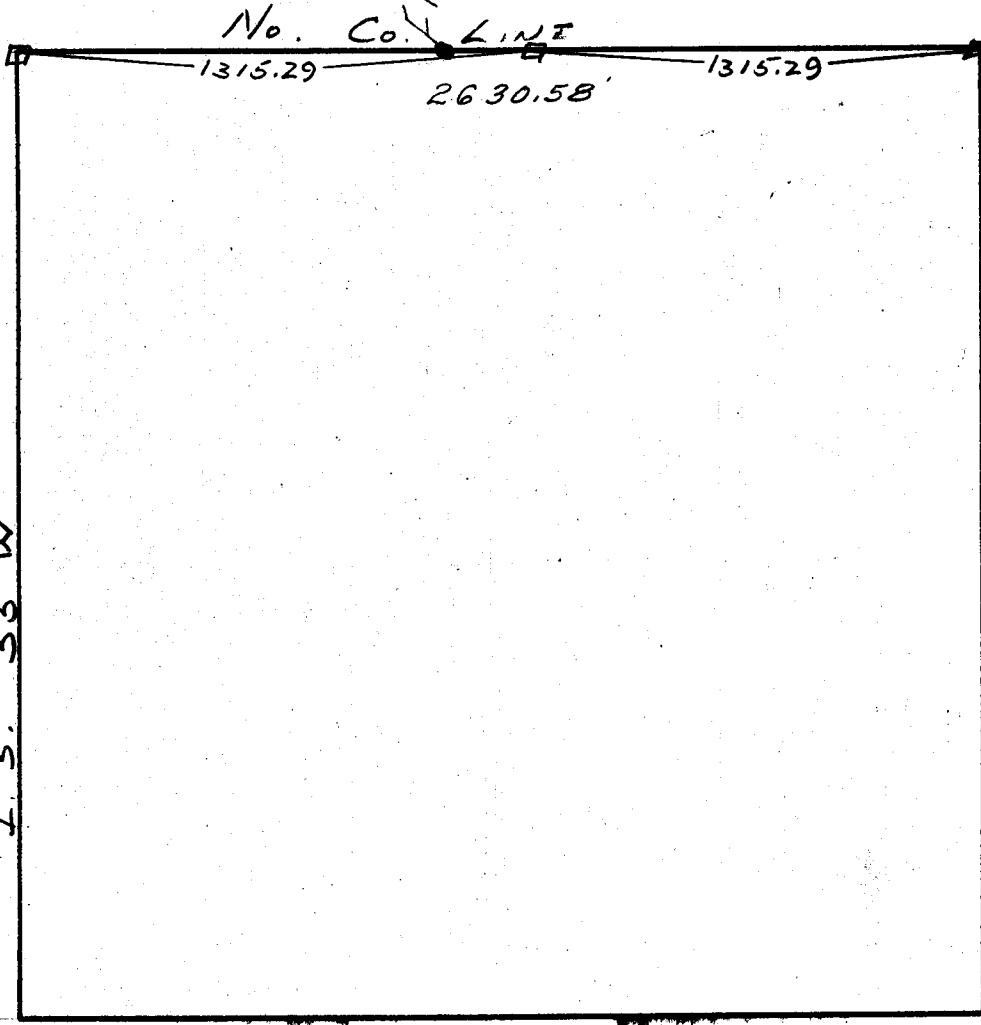

Iron over
Granite

3N
0 Lone
Fe Post