


SECTION 17, T. 30, R. 23.

8

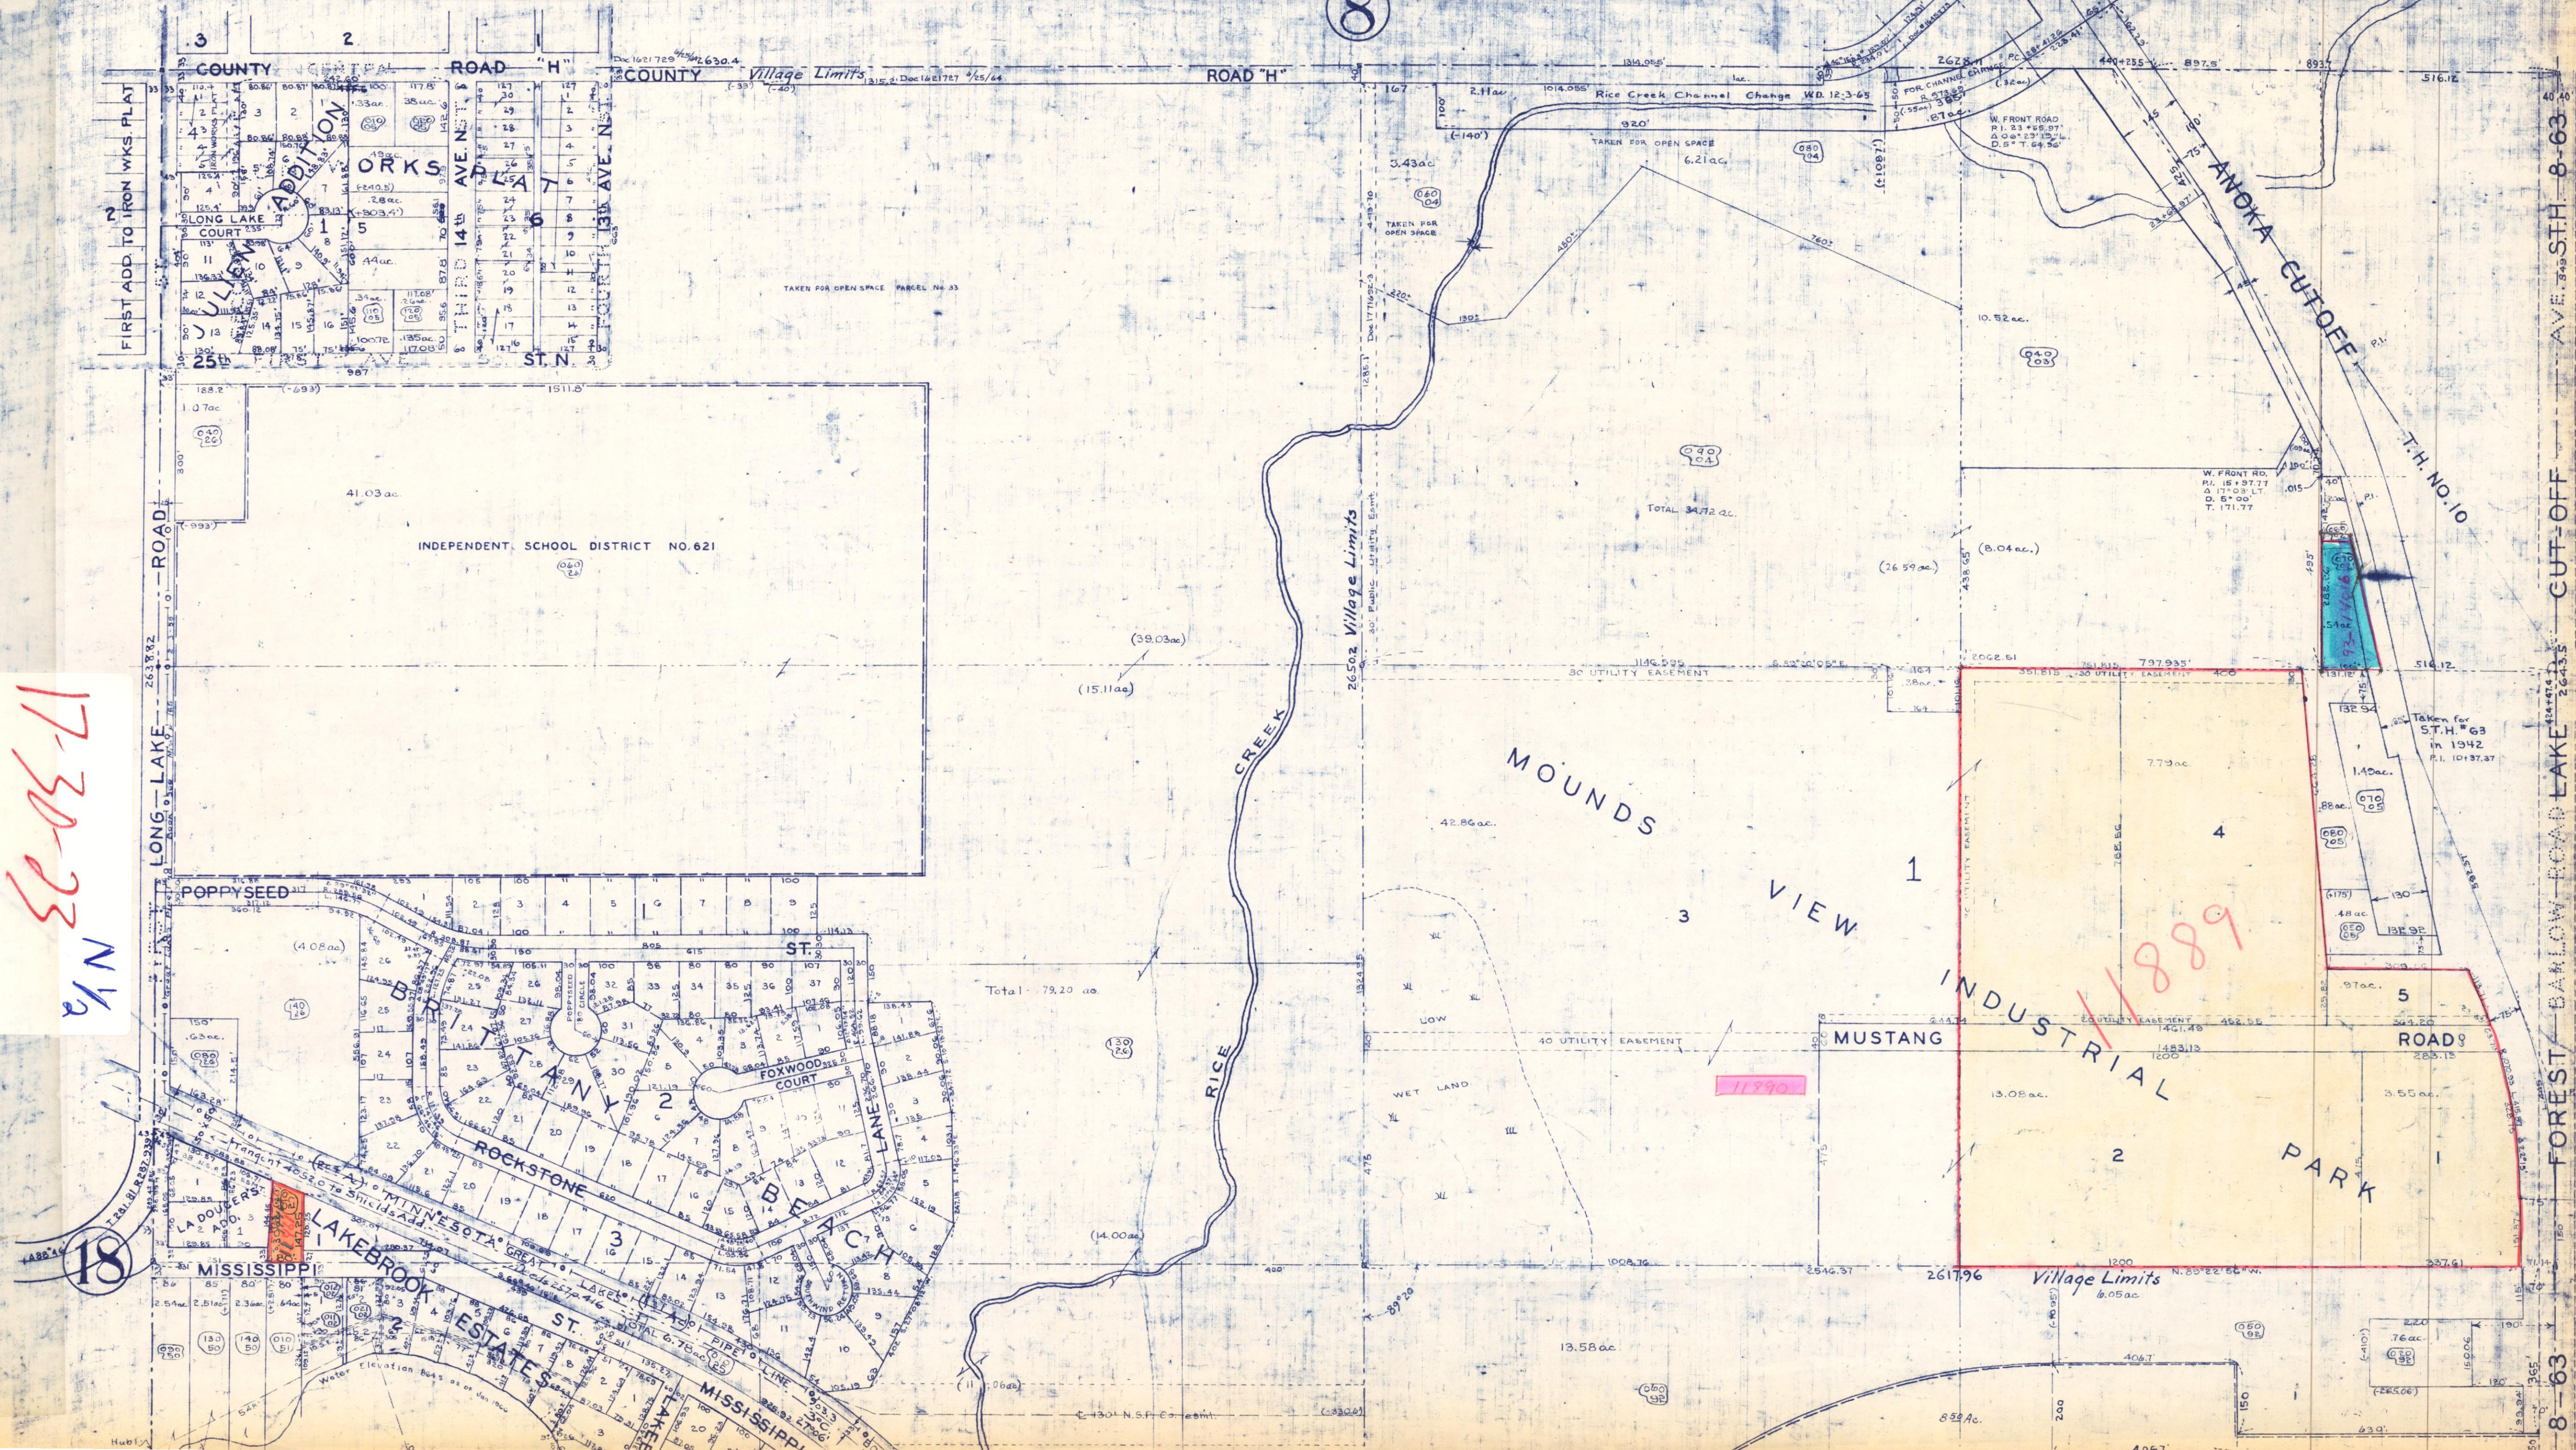

17-30-23
N 1/2

18

8-63
FOREST BARKO ROAD LAKE CUT-OFF AVE. S.H. 8-63