


# N 1/2 SEC. 2 T.29 R.22

NOT RESPONSIBLE FOR ANY INACCURACIES HEREIN CONTAINED.

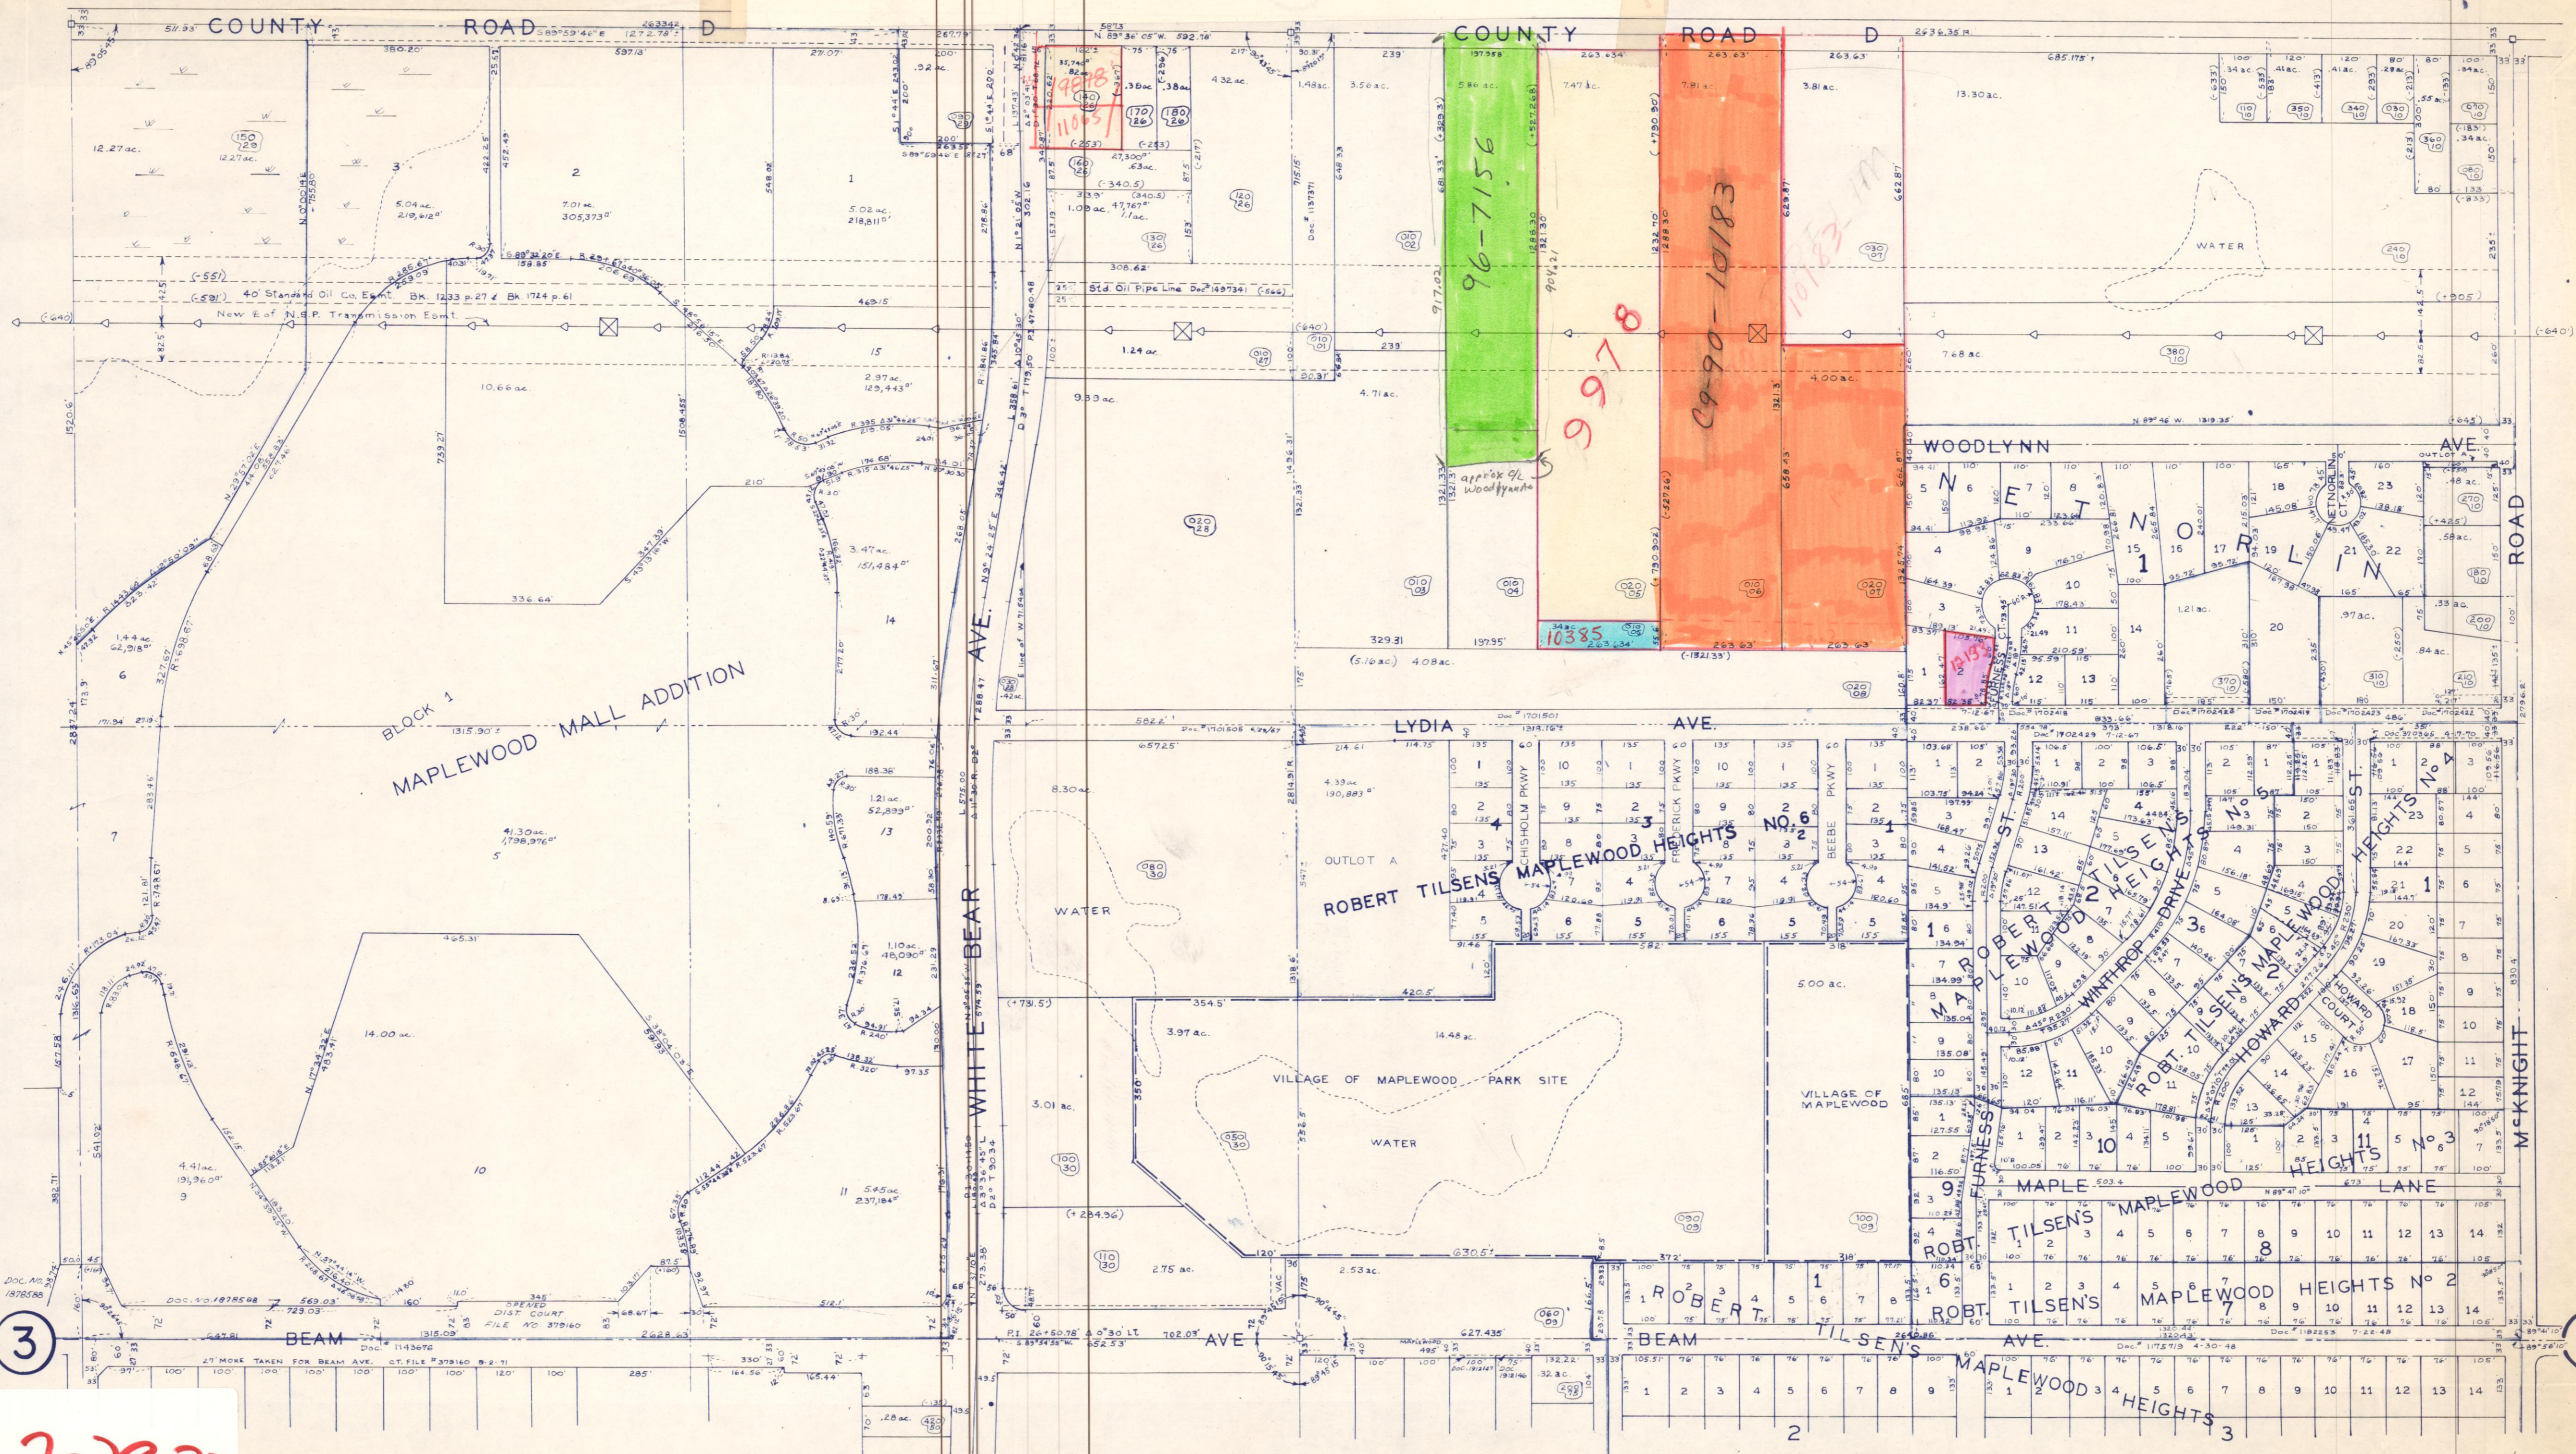

N 1/2 2-29-22