(2-16-00)
Prelim: W 133 ft N1/2 NE1/4 NE1/4 NE1/4 lying South of North 318.00 feet

SECTION 21 : T. 29 : R. 23

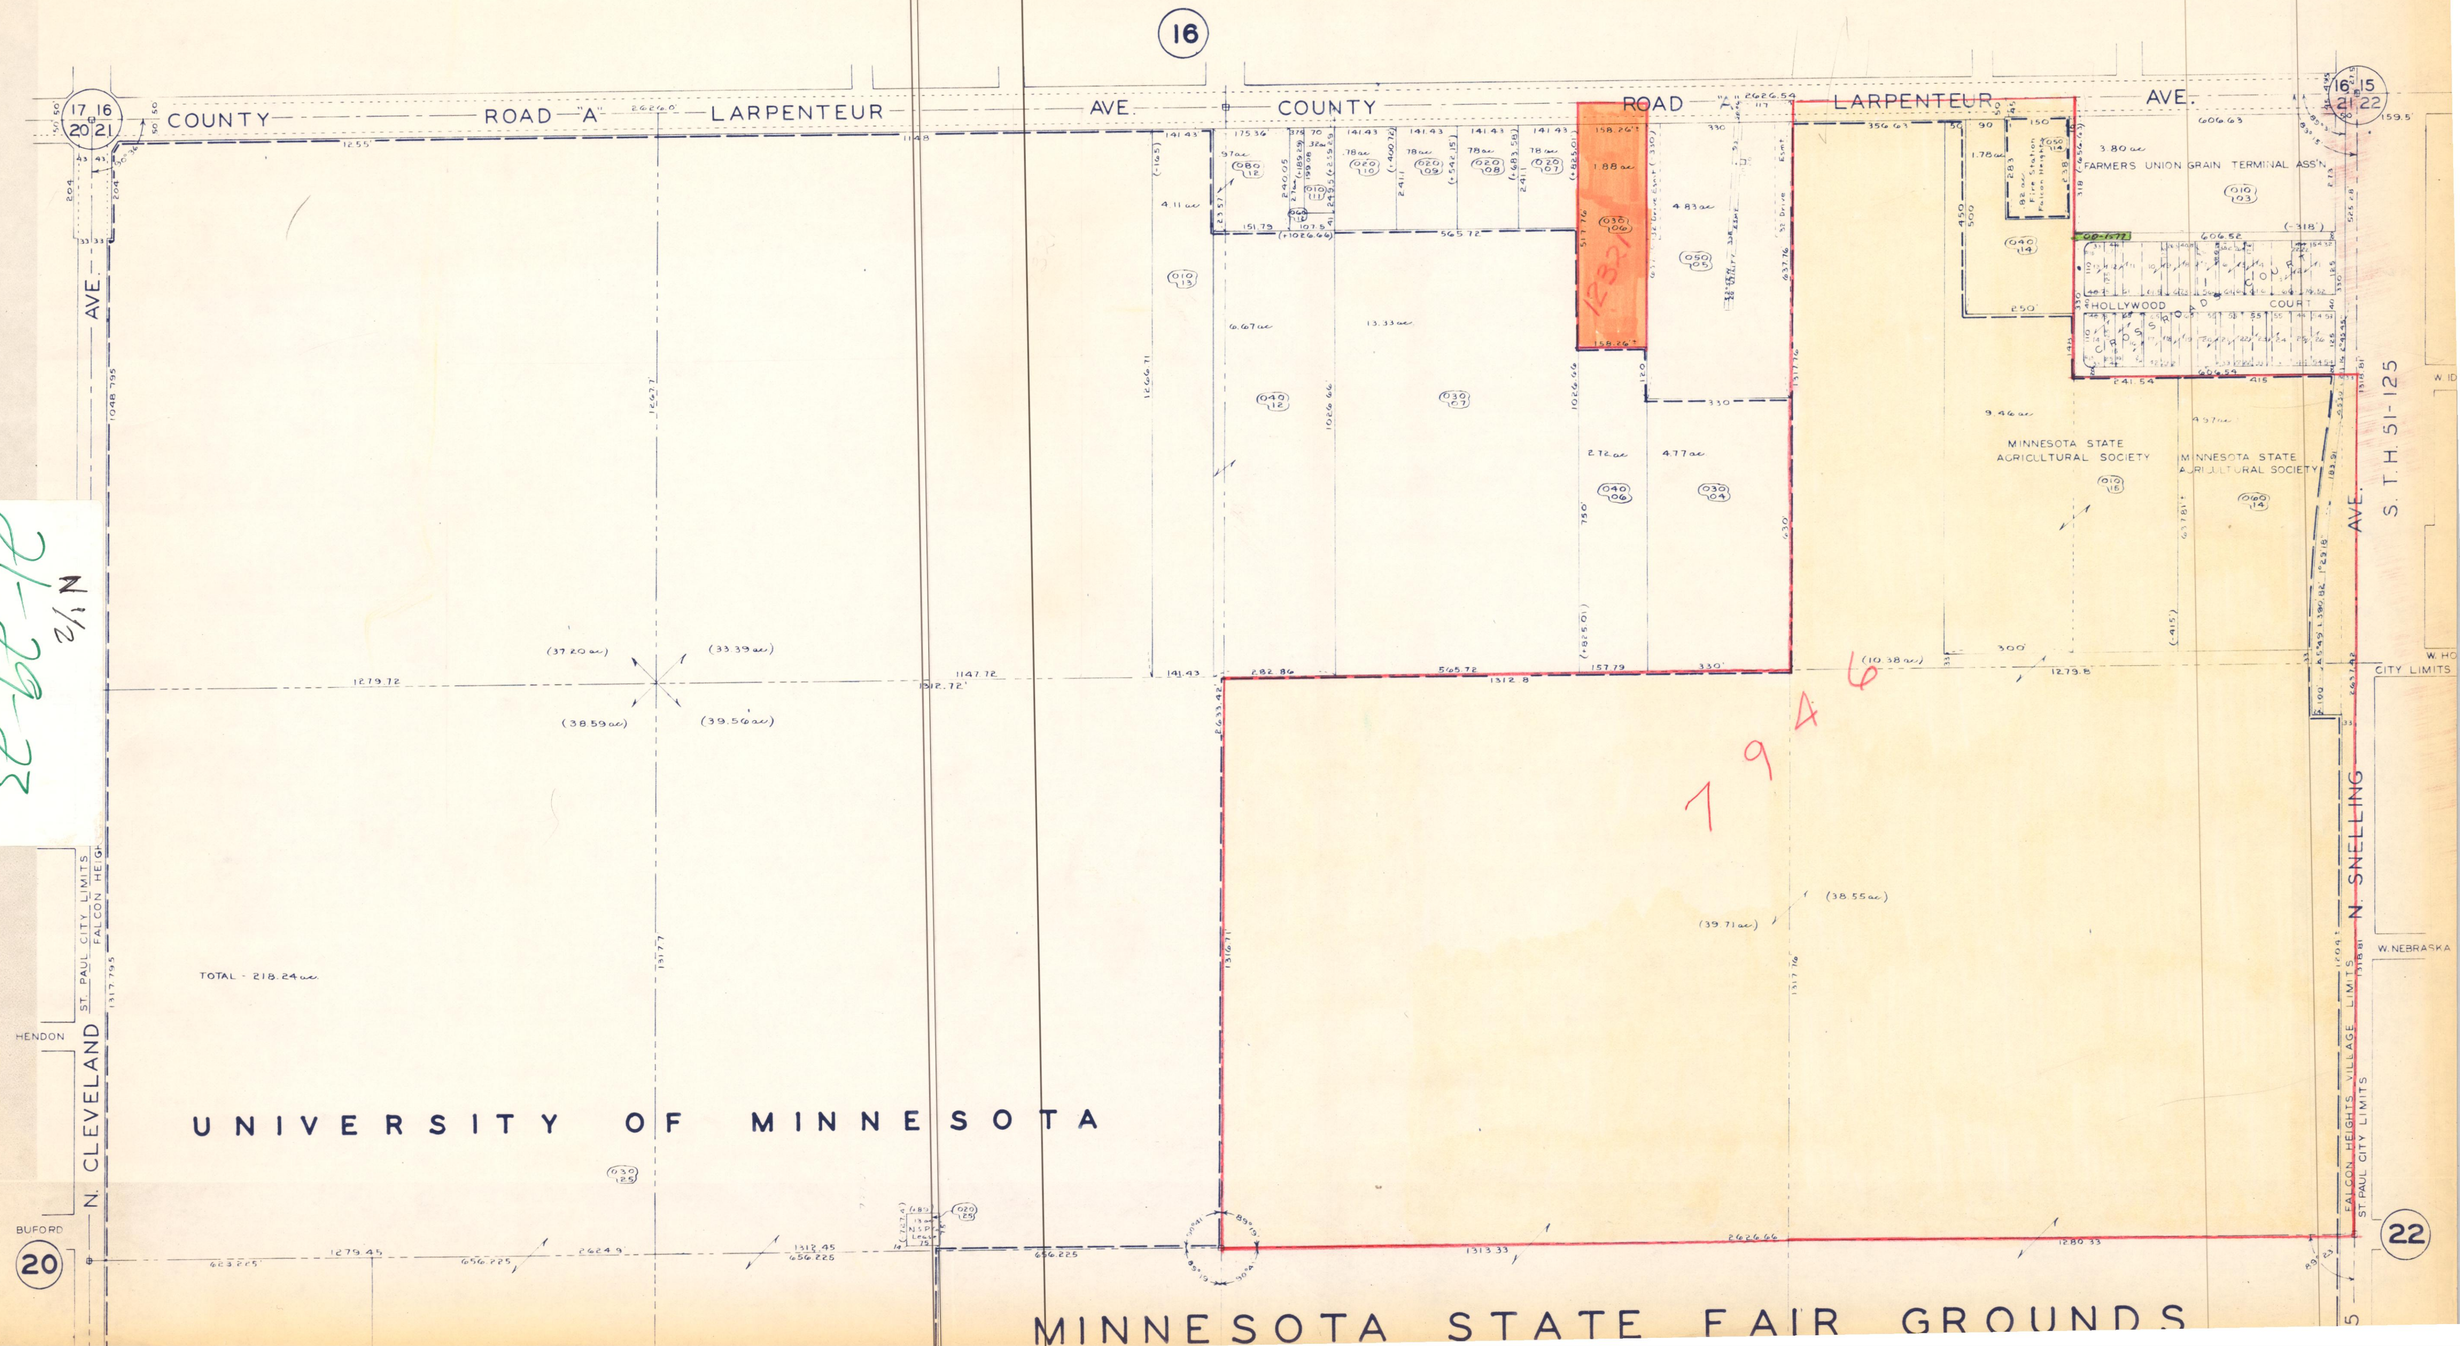

SE-bl-1 2/1 N