


SECTION 21, T.30, R.22.

16

21-30-22
N 1/4

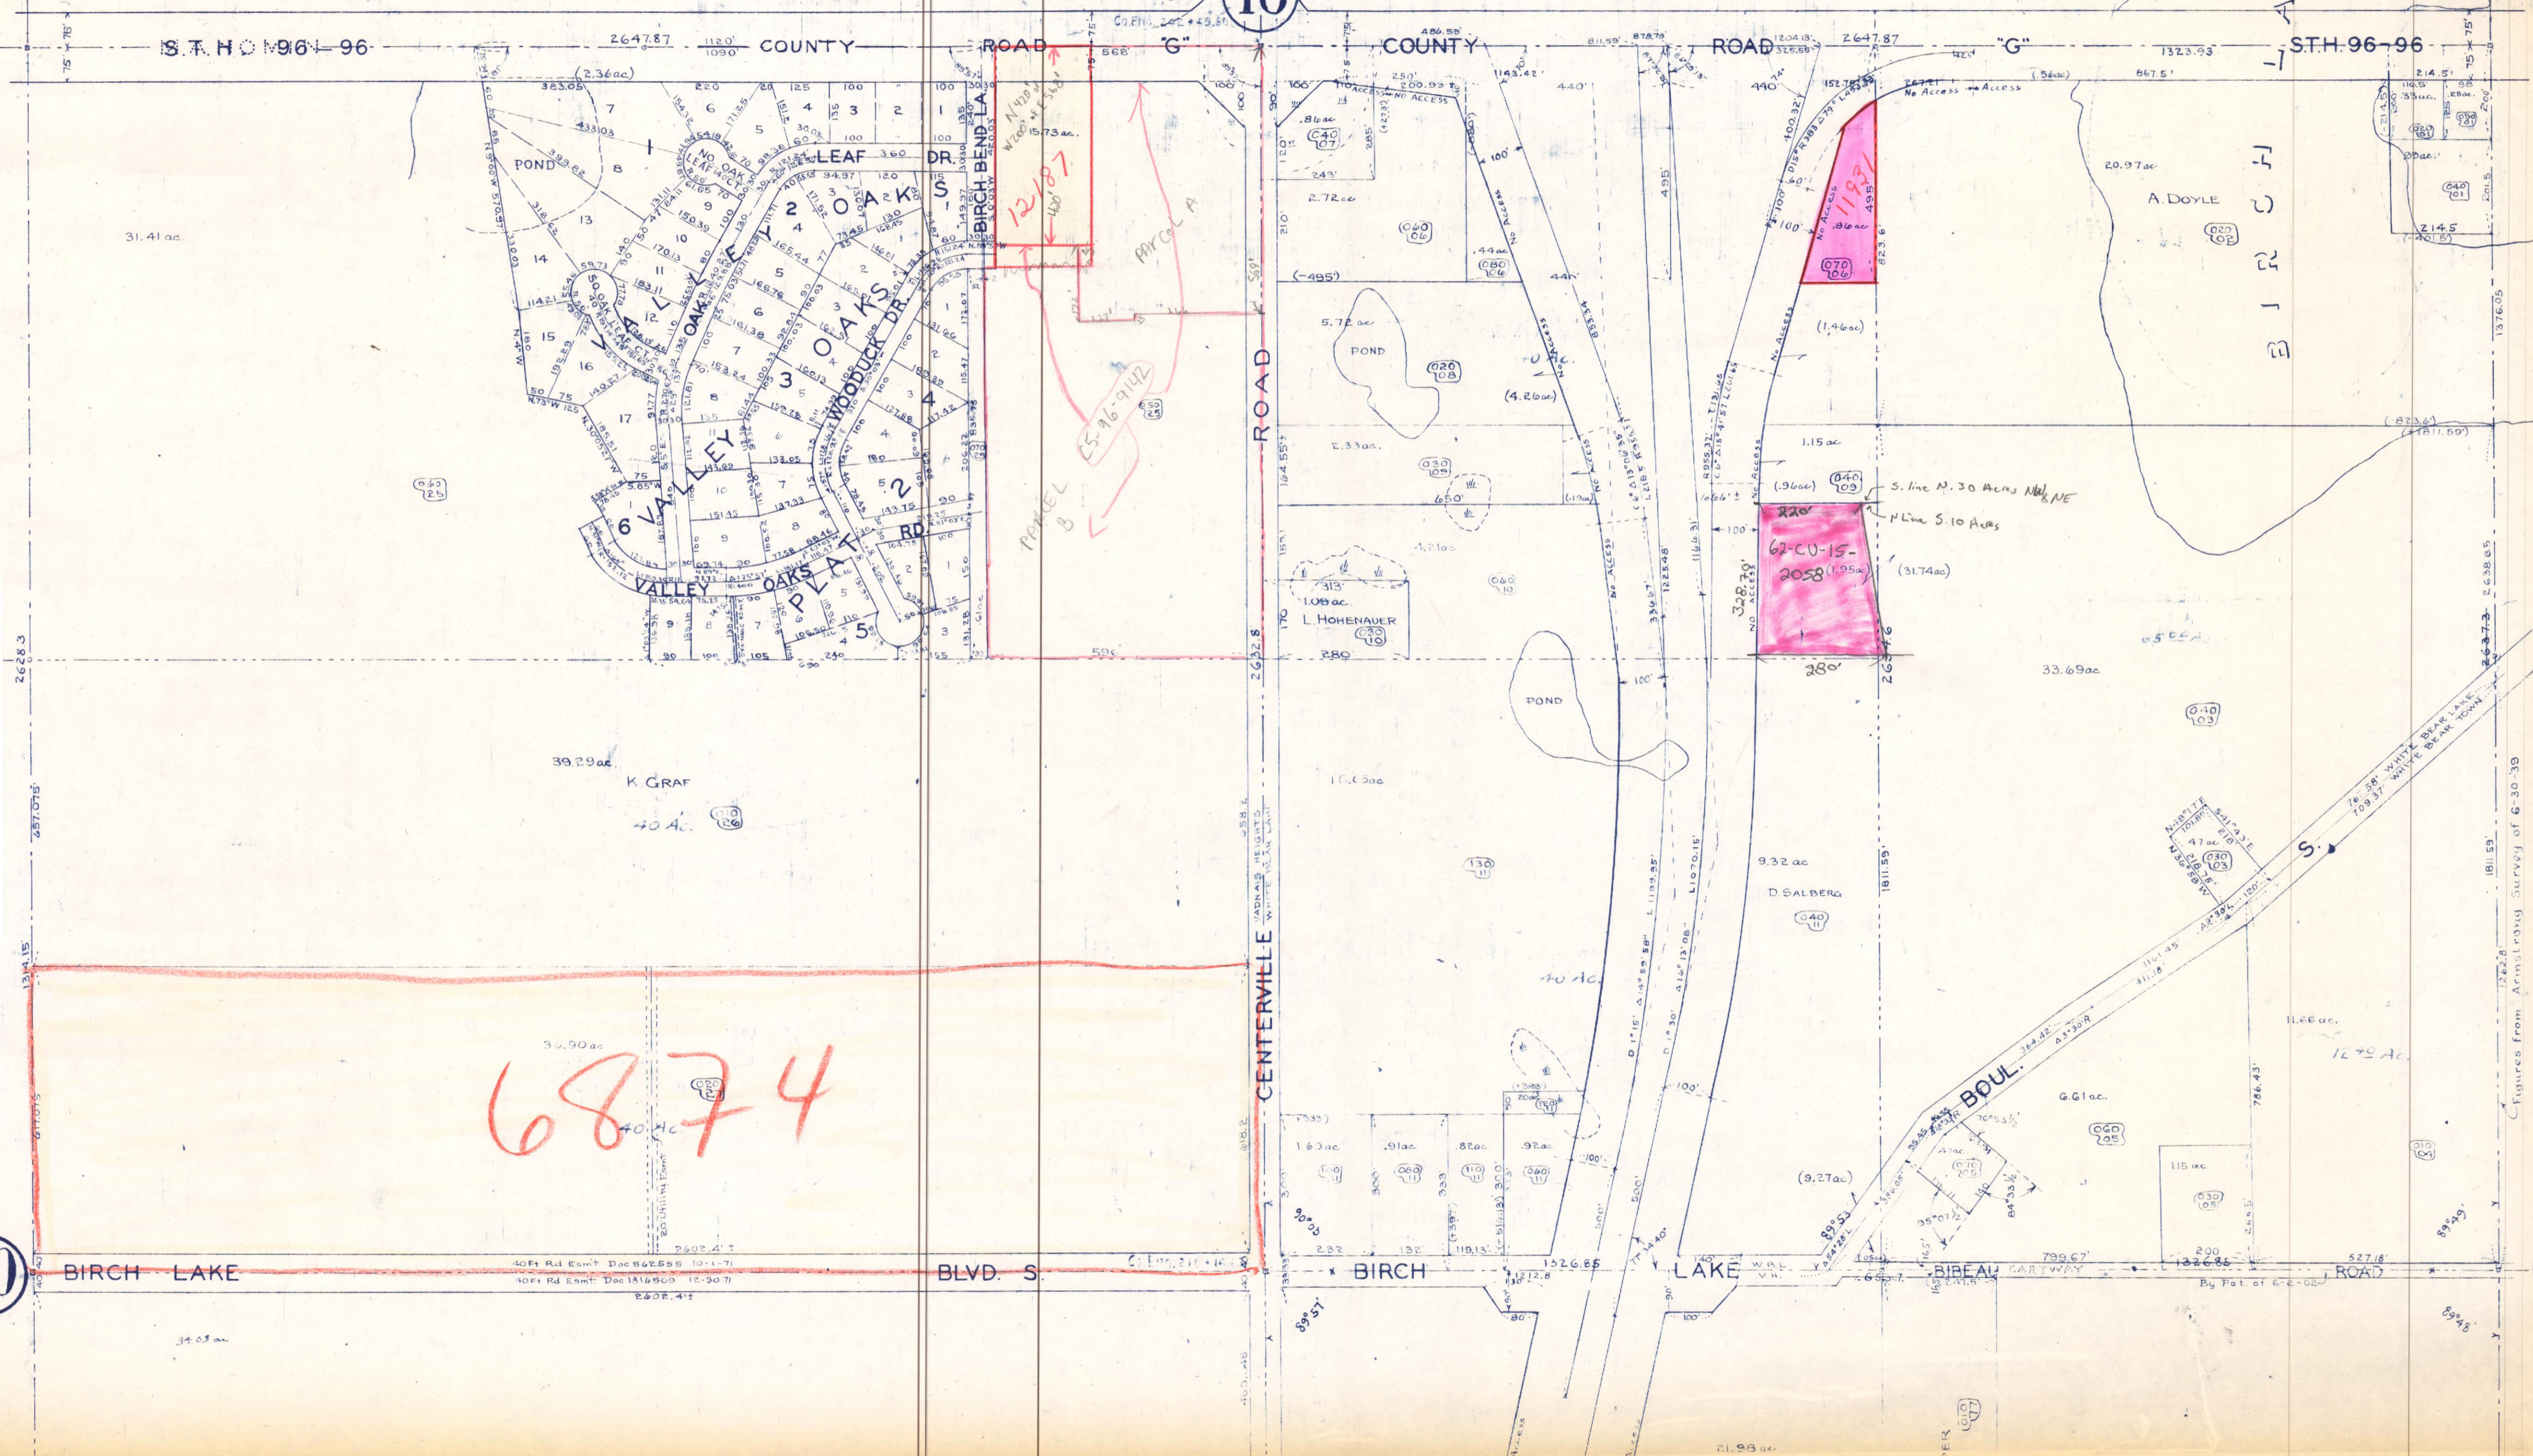

20

2

Figures from Armstrong Survey of 6-30-39