


# SECTION 25. T.29. R.22

24

25-29-22 NW

WARD 2  
MAP 87

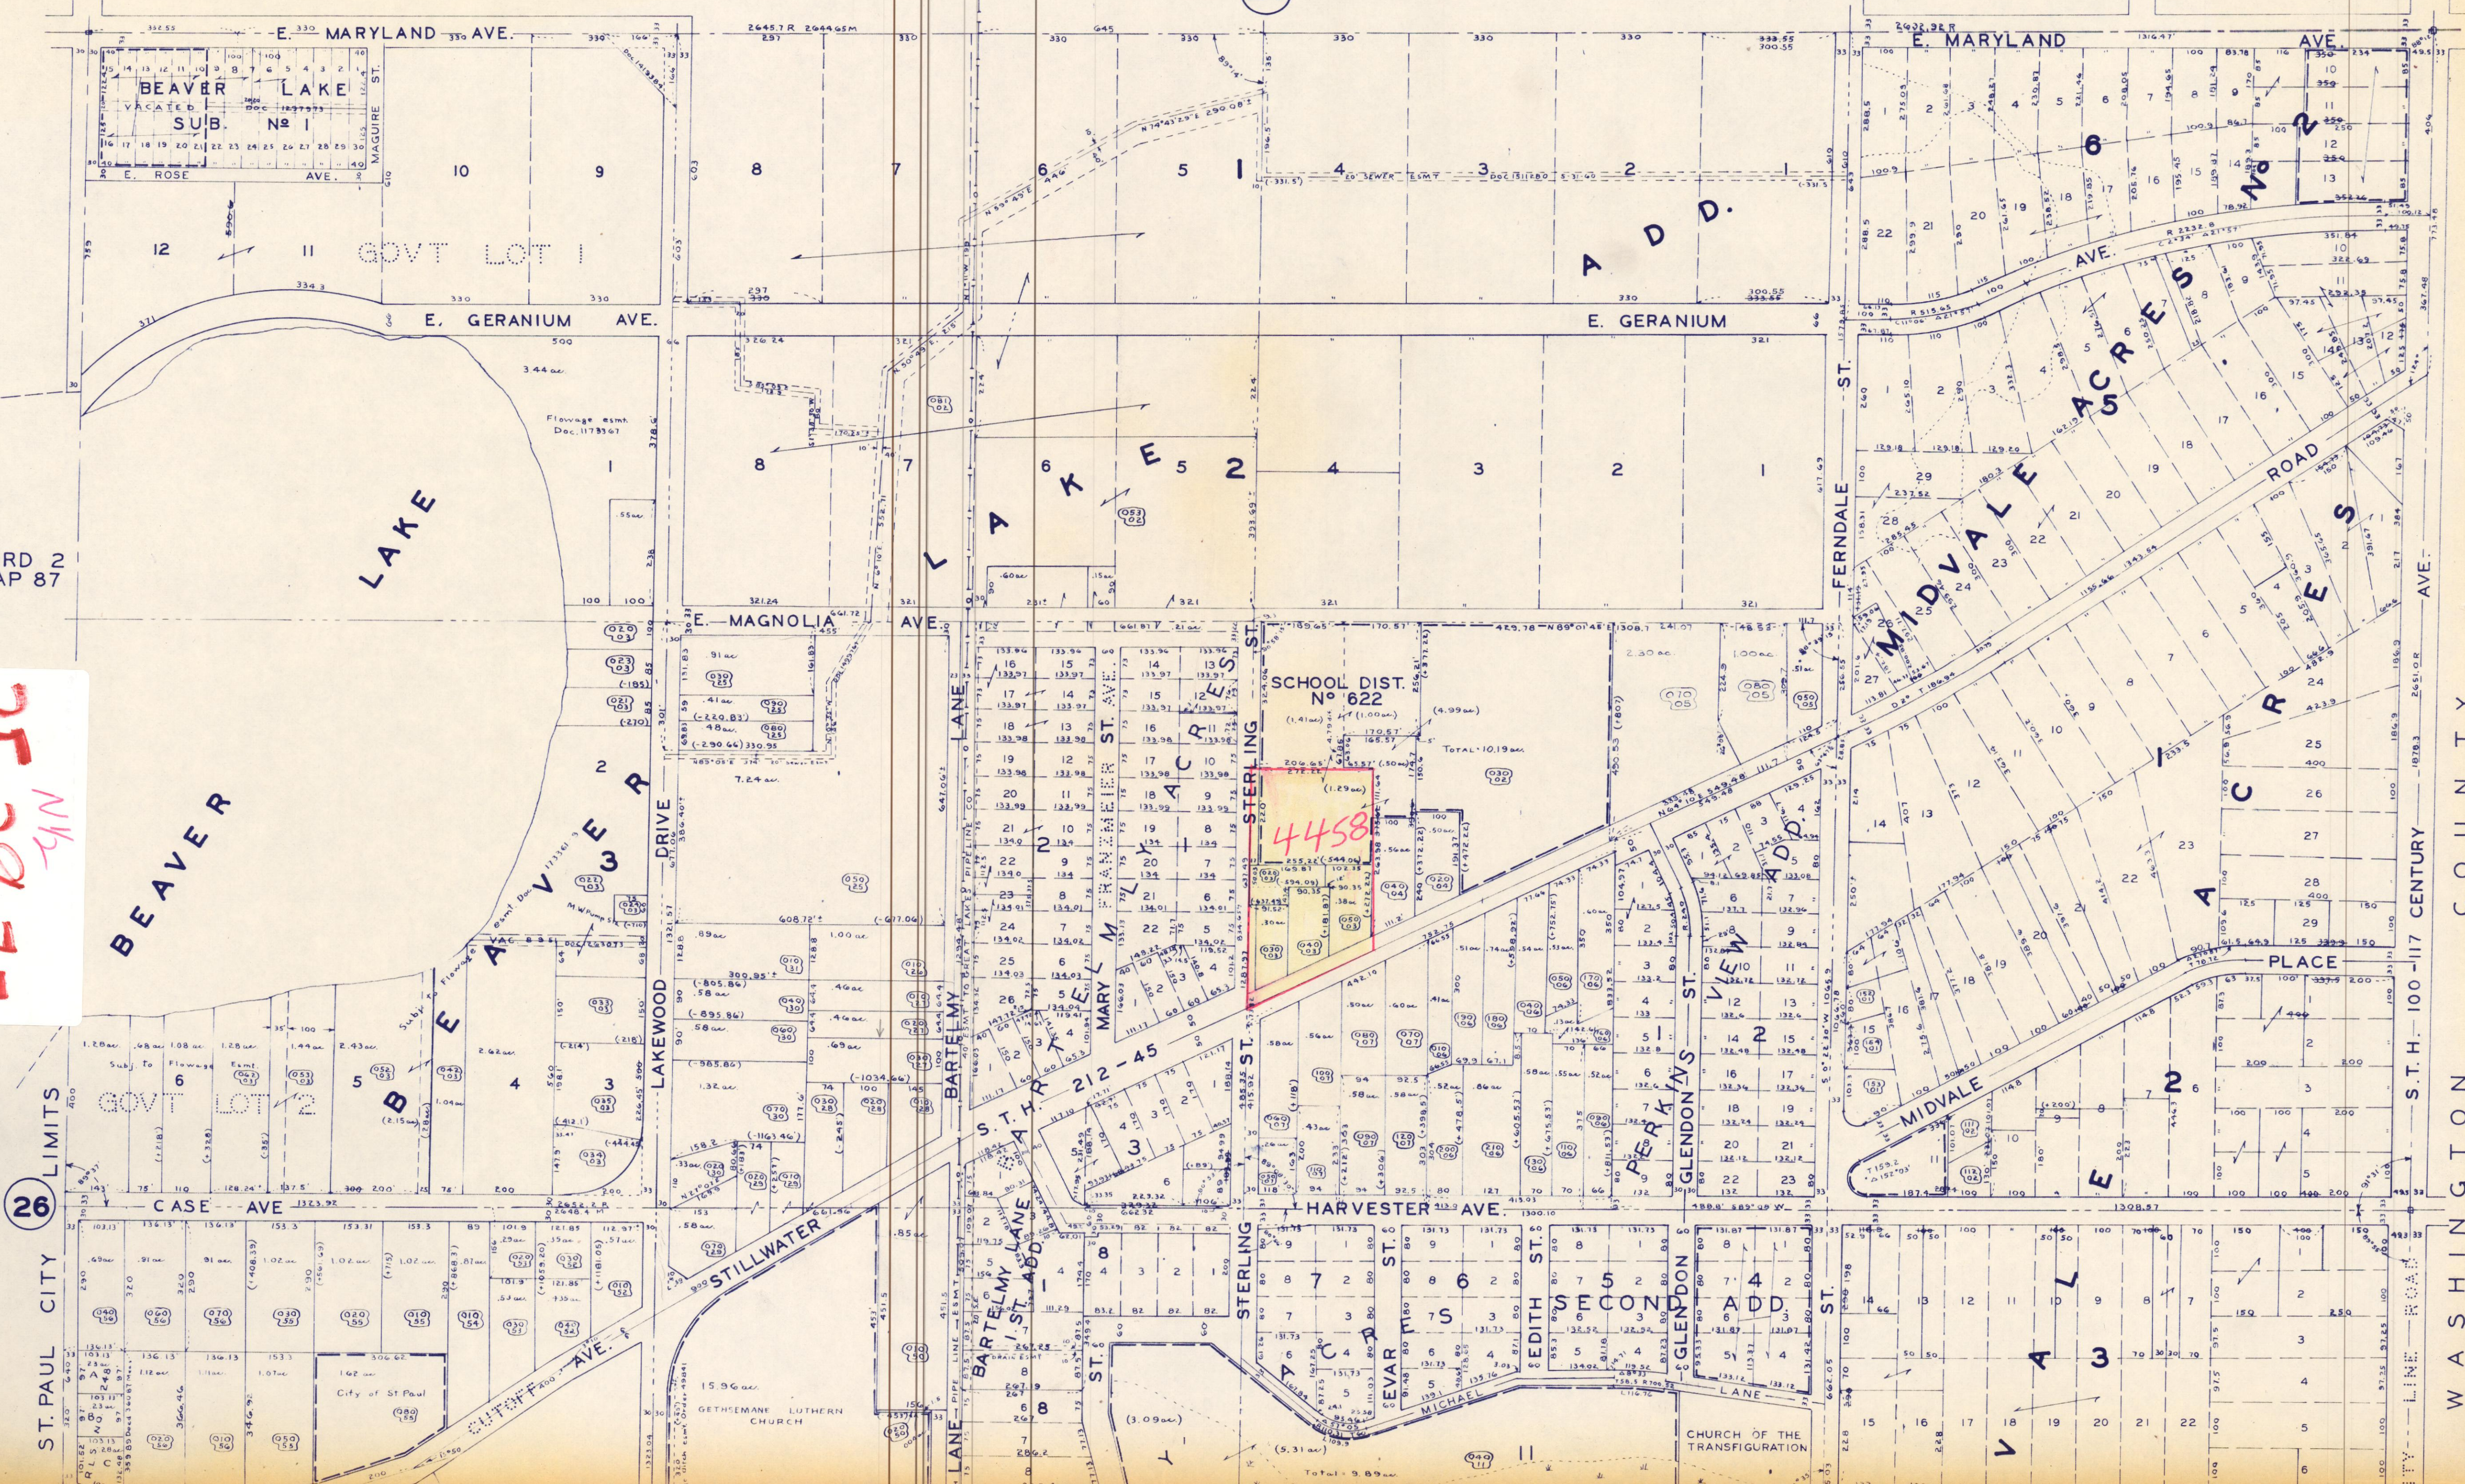

BEAVER LAKE

BEAVER LAKE SUB No 1

GOVT LOT 1

E. GERANIUM AVE.

E. MARYLAND AVE.

E. MAGNOLIA AVE.

A D D.

SCHOOL DIST. No 622

LAKE

ACRES

ST. MARY

ST. MARY

MIDVALE ACRES

FERNDALE ST.

STERLING ST.

PERKINS ST.

GLENLON ST.

MIDVALE ACRES

WASHINGTON COUNTY

S.T.H. 100-117 CENTURY AVE.

26

ST. PAUL CITY LIMITS

CASE AVE.

HARVESTER AVE.

EDITH ST.

GLENLON ST.

PERKINS ST.

STERLING ST.



MIDVALE ACRES

MIDVALE ACRES

