


# SECTION 29, T. 30R. 23

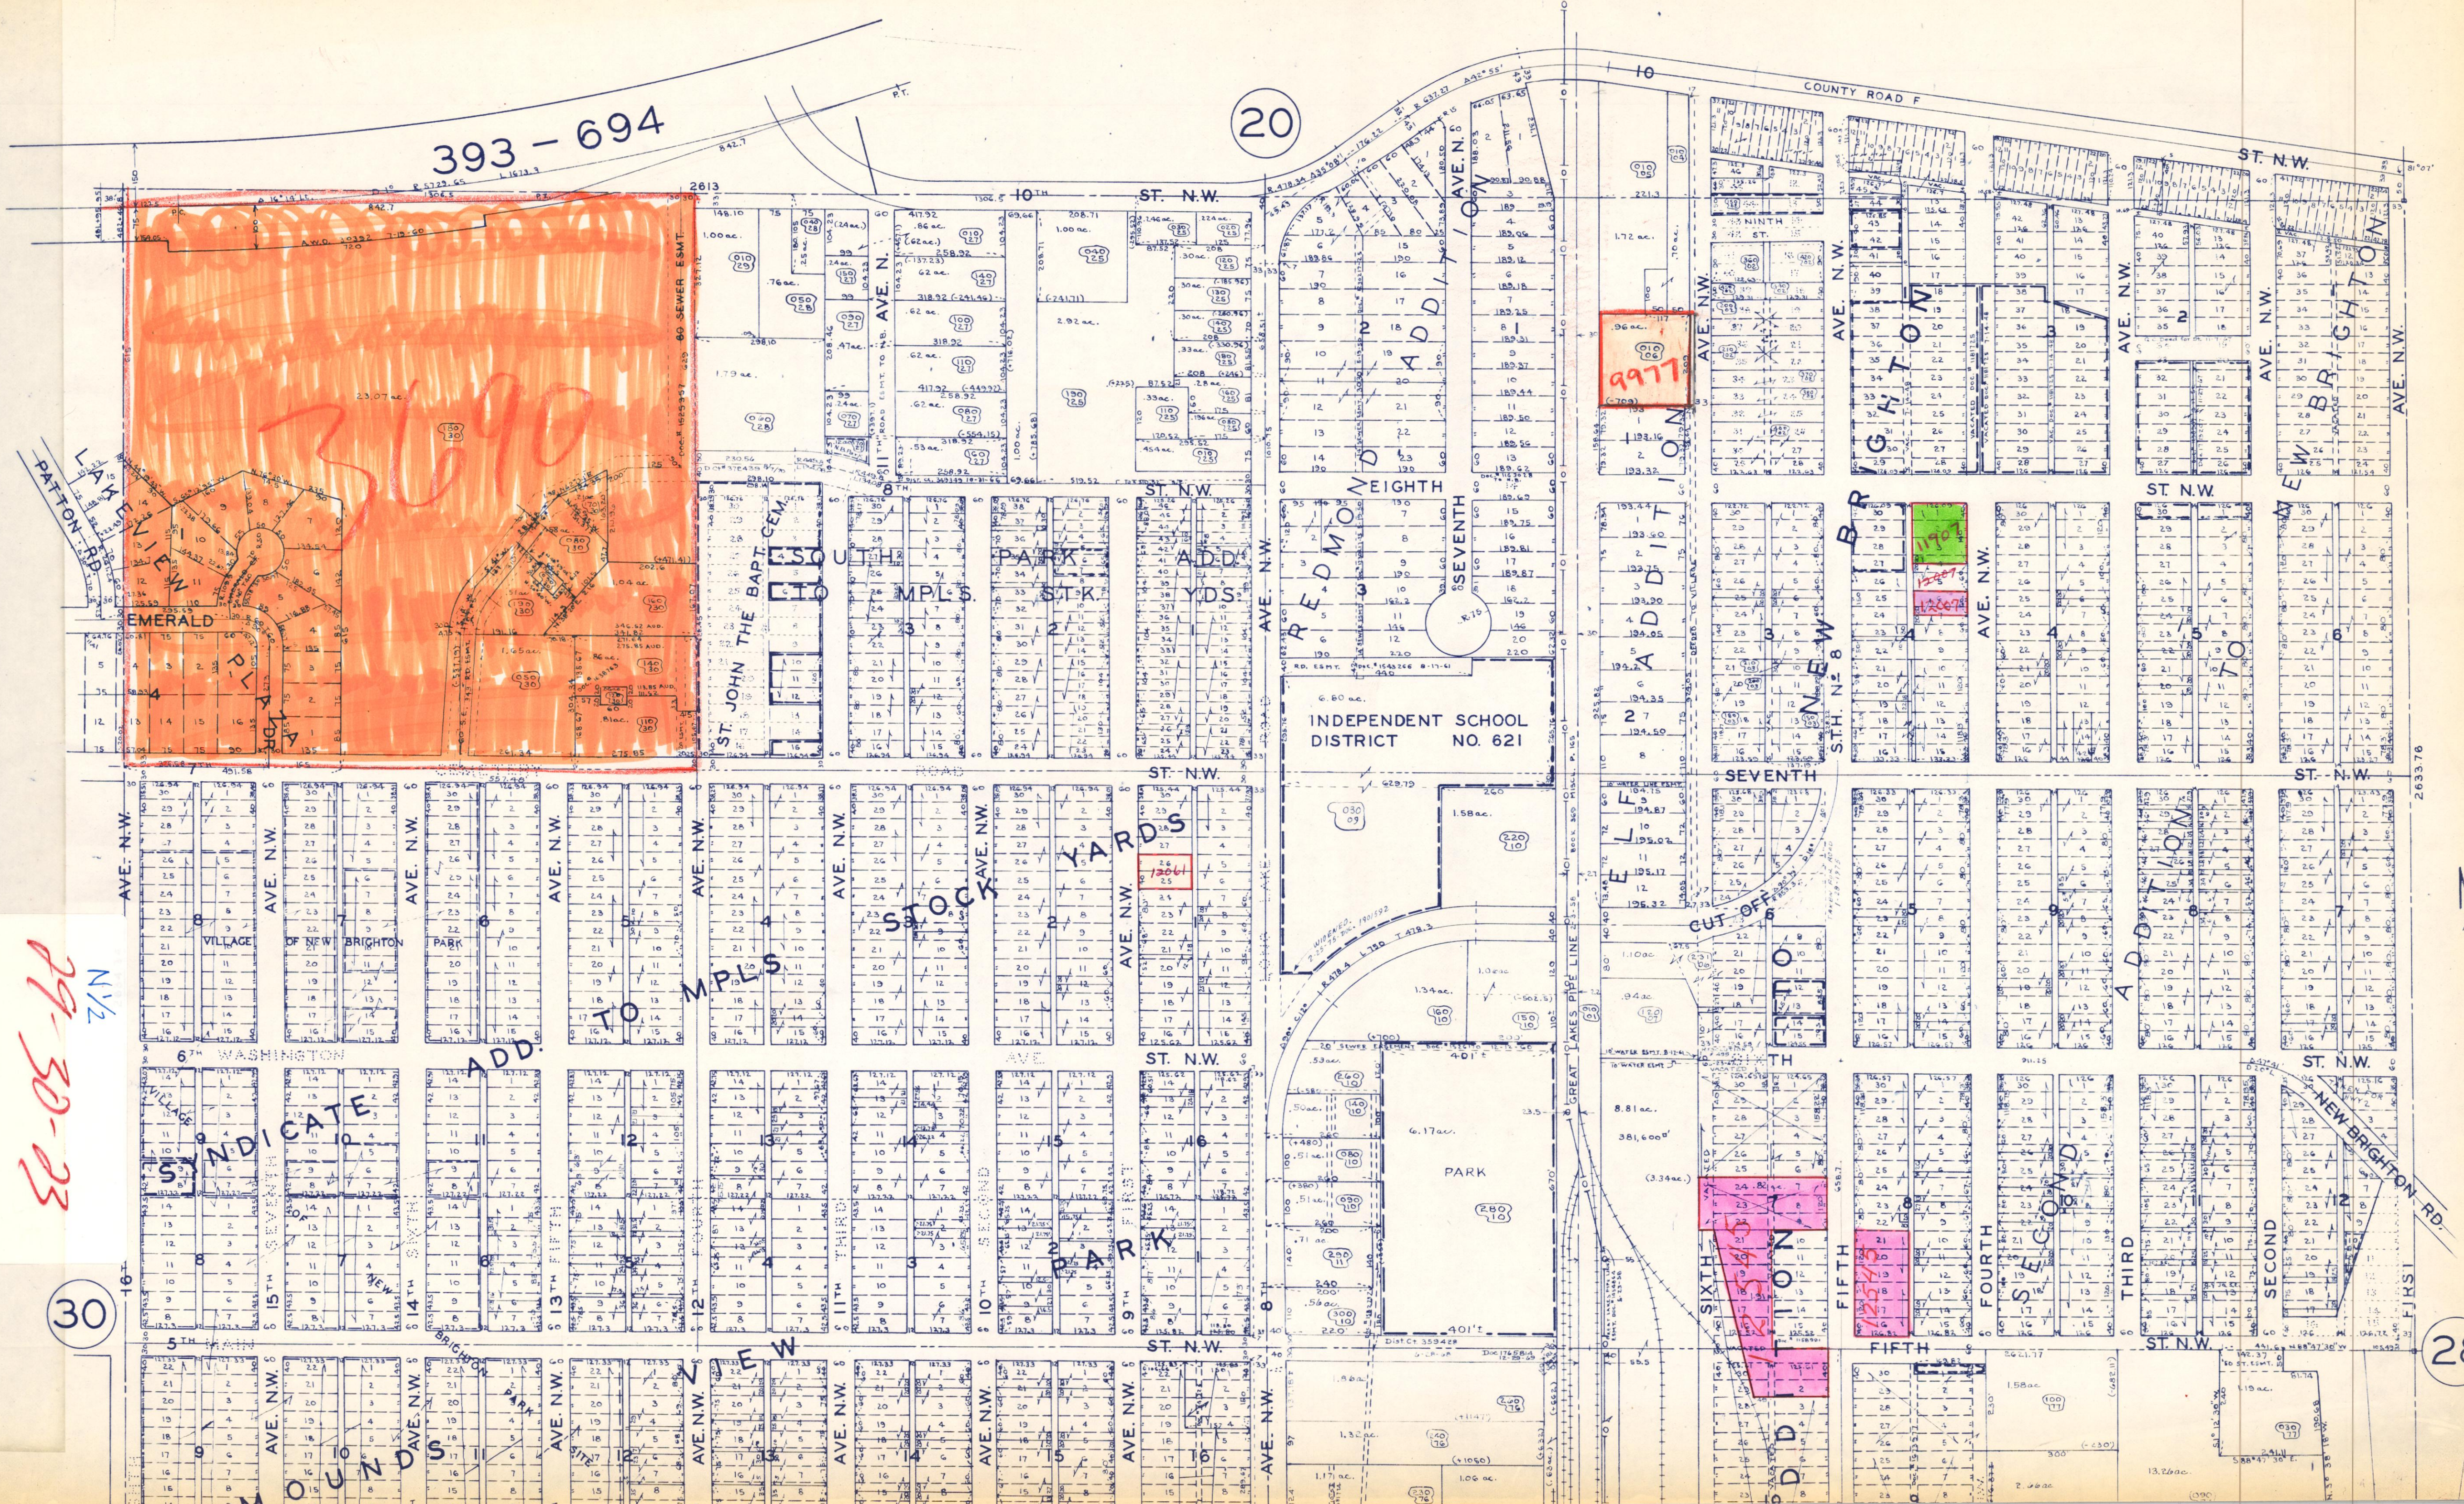

393 - 694

20

9977

INDEPENDENT SCHOOL DISTRICT NO. 621

SEVENTH

28

29-30-23  
1/2 N

30

263376