


N 1/2 SEC. 3 T. 30 R. 23

REFERENCE PURPOSES AND THE COUNTY IS NOT RESPONSIBLE FOR ANY INACCURACIES HEREIN CONTAINED.

N 1/2 3-30-23

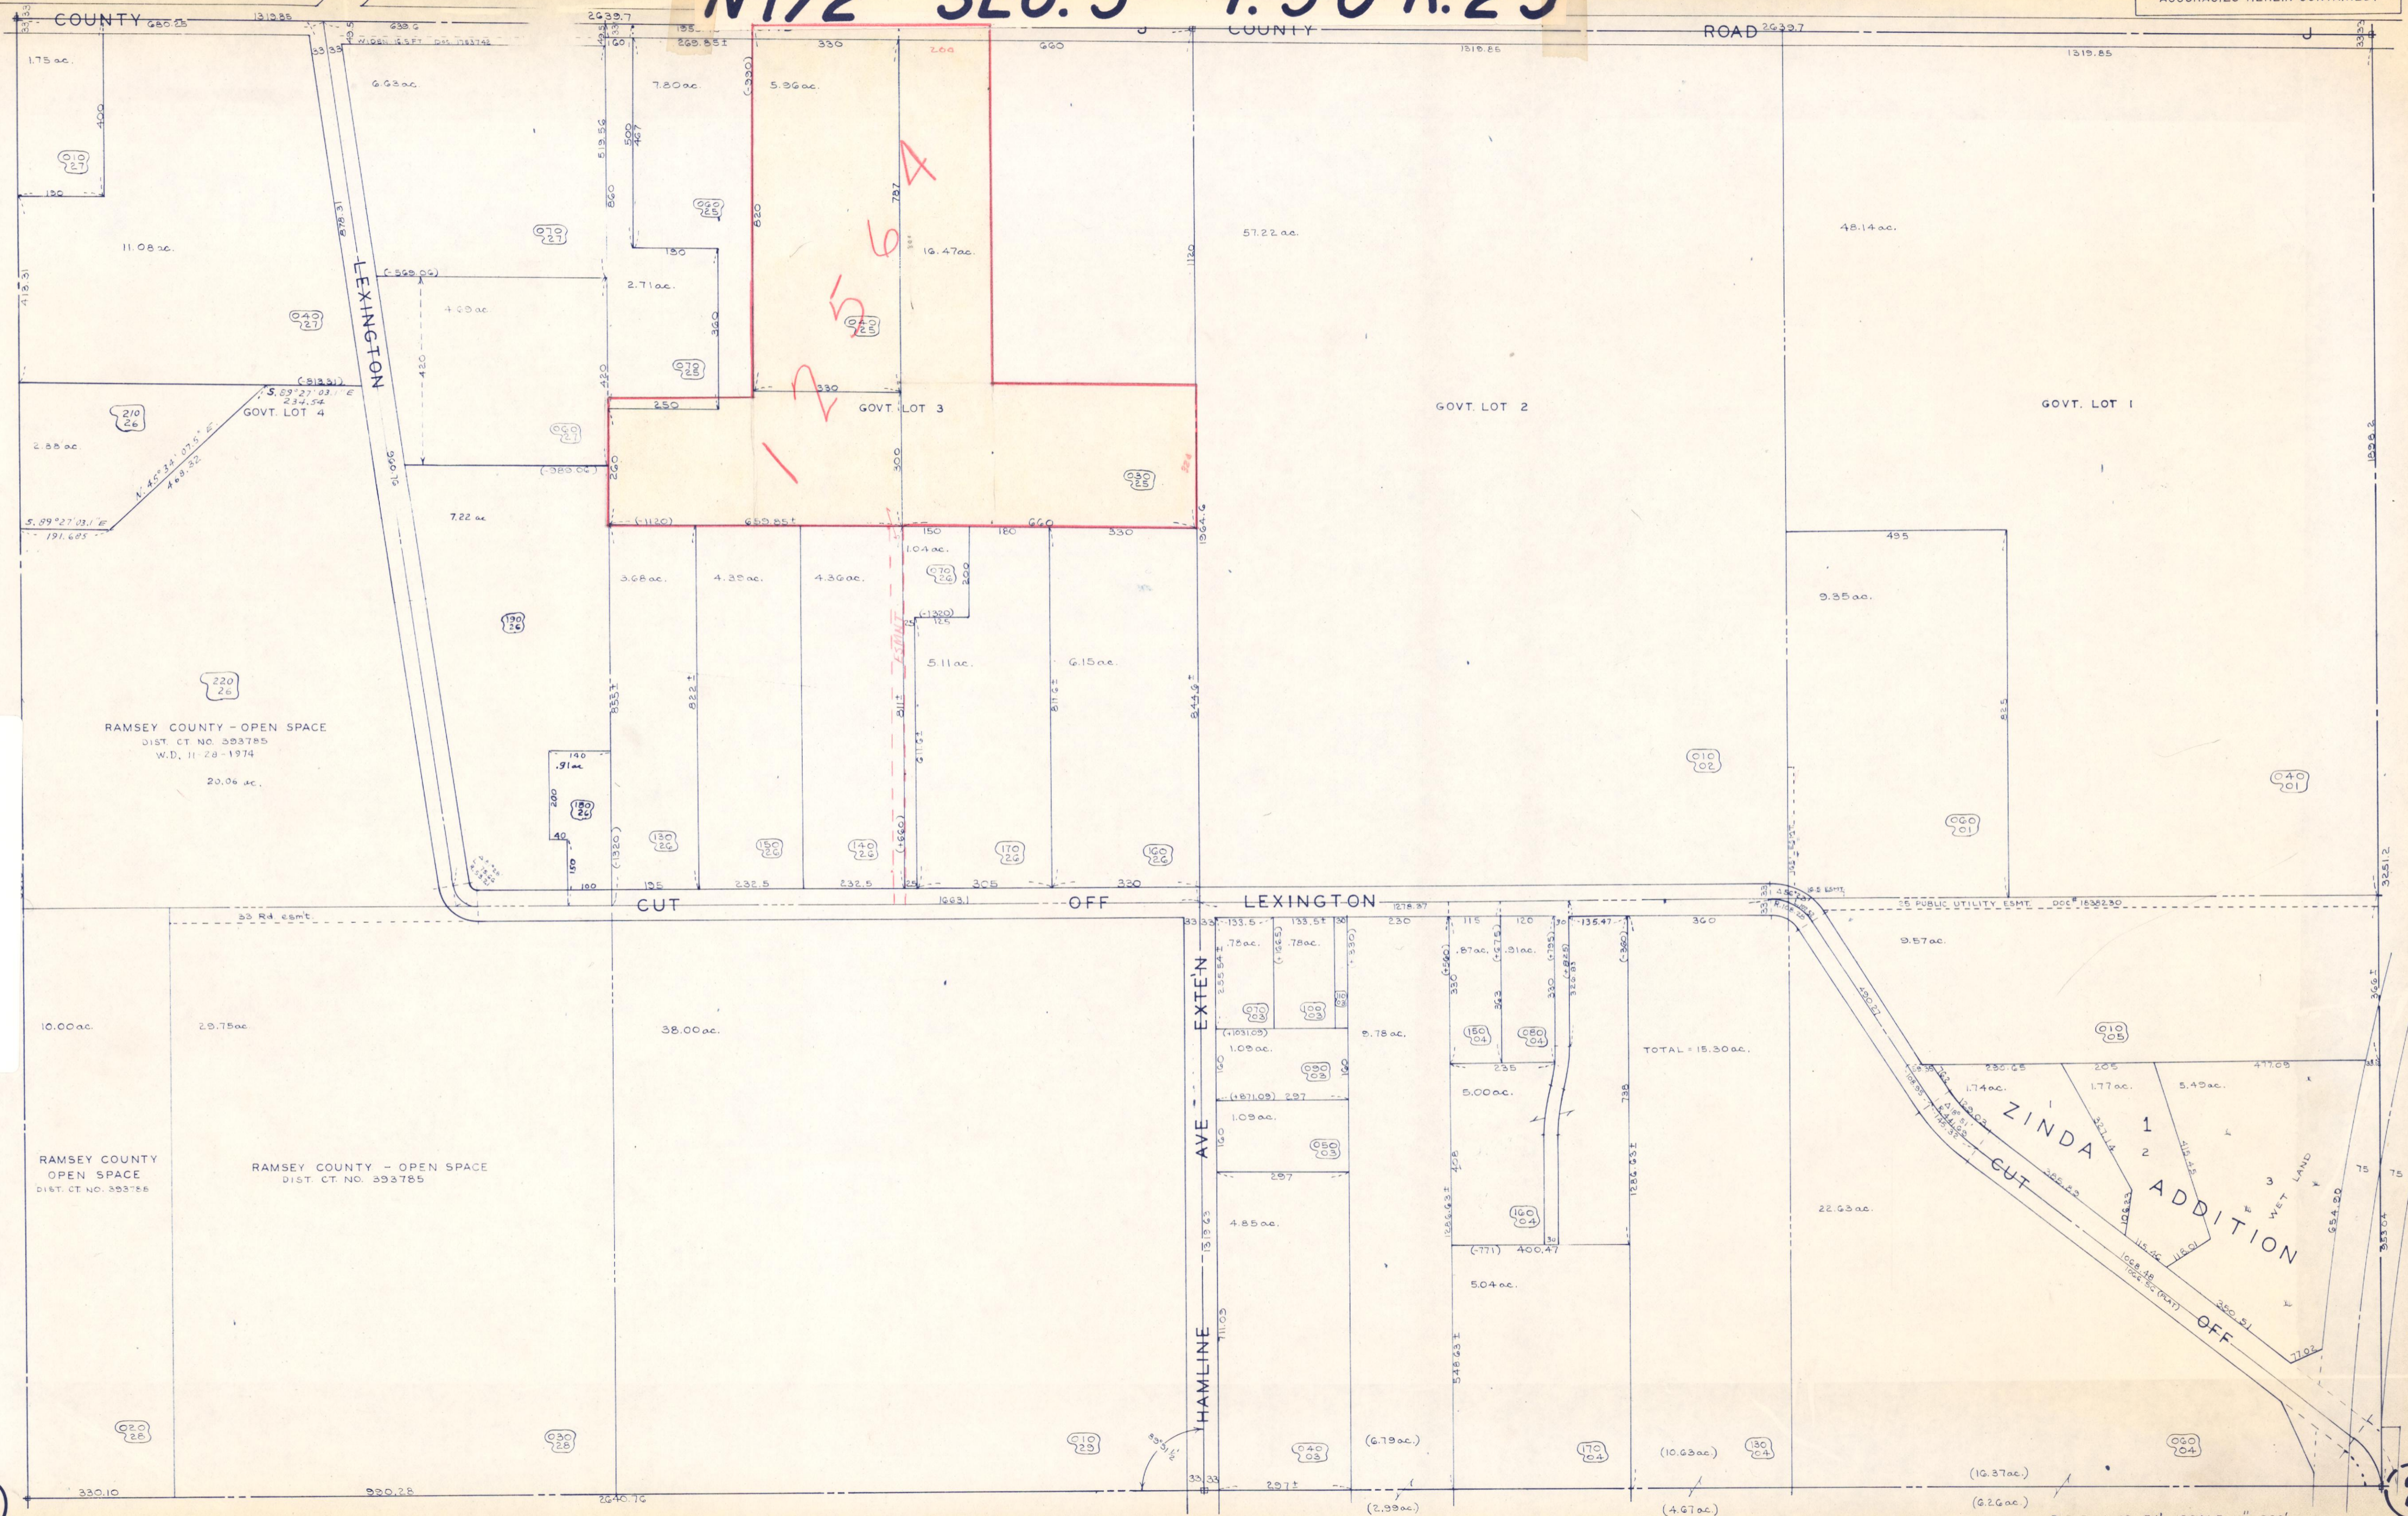

4

2