


SECTION 30, T.30, R.23.

19

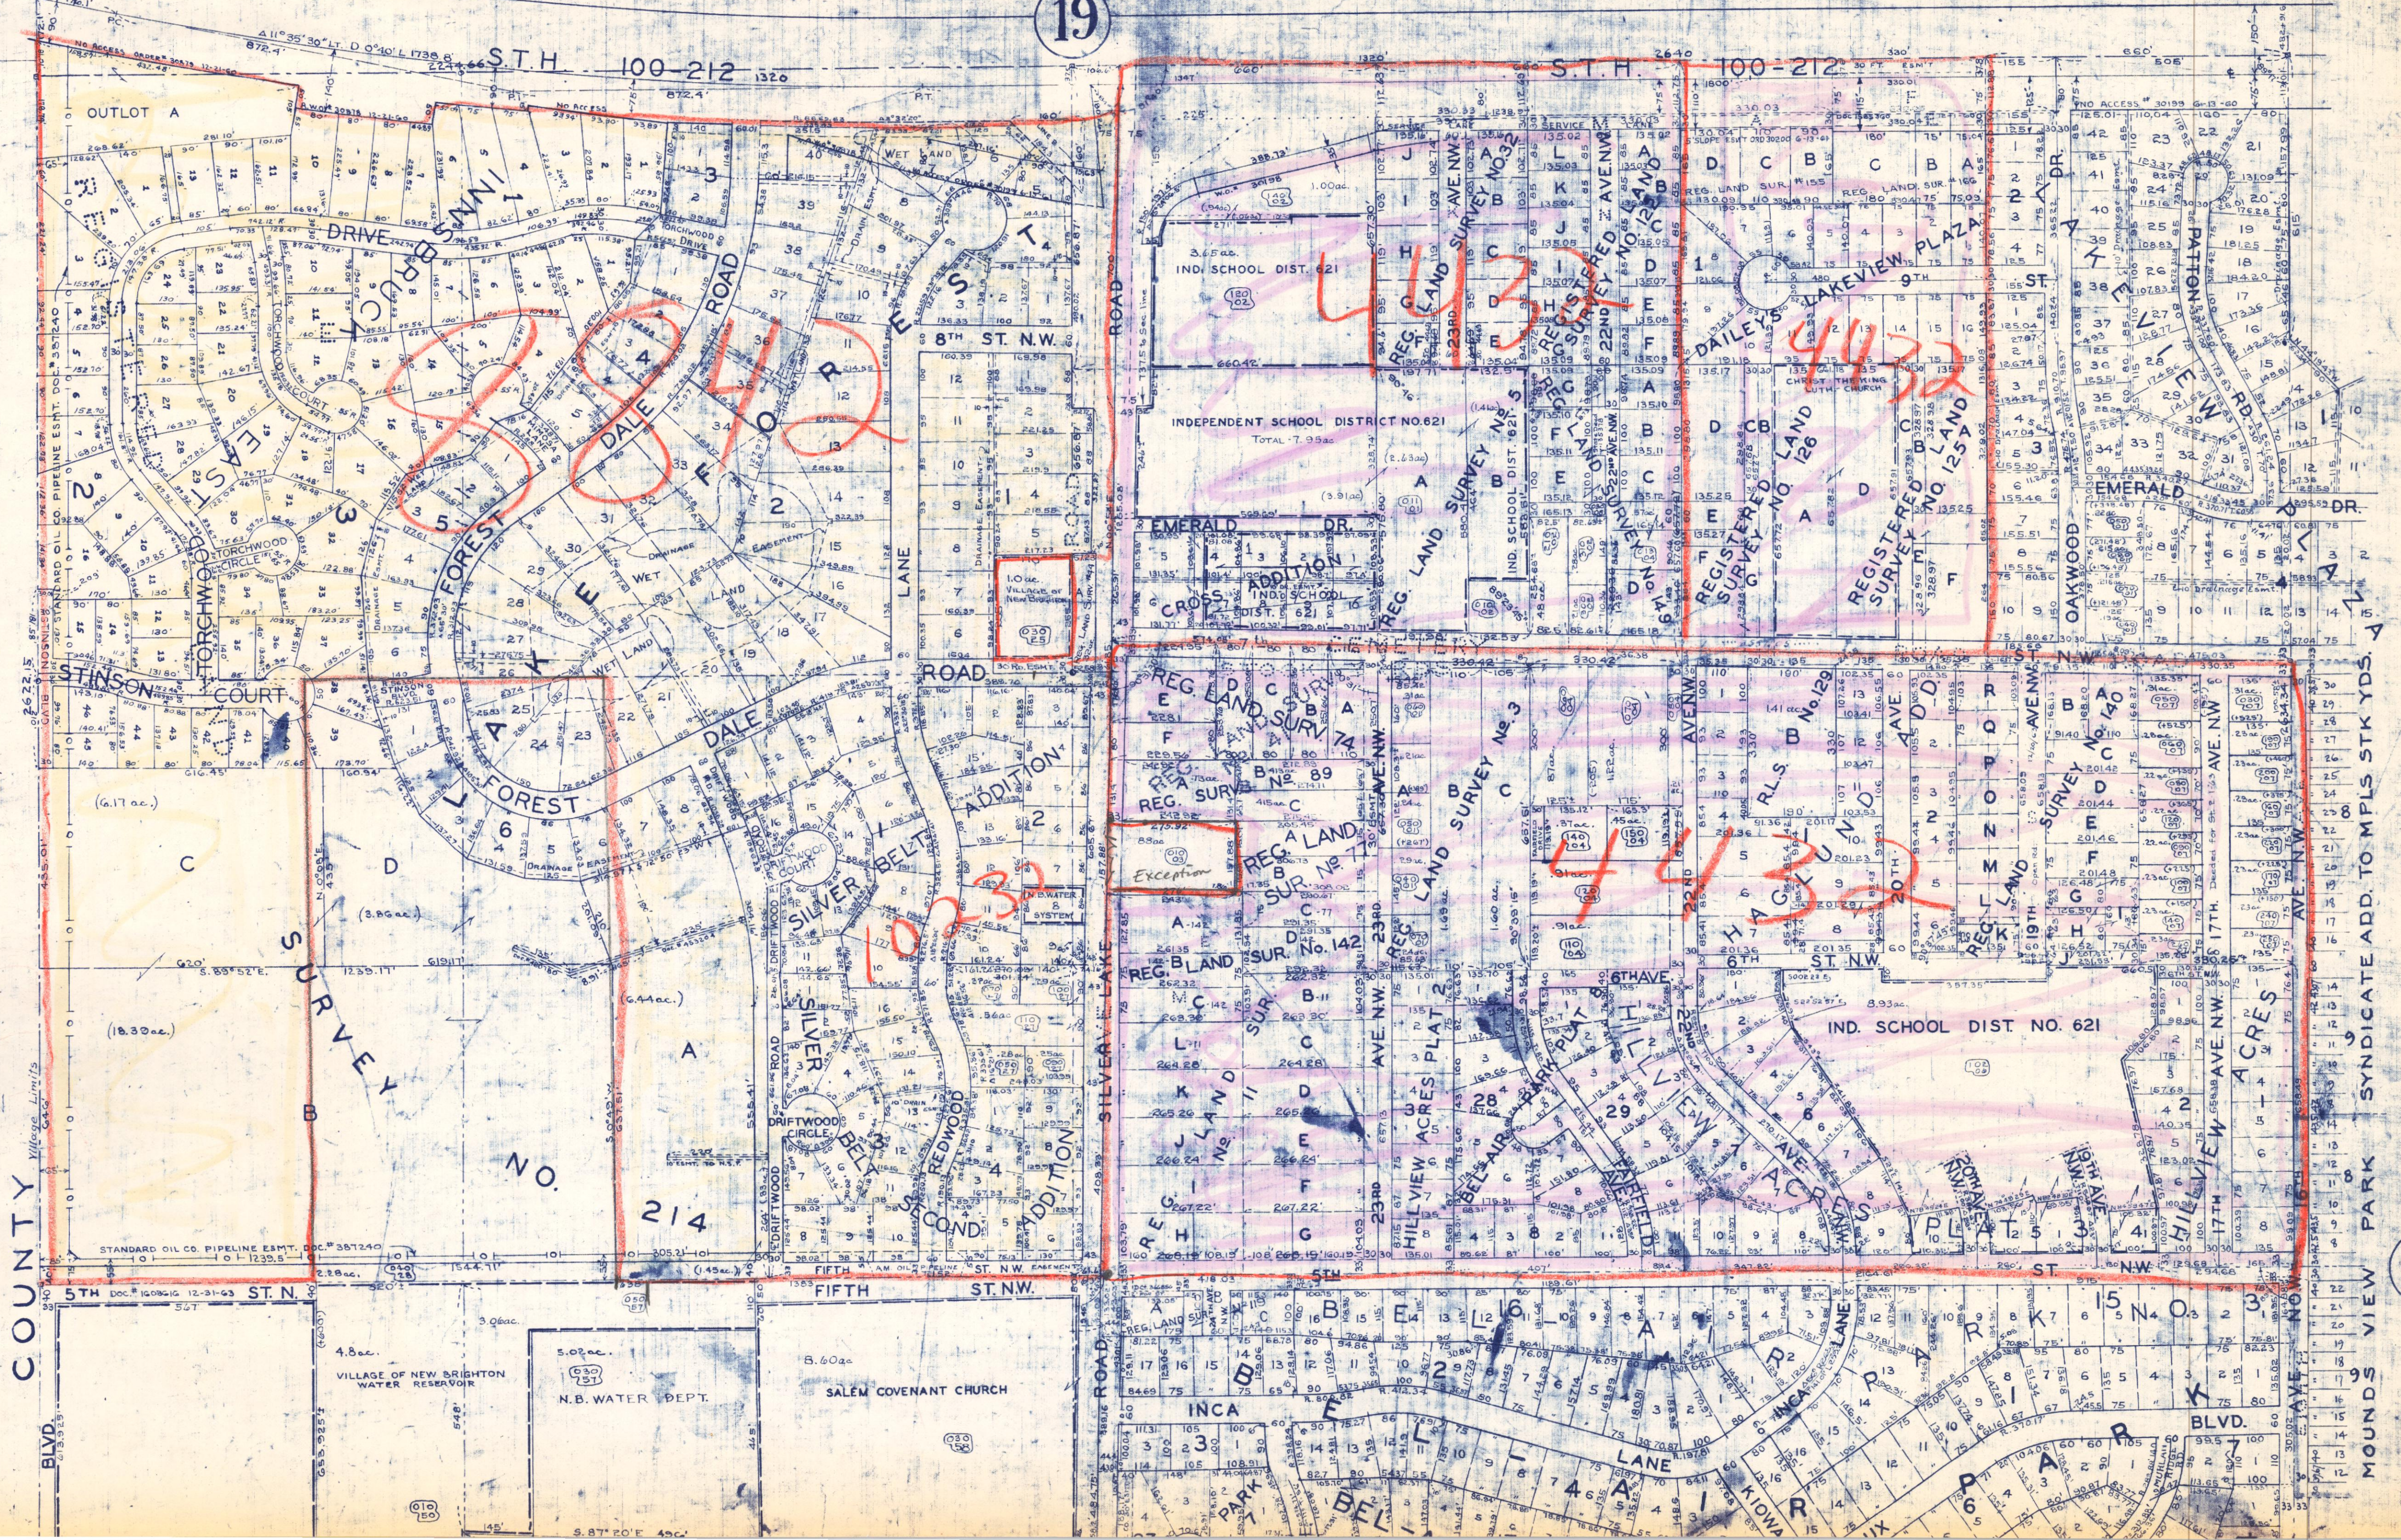

230-30-23

230

29