


SECTION 33 T 30 R 23

28

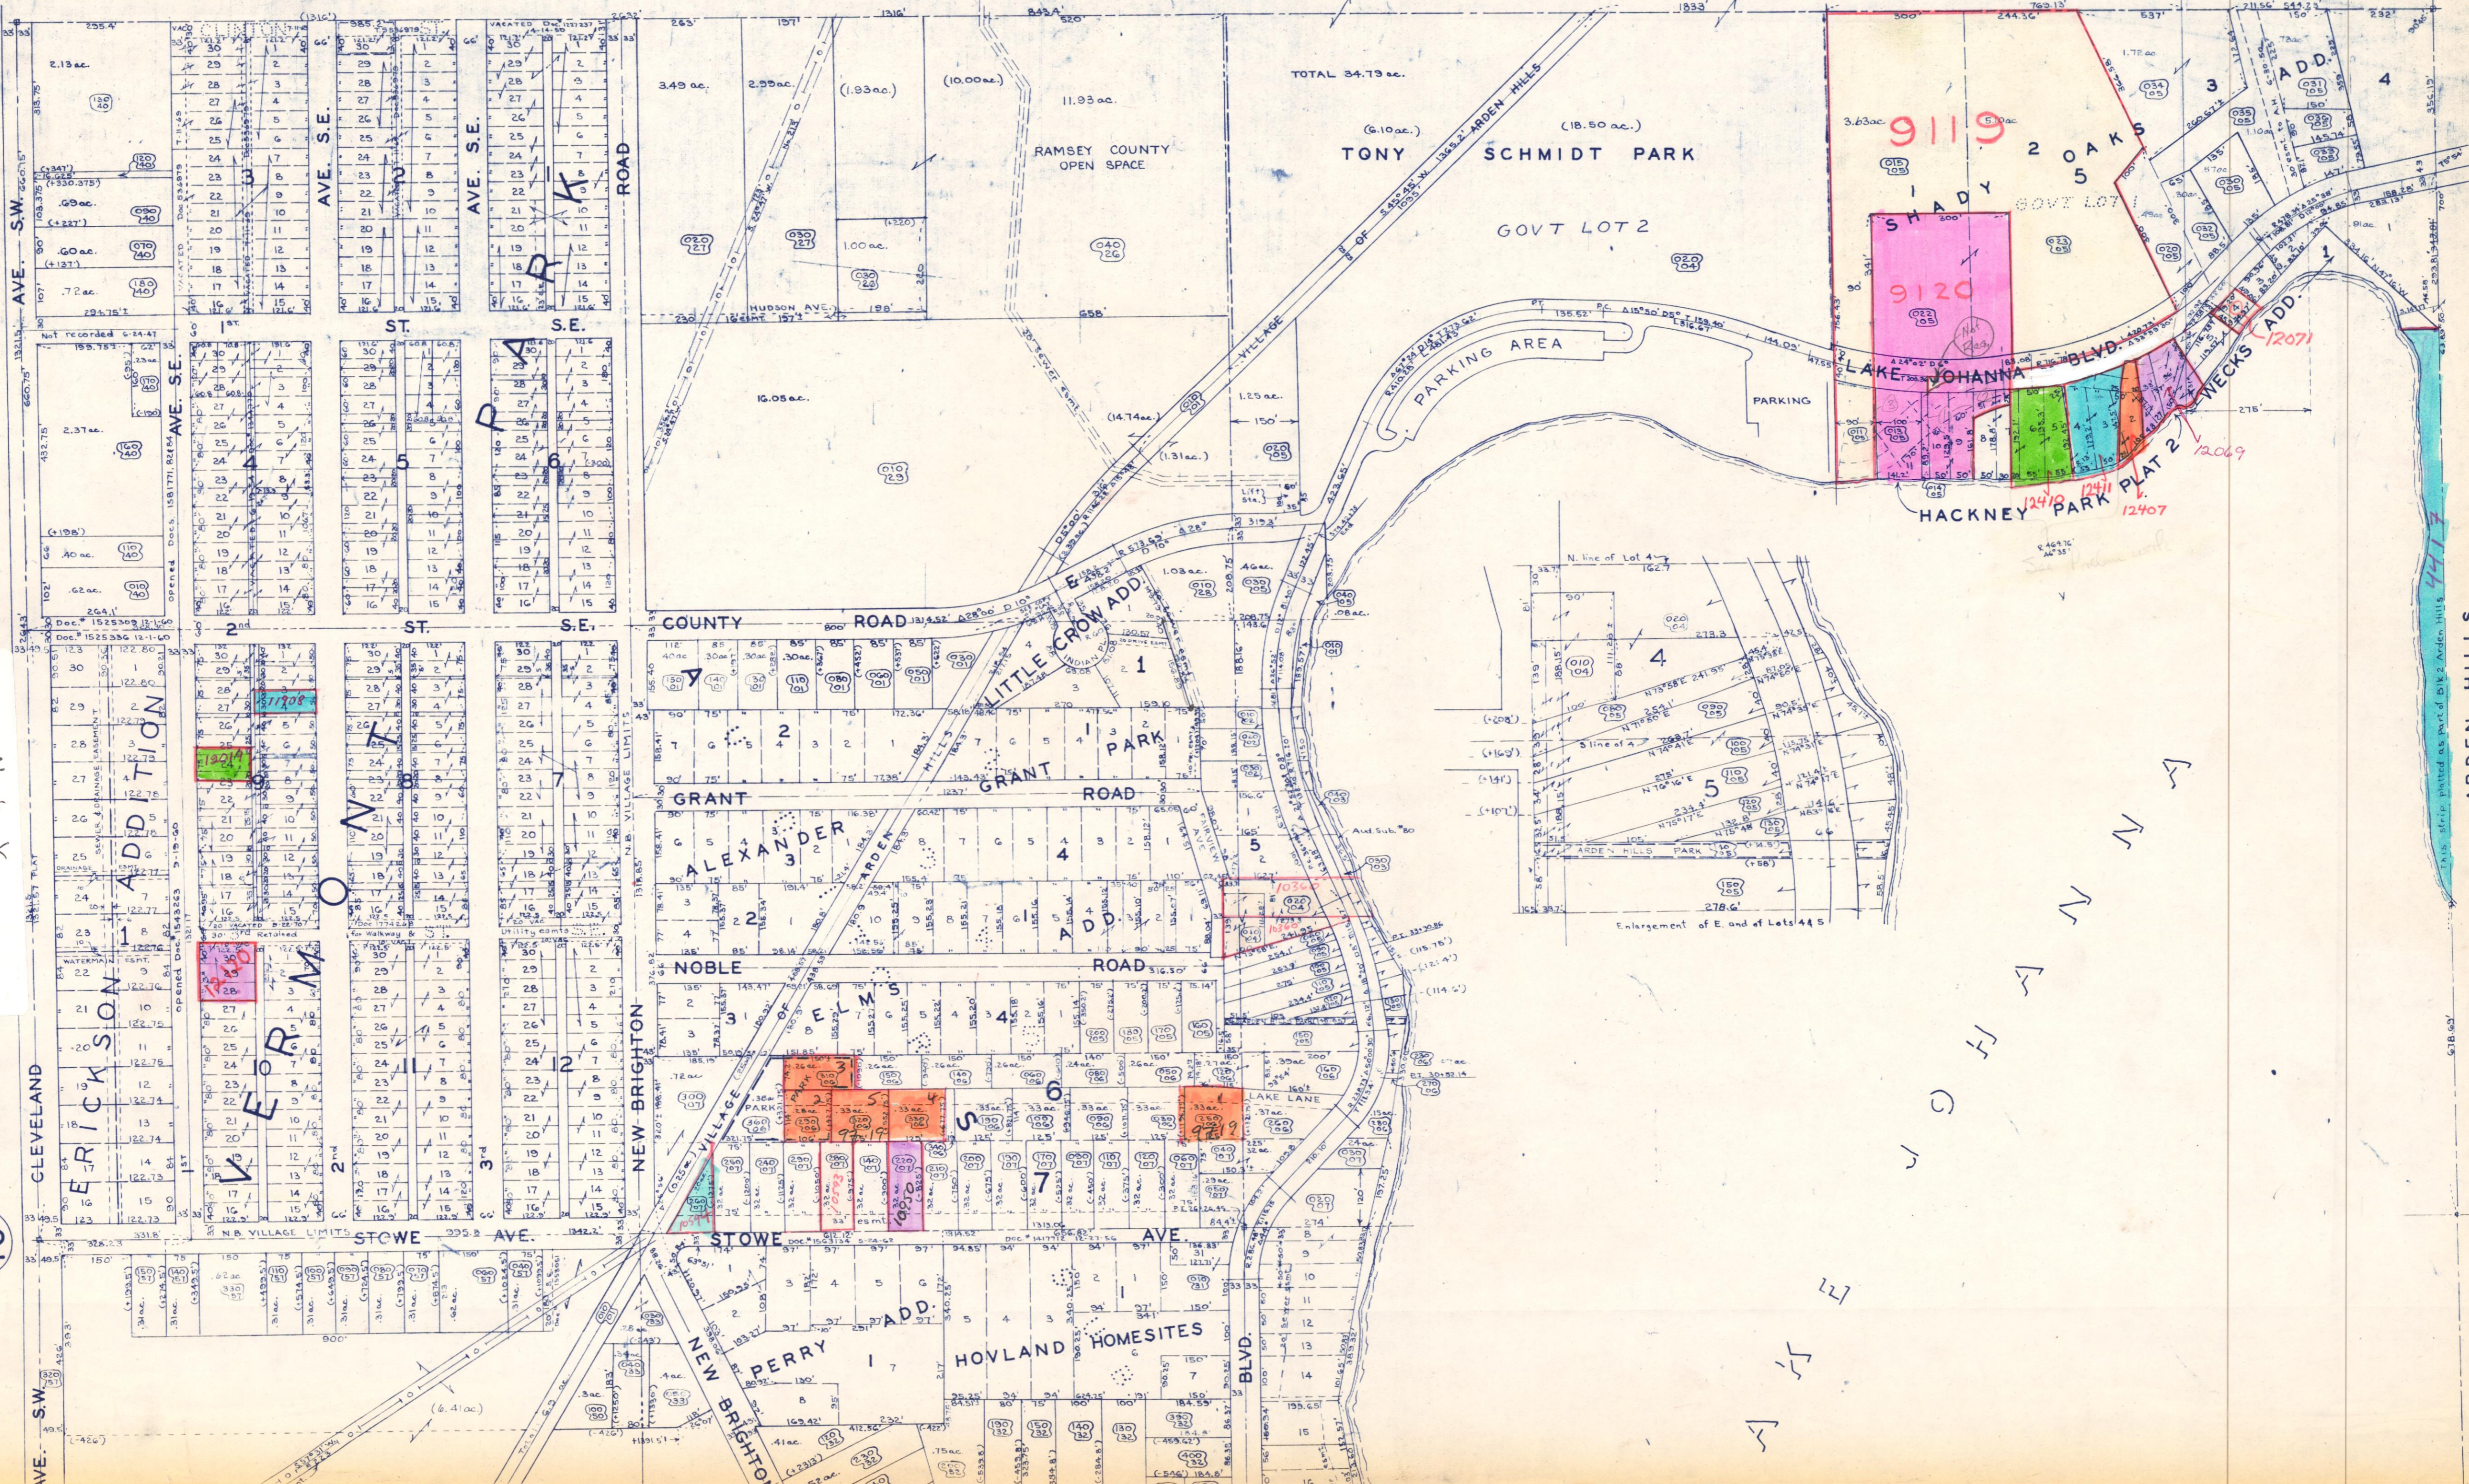

33-30-23 North 1/2

32

ARDEN HILLS