


# SECTION 4. T. 29. R. 23

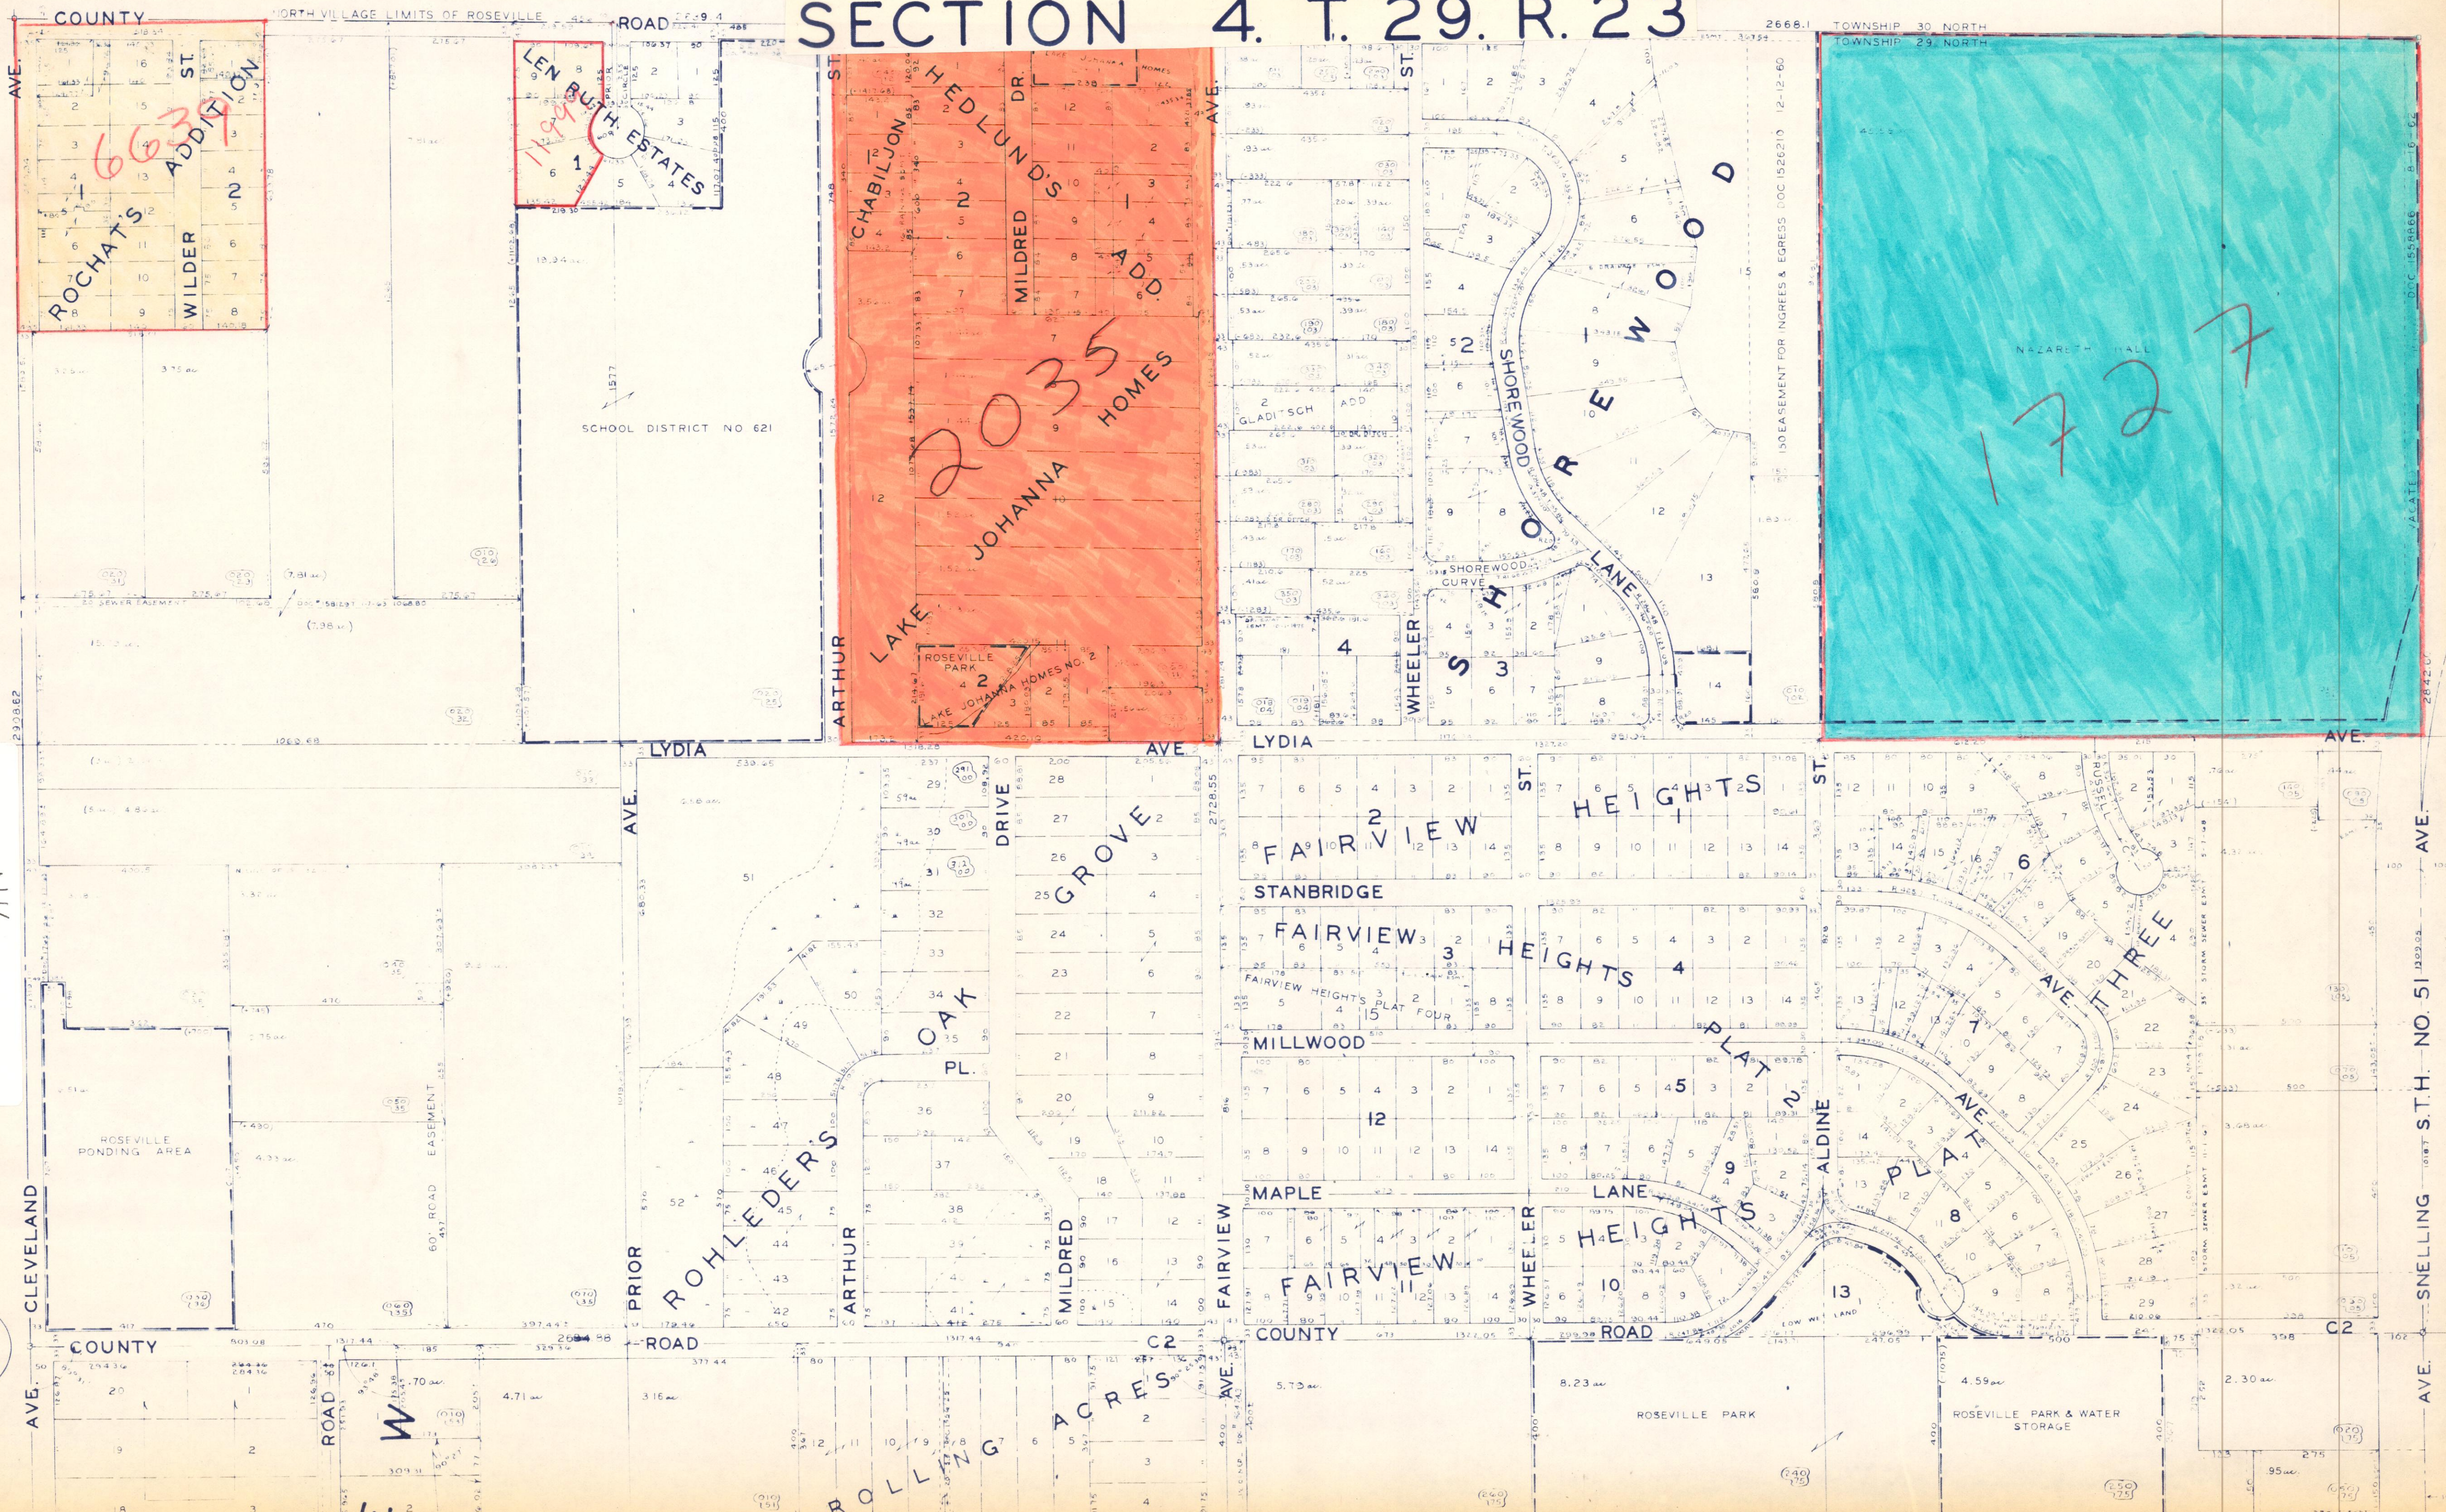

4-29-23  
N 1/2

5

ROCHAT'S ADDITION  
WILDER

1199  
LEN RUTH ESTATES

2035  
JOHANNA HOMES  
LAKE JOHANNA HOMES NO. 2

1727  
NAZARETH HALL

COUNTY NORTH VILLAGE LIMITS OF ROSEVILLE ROAD 77-9 4 2666.1 TOWNSHIP 30 NORTH TOWNSHIP 29 NORTH

ROCHATS ADDITION WILDER

LEN RUTH ESTATES

CHABILJON HEDLUND'S MILDRED'S

LAKE JOHANNA HOMES

ROSEVILLE PARK

FAIRVIEW HEIGHTS STANBRIDGE MILLWOOD MAPLE LANE WHEELER

ROSEVILLE PARK & WATER STORAGE

ROSEVILLE PONDING AREA

60' ROAD EASEMENT

60' EASEMENT FOR INGRESS & EGRESS DOC 1526210 12-12-60

ARTHUR ST LYDIA AVE CLEVELAND AVE SNELLING AVE

WHEELER ST SHOREWOOD CURVE SHOREWOOD LANE

ROSEVILLE PARK

ROLLING ACRES

ROSEVILLE PARK

ROSEVILLE PARK & WATER STORAGE

SCHOOL DISTRICT NO 621

51

28

27

26

25

24

23

22

21

20

19

18

17

16

15

14

13

12

11

10

9

8

7

6

5

4

3

2

1

12

11

10

9

8

7

6

5

4

3

2

1

13

12

11

10

9

8

7

6

5

4

3

2

1

14

