


N 1/2 SEC. 9 T.30 R.23

THIS IS A COMPILATION OF RECORDS AS THEY APPEAR IN THE RAMSEY COUNTY OFFICES AFFECTING THE AREA SHOWN. THIS DRAWING IS TO BE USED ONLY FOR REFERENCE PURPOSES AND THE COUNTY IS NOT RESPONSIBLE FOR ANY INACCURACIES HEREIN CONTAINED.

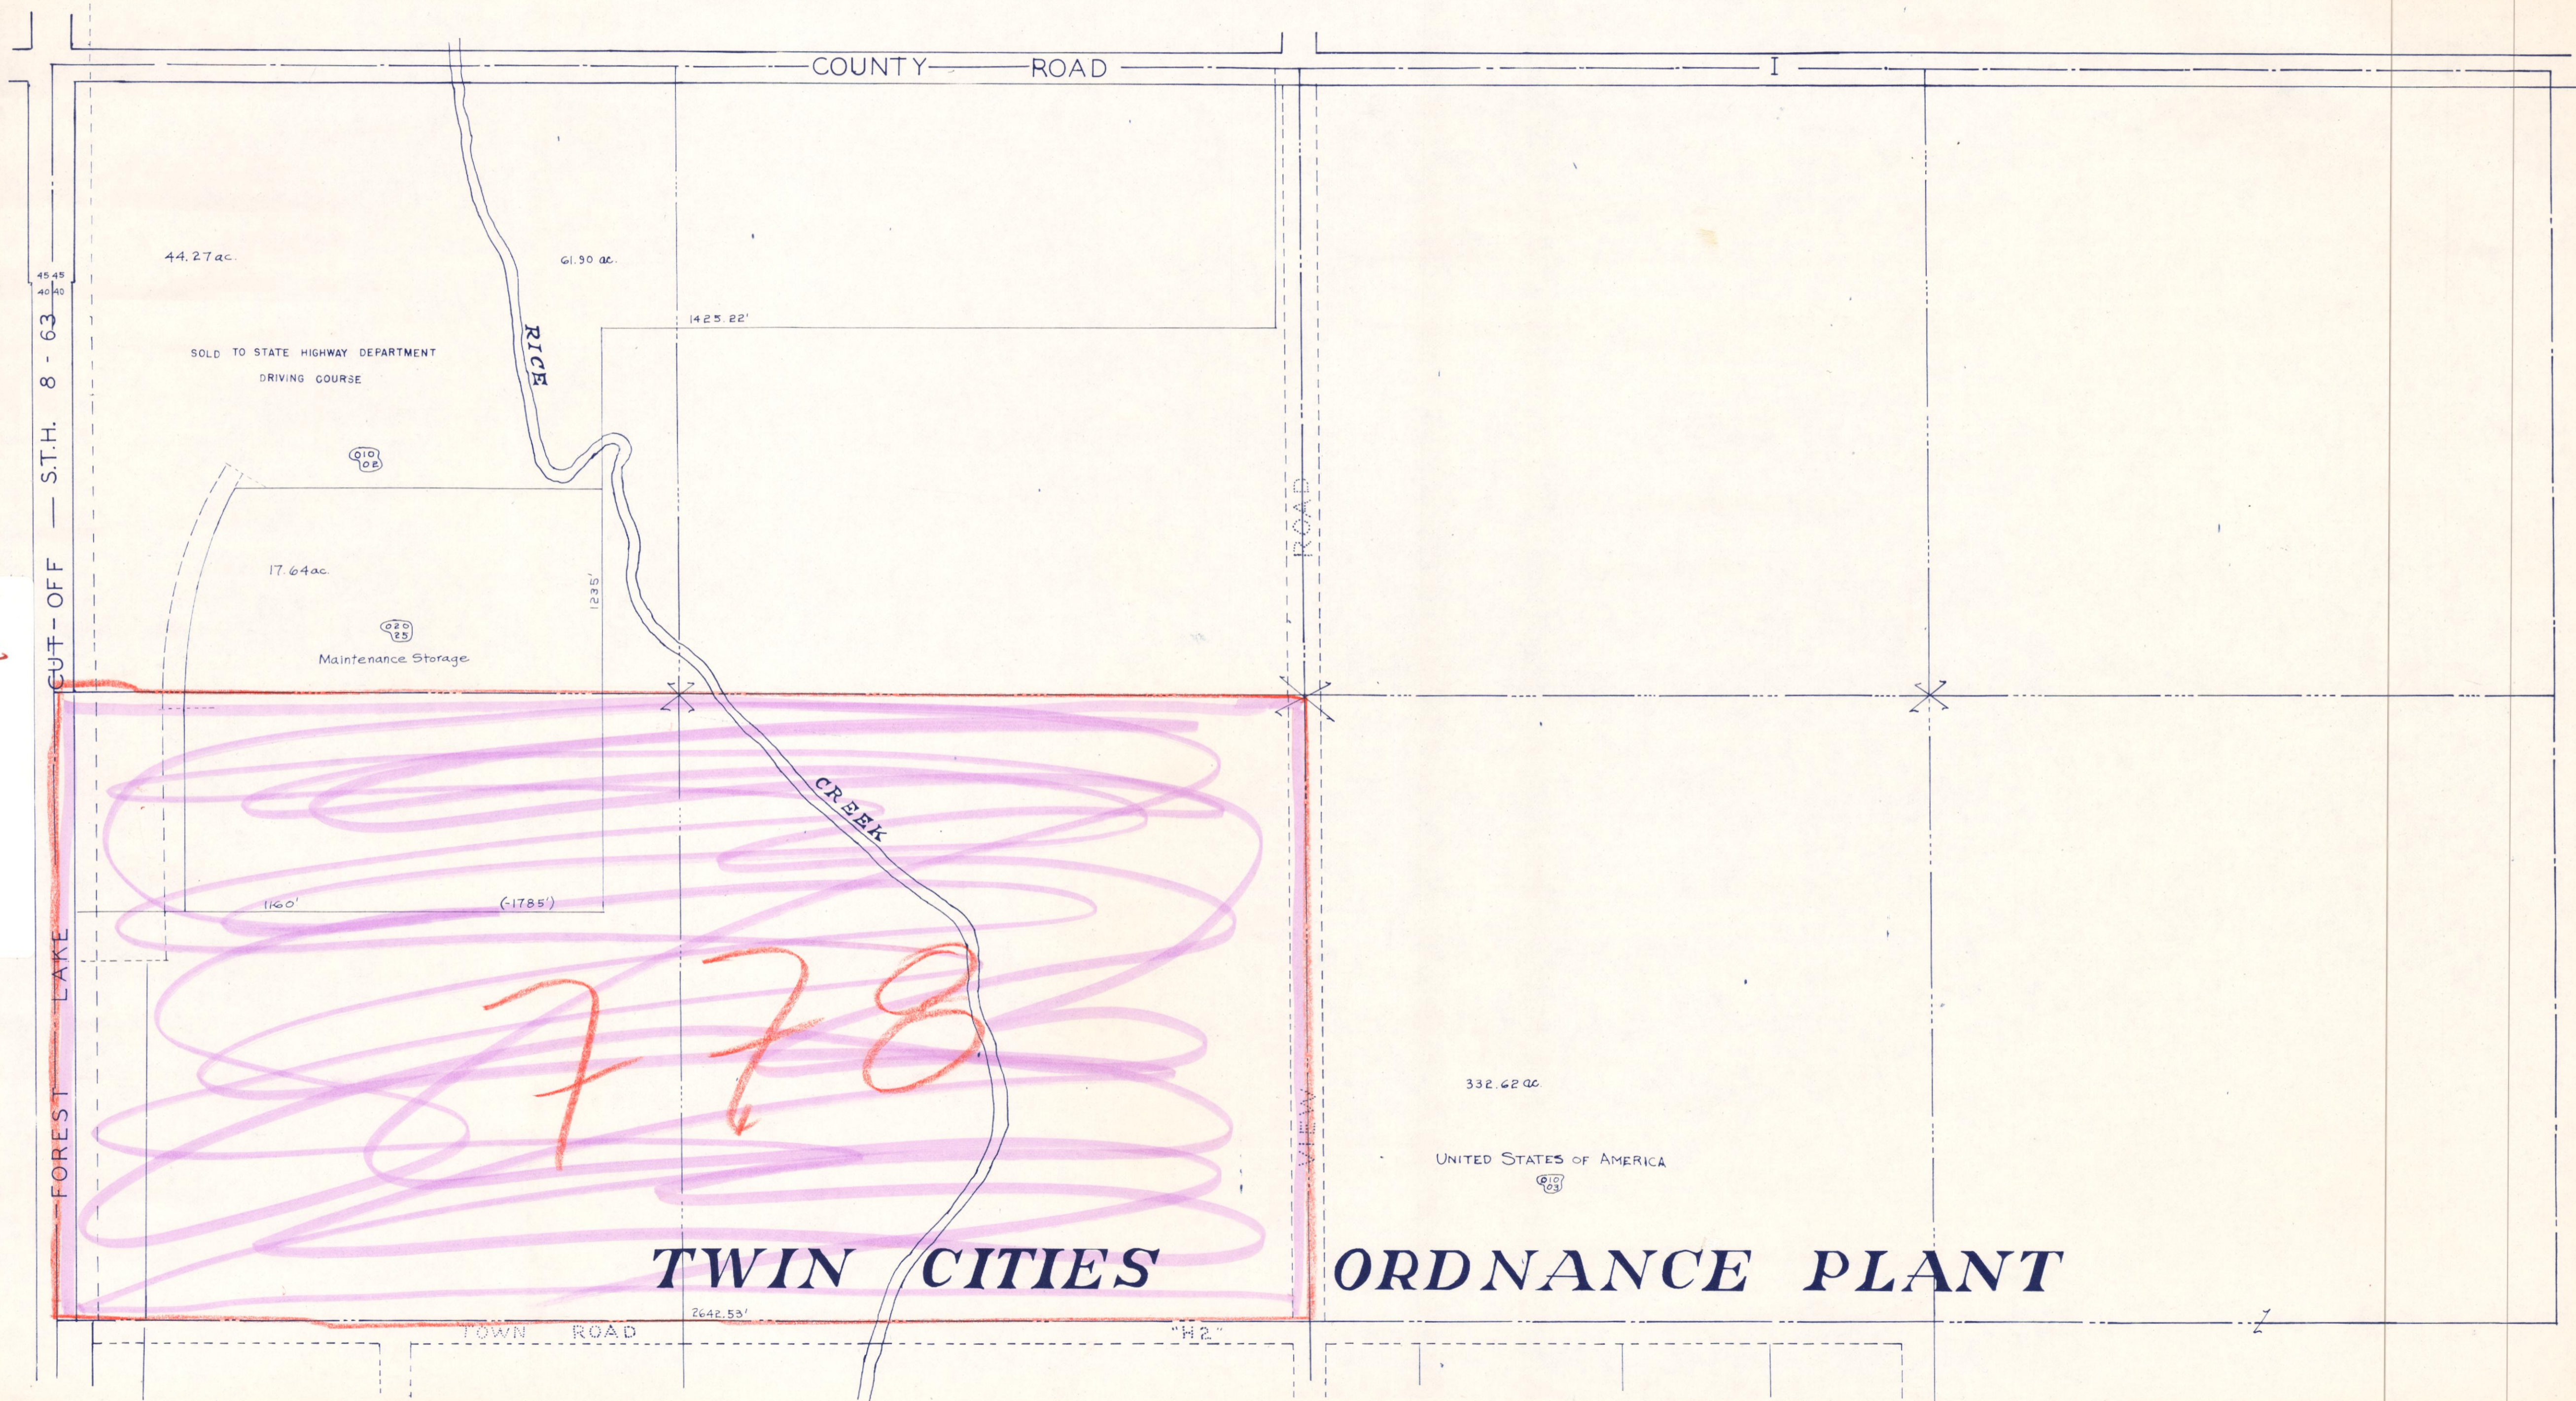

N 9-30-23

TWIN CITIES

ORDNANCE PLANT

UNITED STATES OF AMERICA

CUT-OFF — S.T.H. 8 - 63

FOREST LAKE

COUNTY ROAD

ROAD

VIEW ROAD

TOWN ROAD

"H2"

44.27 ac.

61.90 ac.

17.64 ac.

1160'

(-1785')

1425.22'

1235'

2642.53'

332.62 ac.

SOLD TO STATE HIGHWAY DEPARTMENT
DRIVING COURSE

Maintenance Storage

CREEK

RICE

Q10
Q25

Q20
Q25

Q10
Q25