


16

GOVT. LOT 1

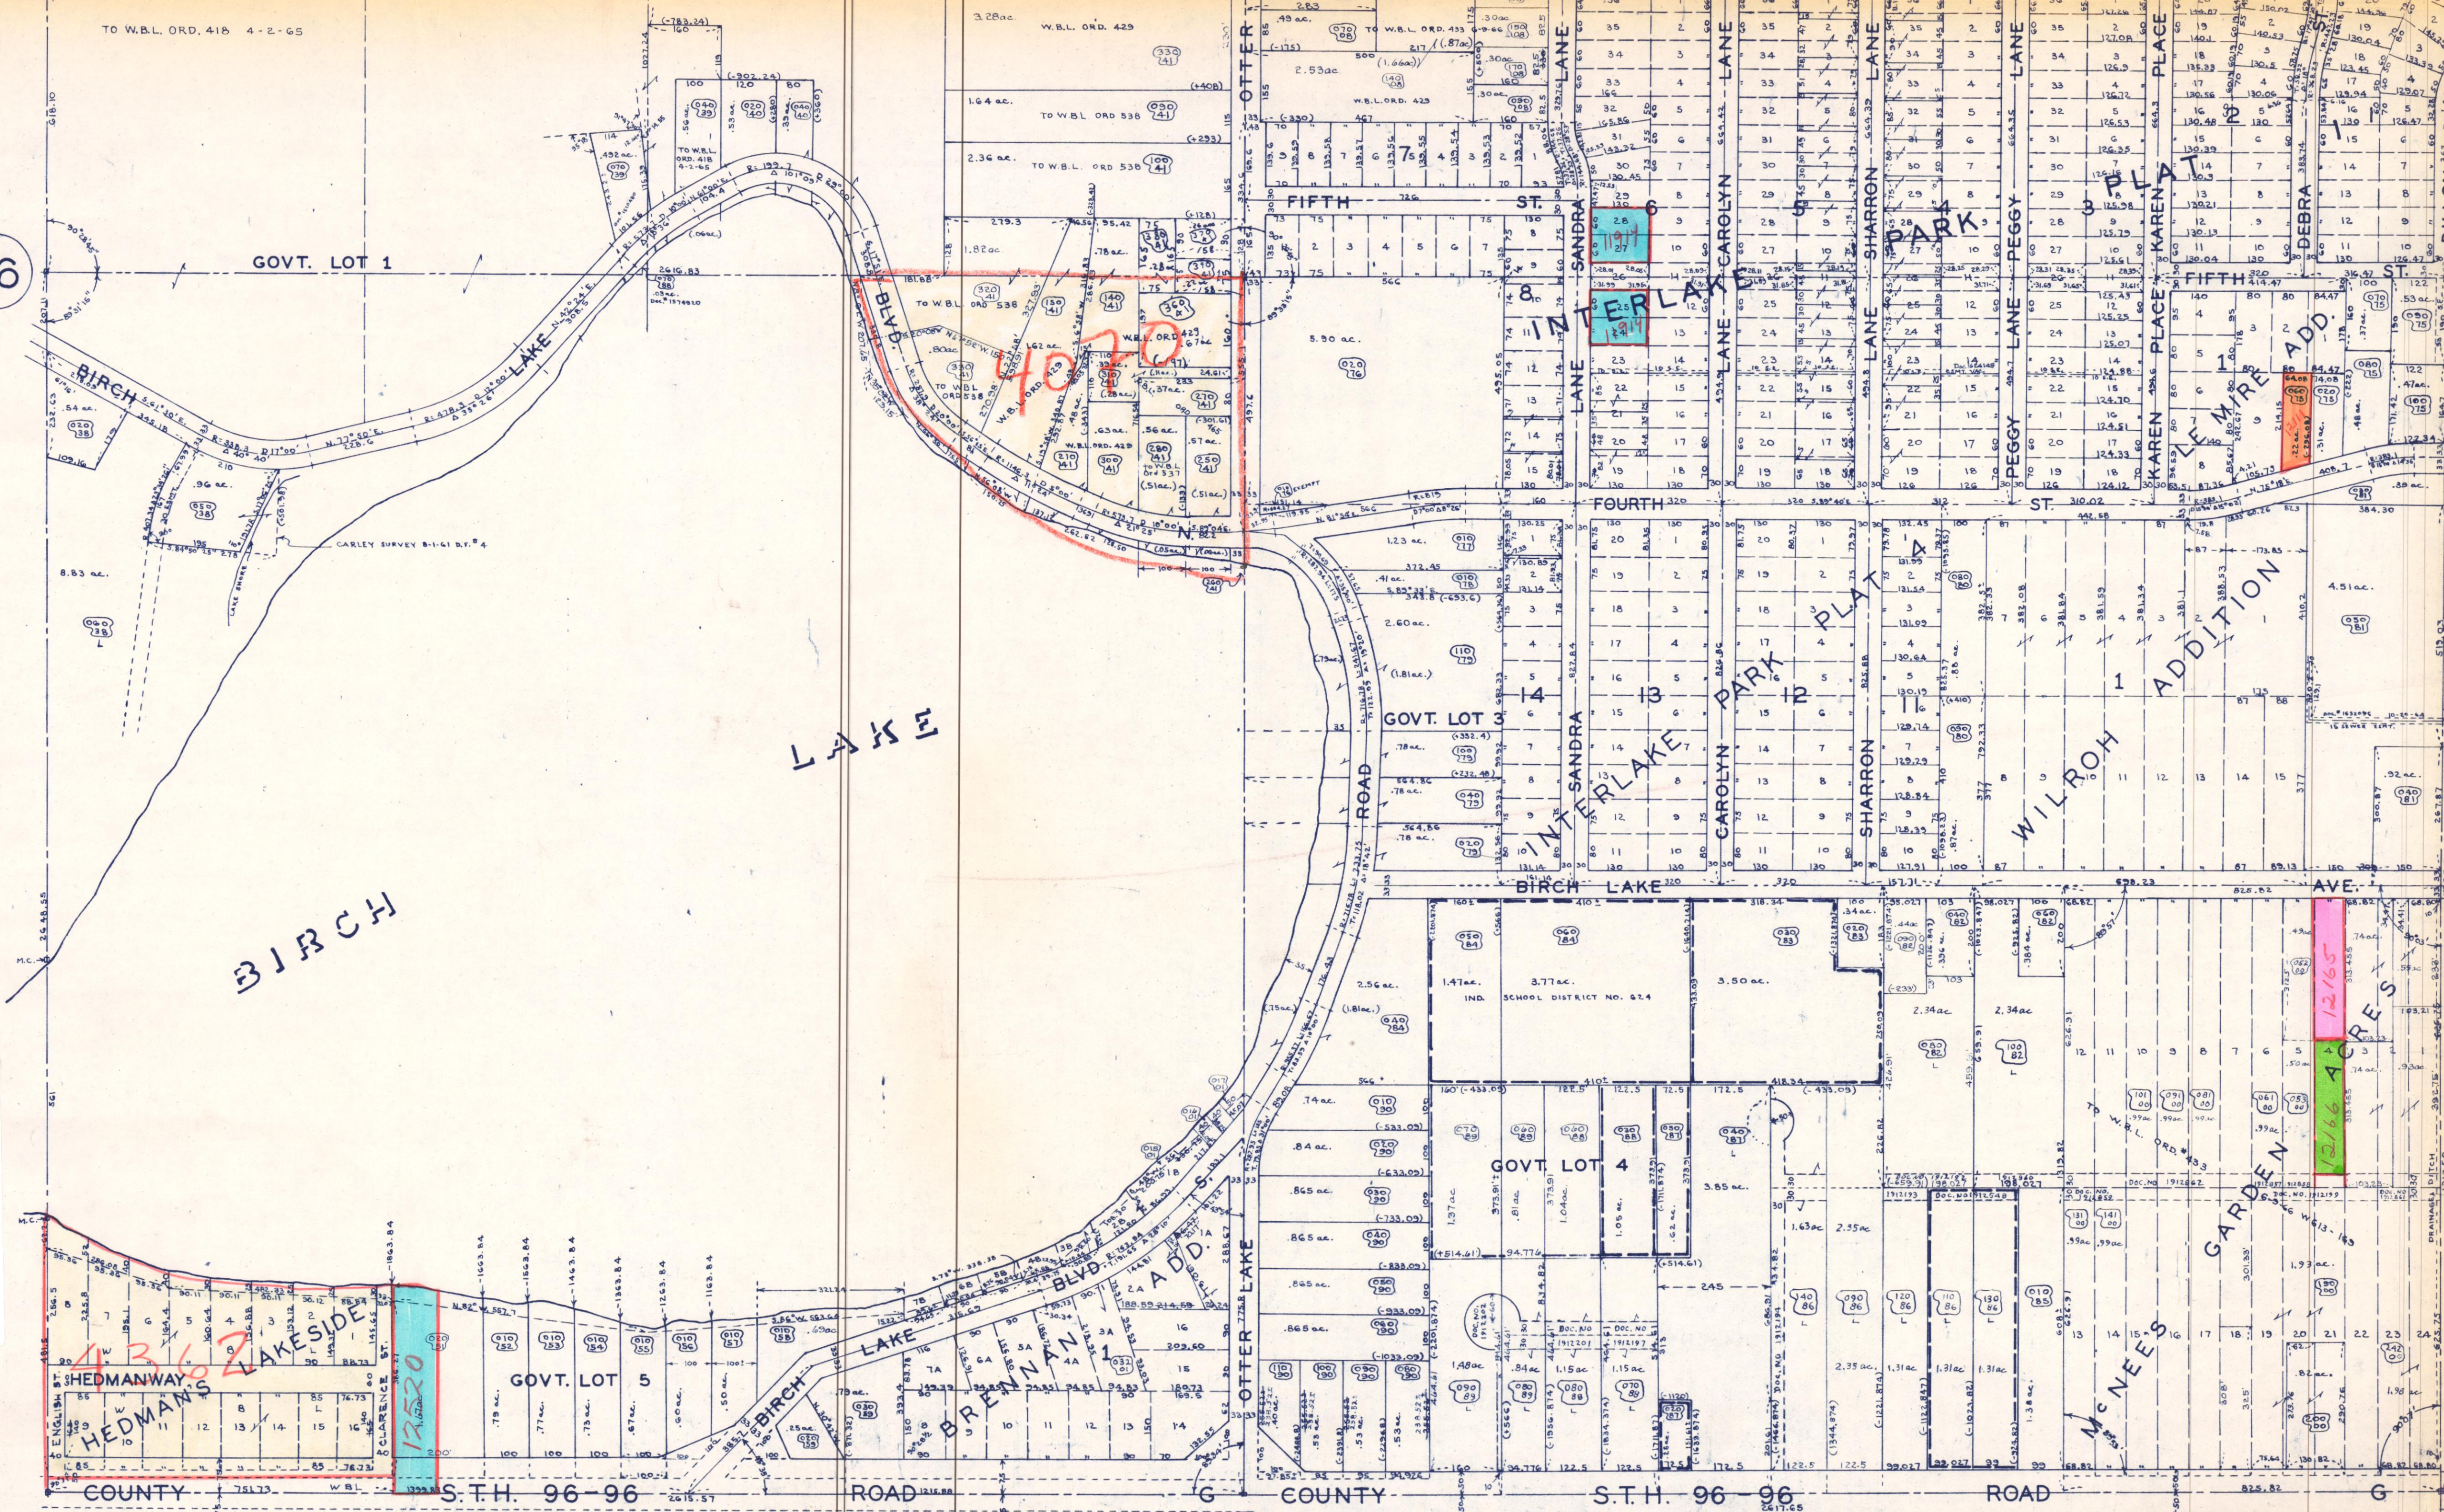

15-30-22
S1/2

15-30-22

22

SCALE 1" = 200'

AREAS & DIMENSIONS SUBJECT TO CHANGE

DEPARTMENT OF ASSESSOR
RAMSEY COUNTY
126 COURT HOUSE
R.G.G. 10-31-66

LAST CORR. 12-28-66