


17-29-22

S 1/2

18

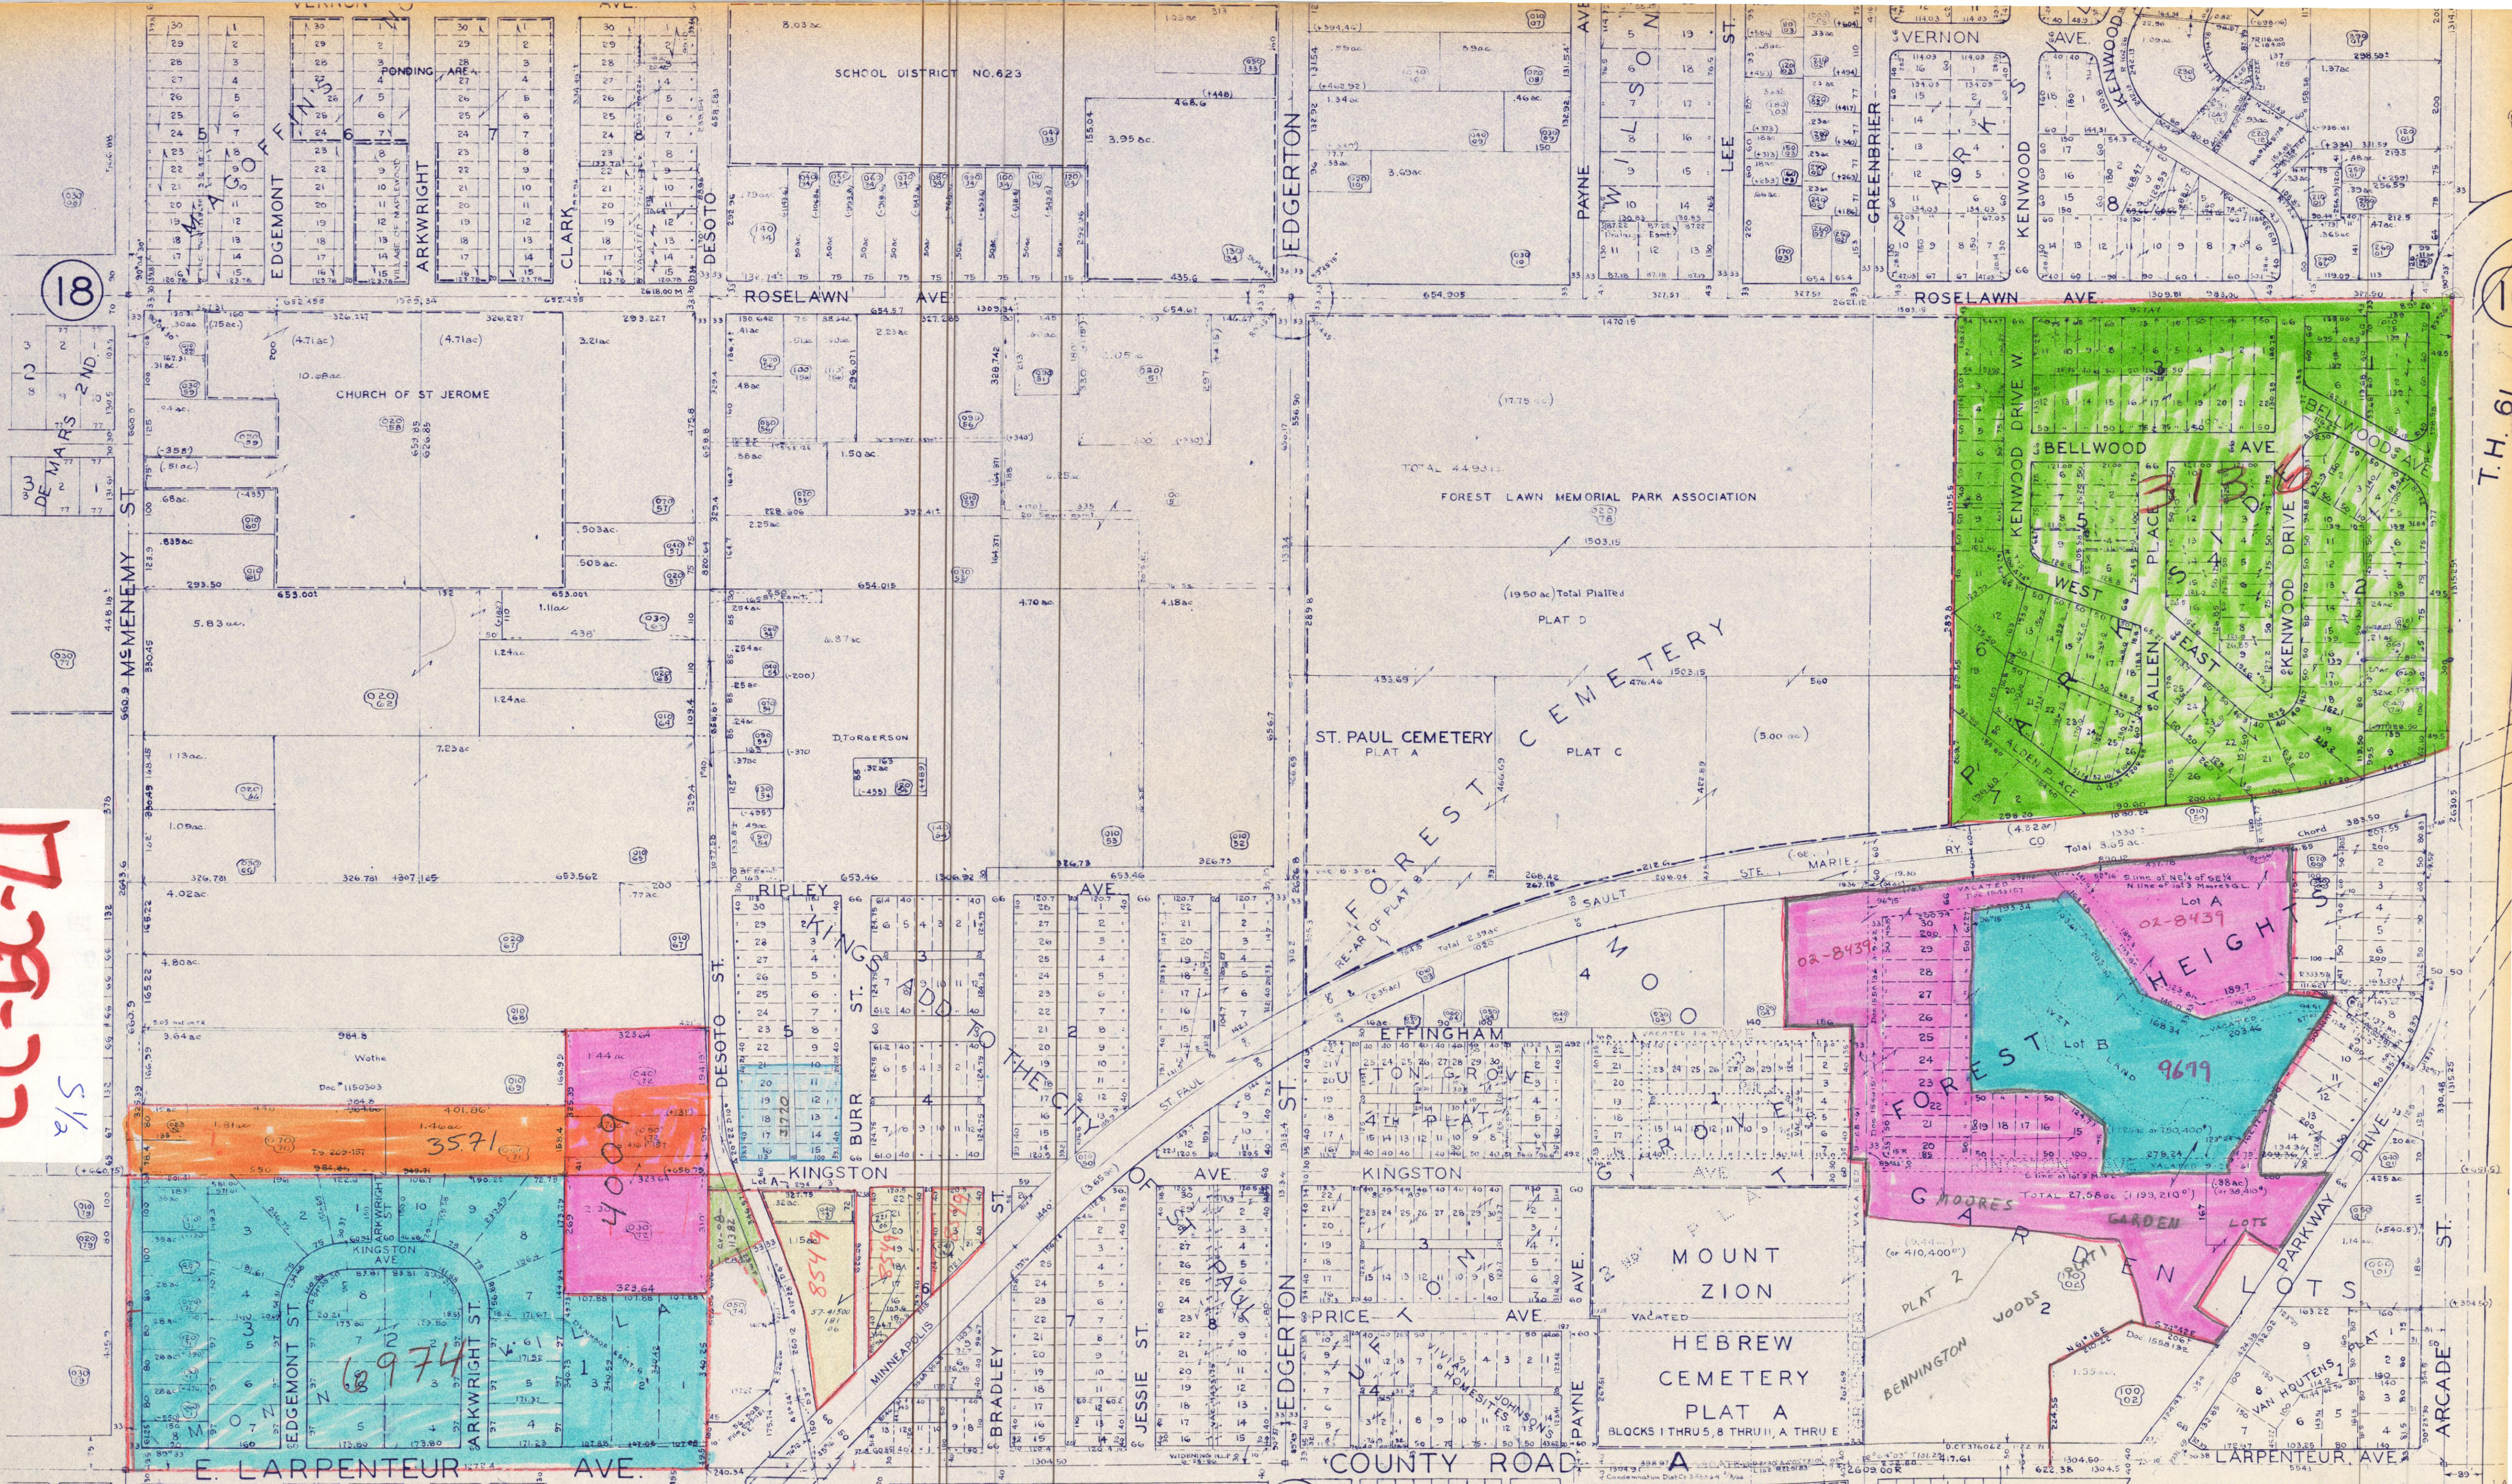

T.H. 61

20

JUNE 2 1961 W.H.R. SCALE 1"=200'
DEPARTMENT OF ASSESSOR
RAMSEY COUNTY MINNESOTA

17-29-22

AREAS & DIMENSIONS SUBJECT TO CHANGE