

22

2


23-30-23
5/8

23-30-23

26

AREAS & DEMENSIONS SUBJECT TO CHANGE

DEPARTMENT OF ASSESSOR
RAMSEY COUNTY
12-8-66
LAST COR: 2-21-73

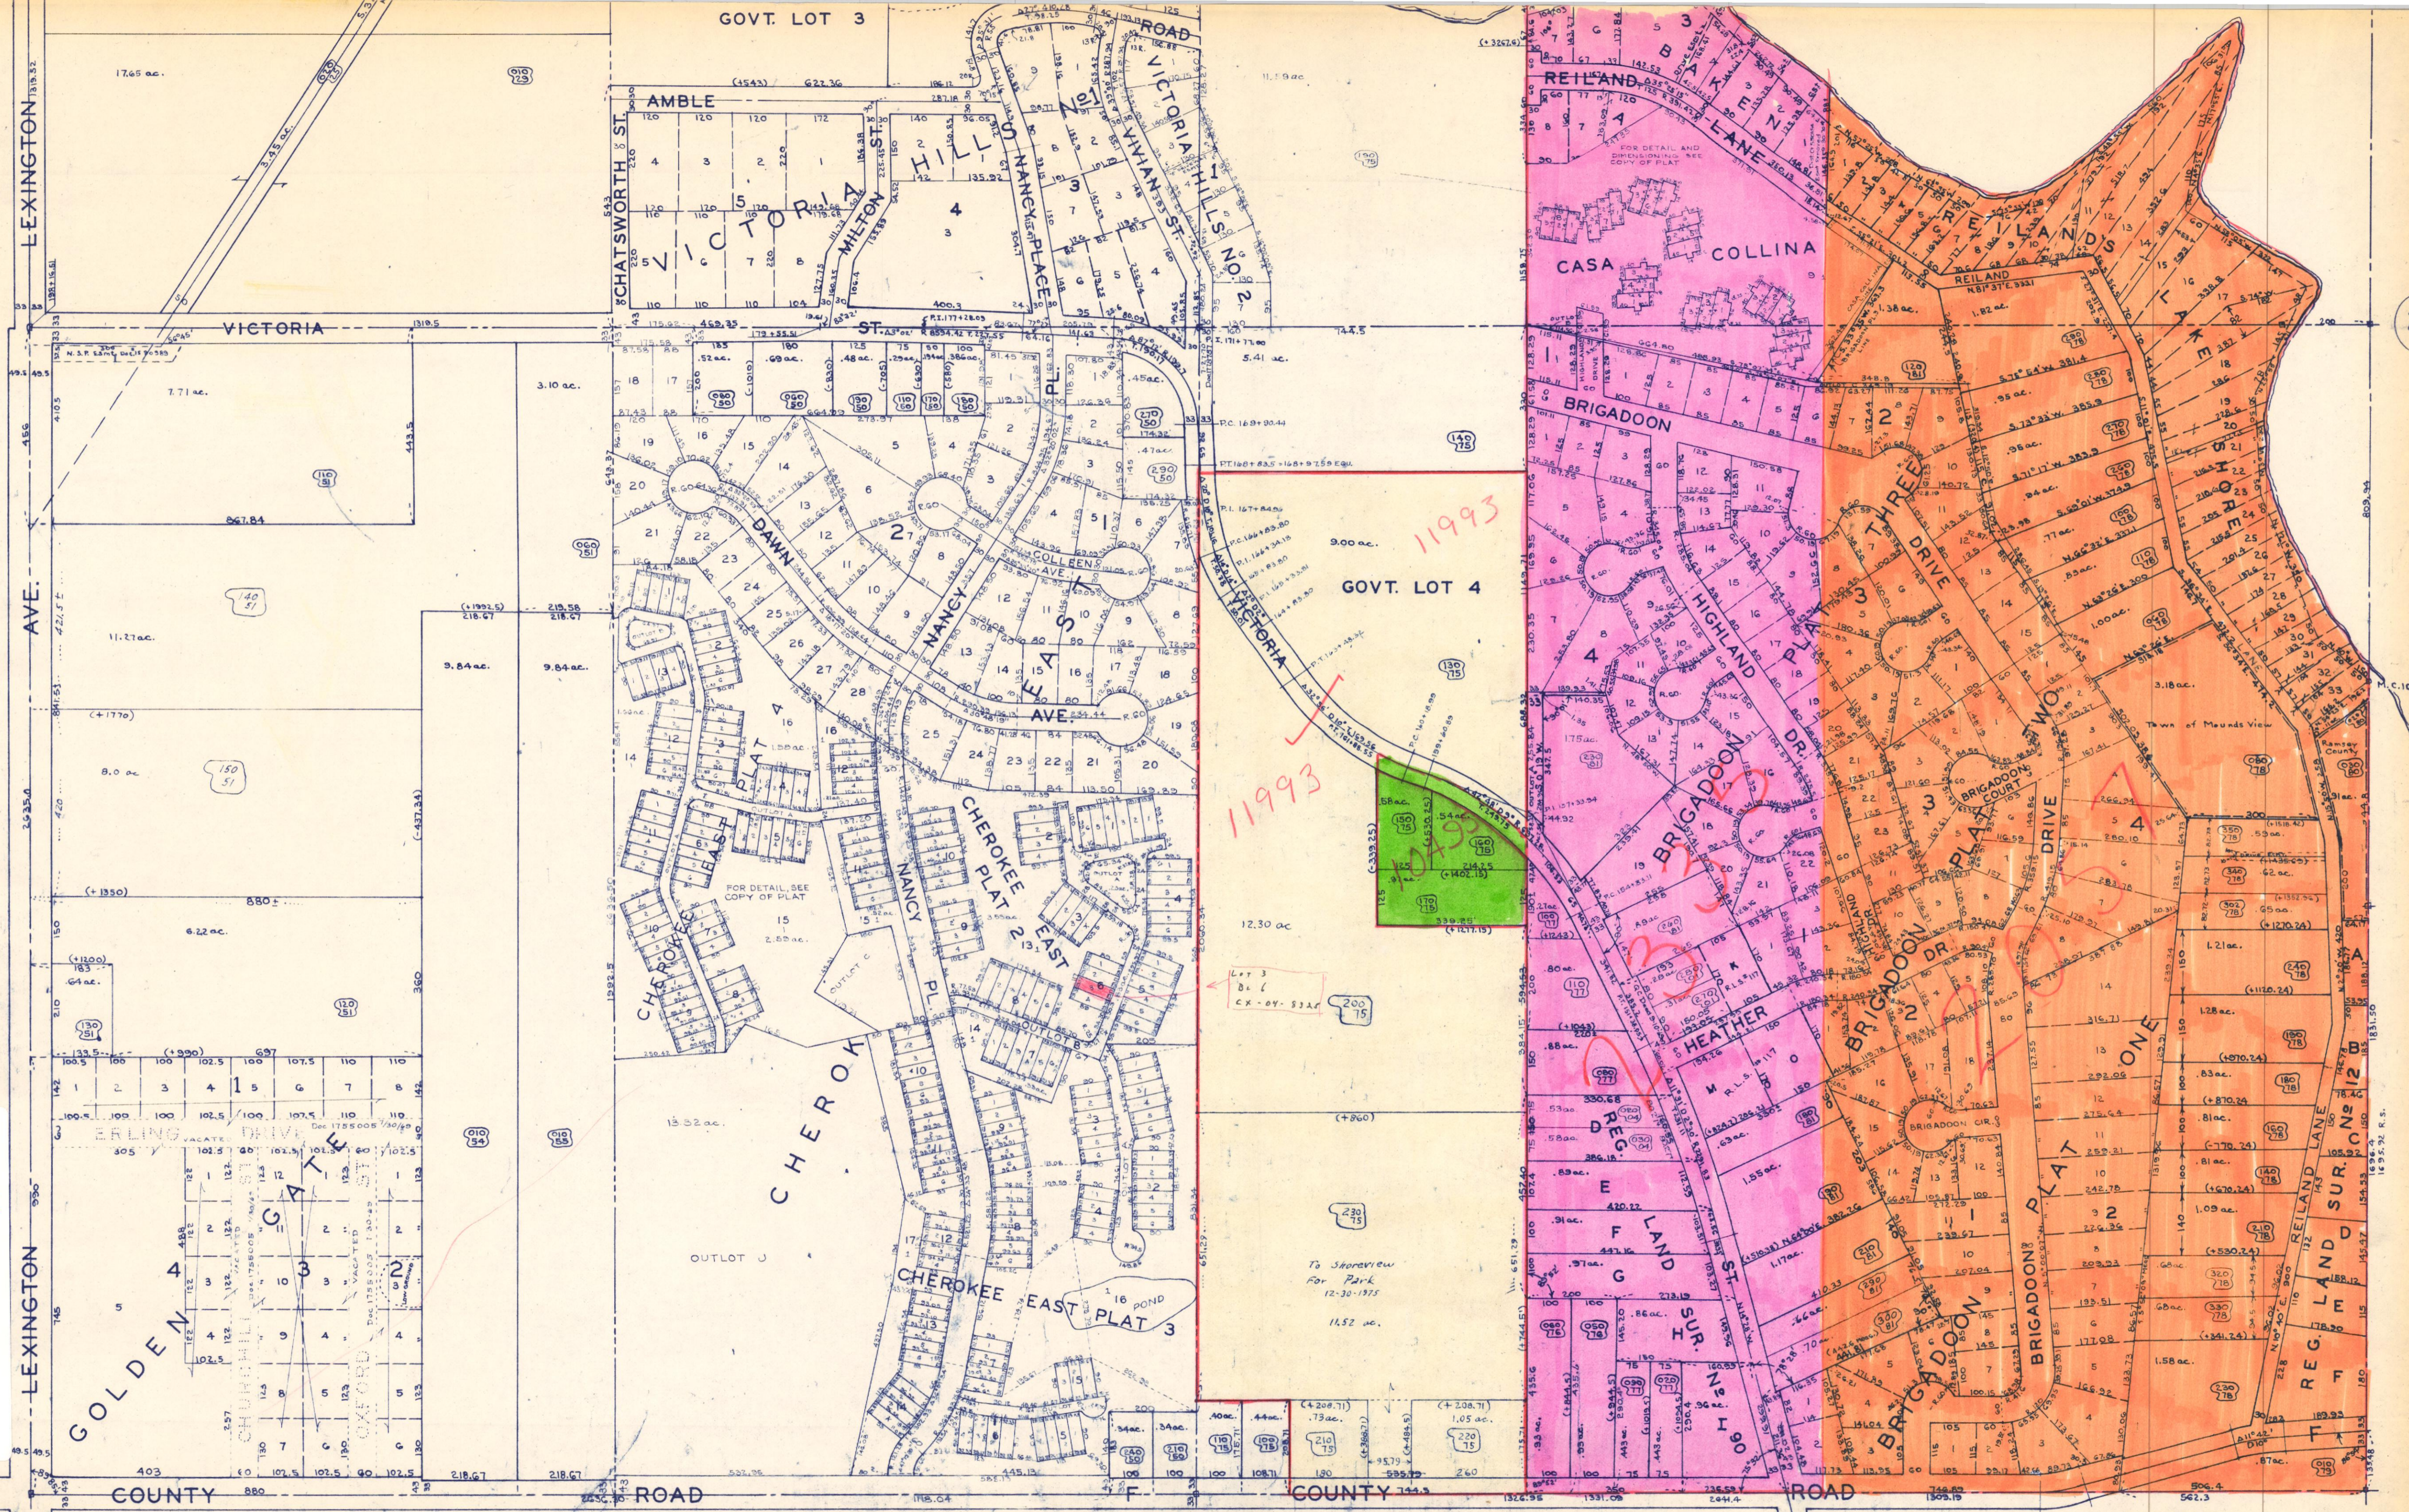

11993

11993

200 15

To Shareview
for Park
12-30-1975
11.52 ac.