


9-30-22
MKS

8

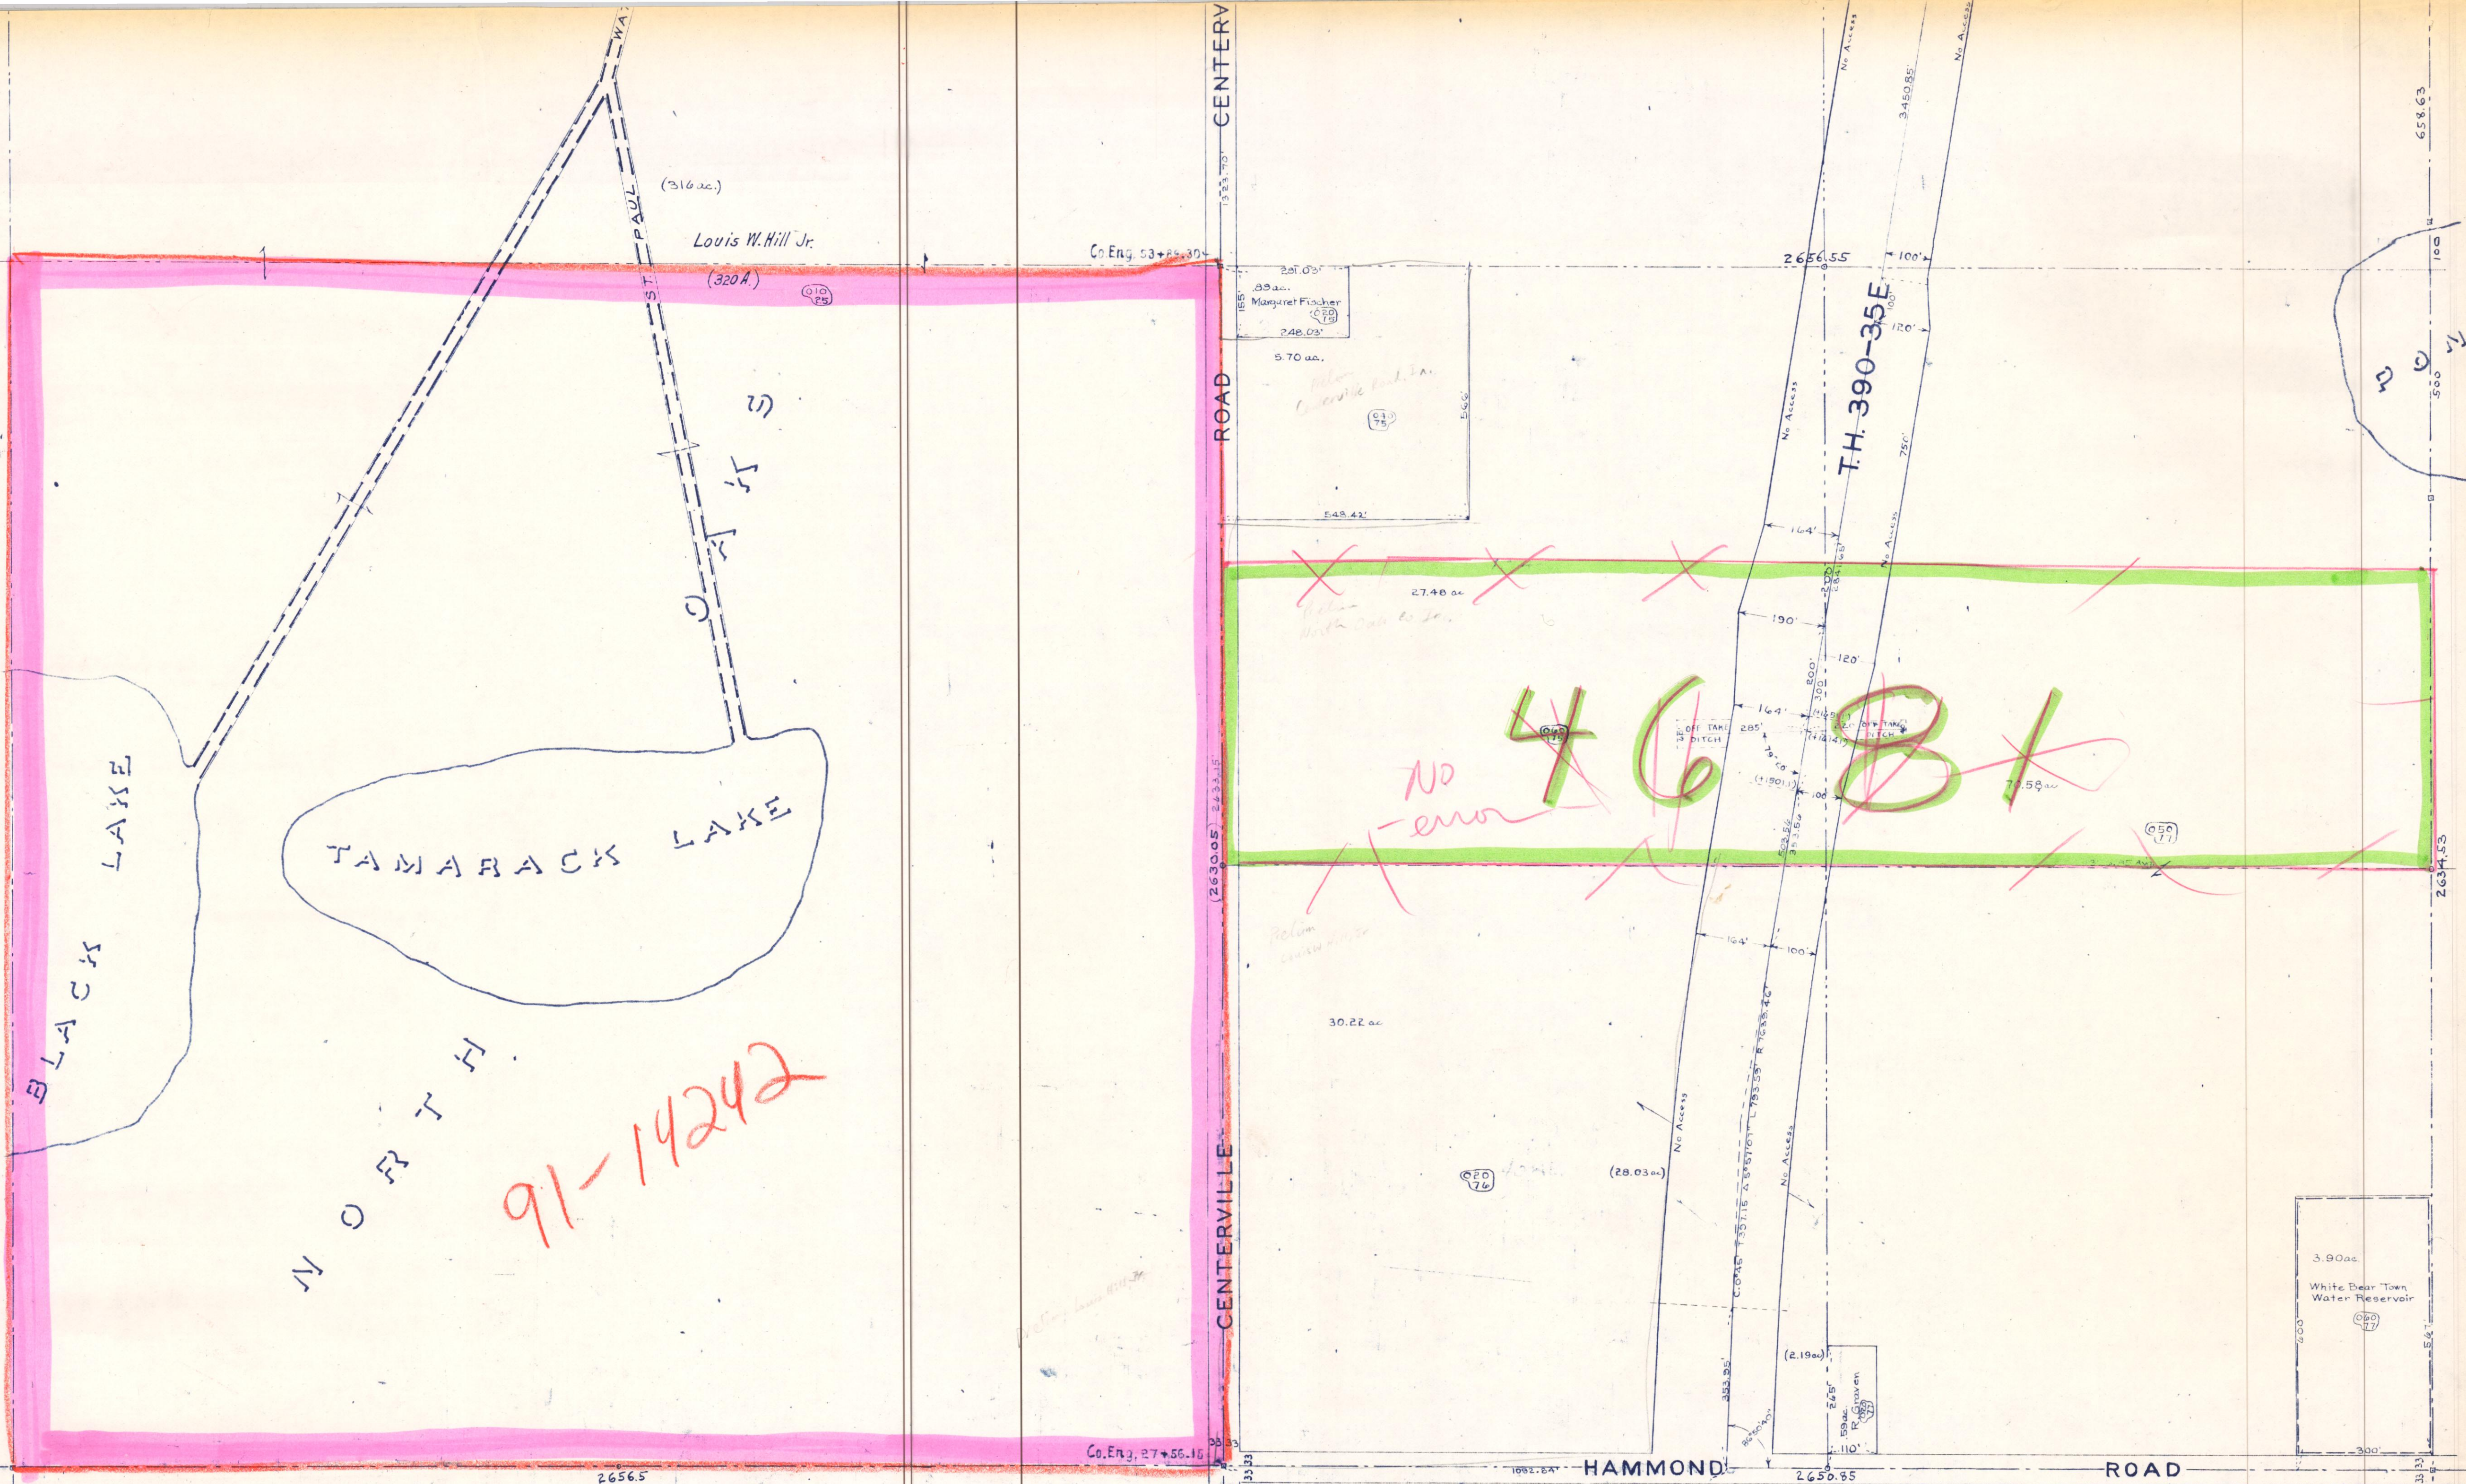

91-14242

4681

NO error

9-30-22
COUNTY ASSESSOR'S OFFICE

AREA & DIMENSIONS SUBJECT TO CHANGE

16

Last Cor. 4 TOLPH
10-28-11 R.G.
9-5-78 E.H.
6-6-74