


N. E. 1/4 Sec. 14 — 28-22

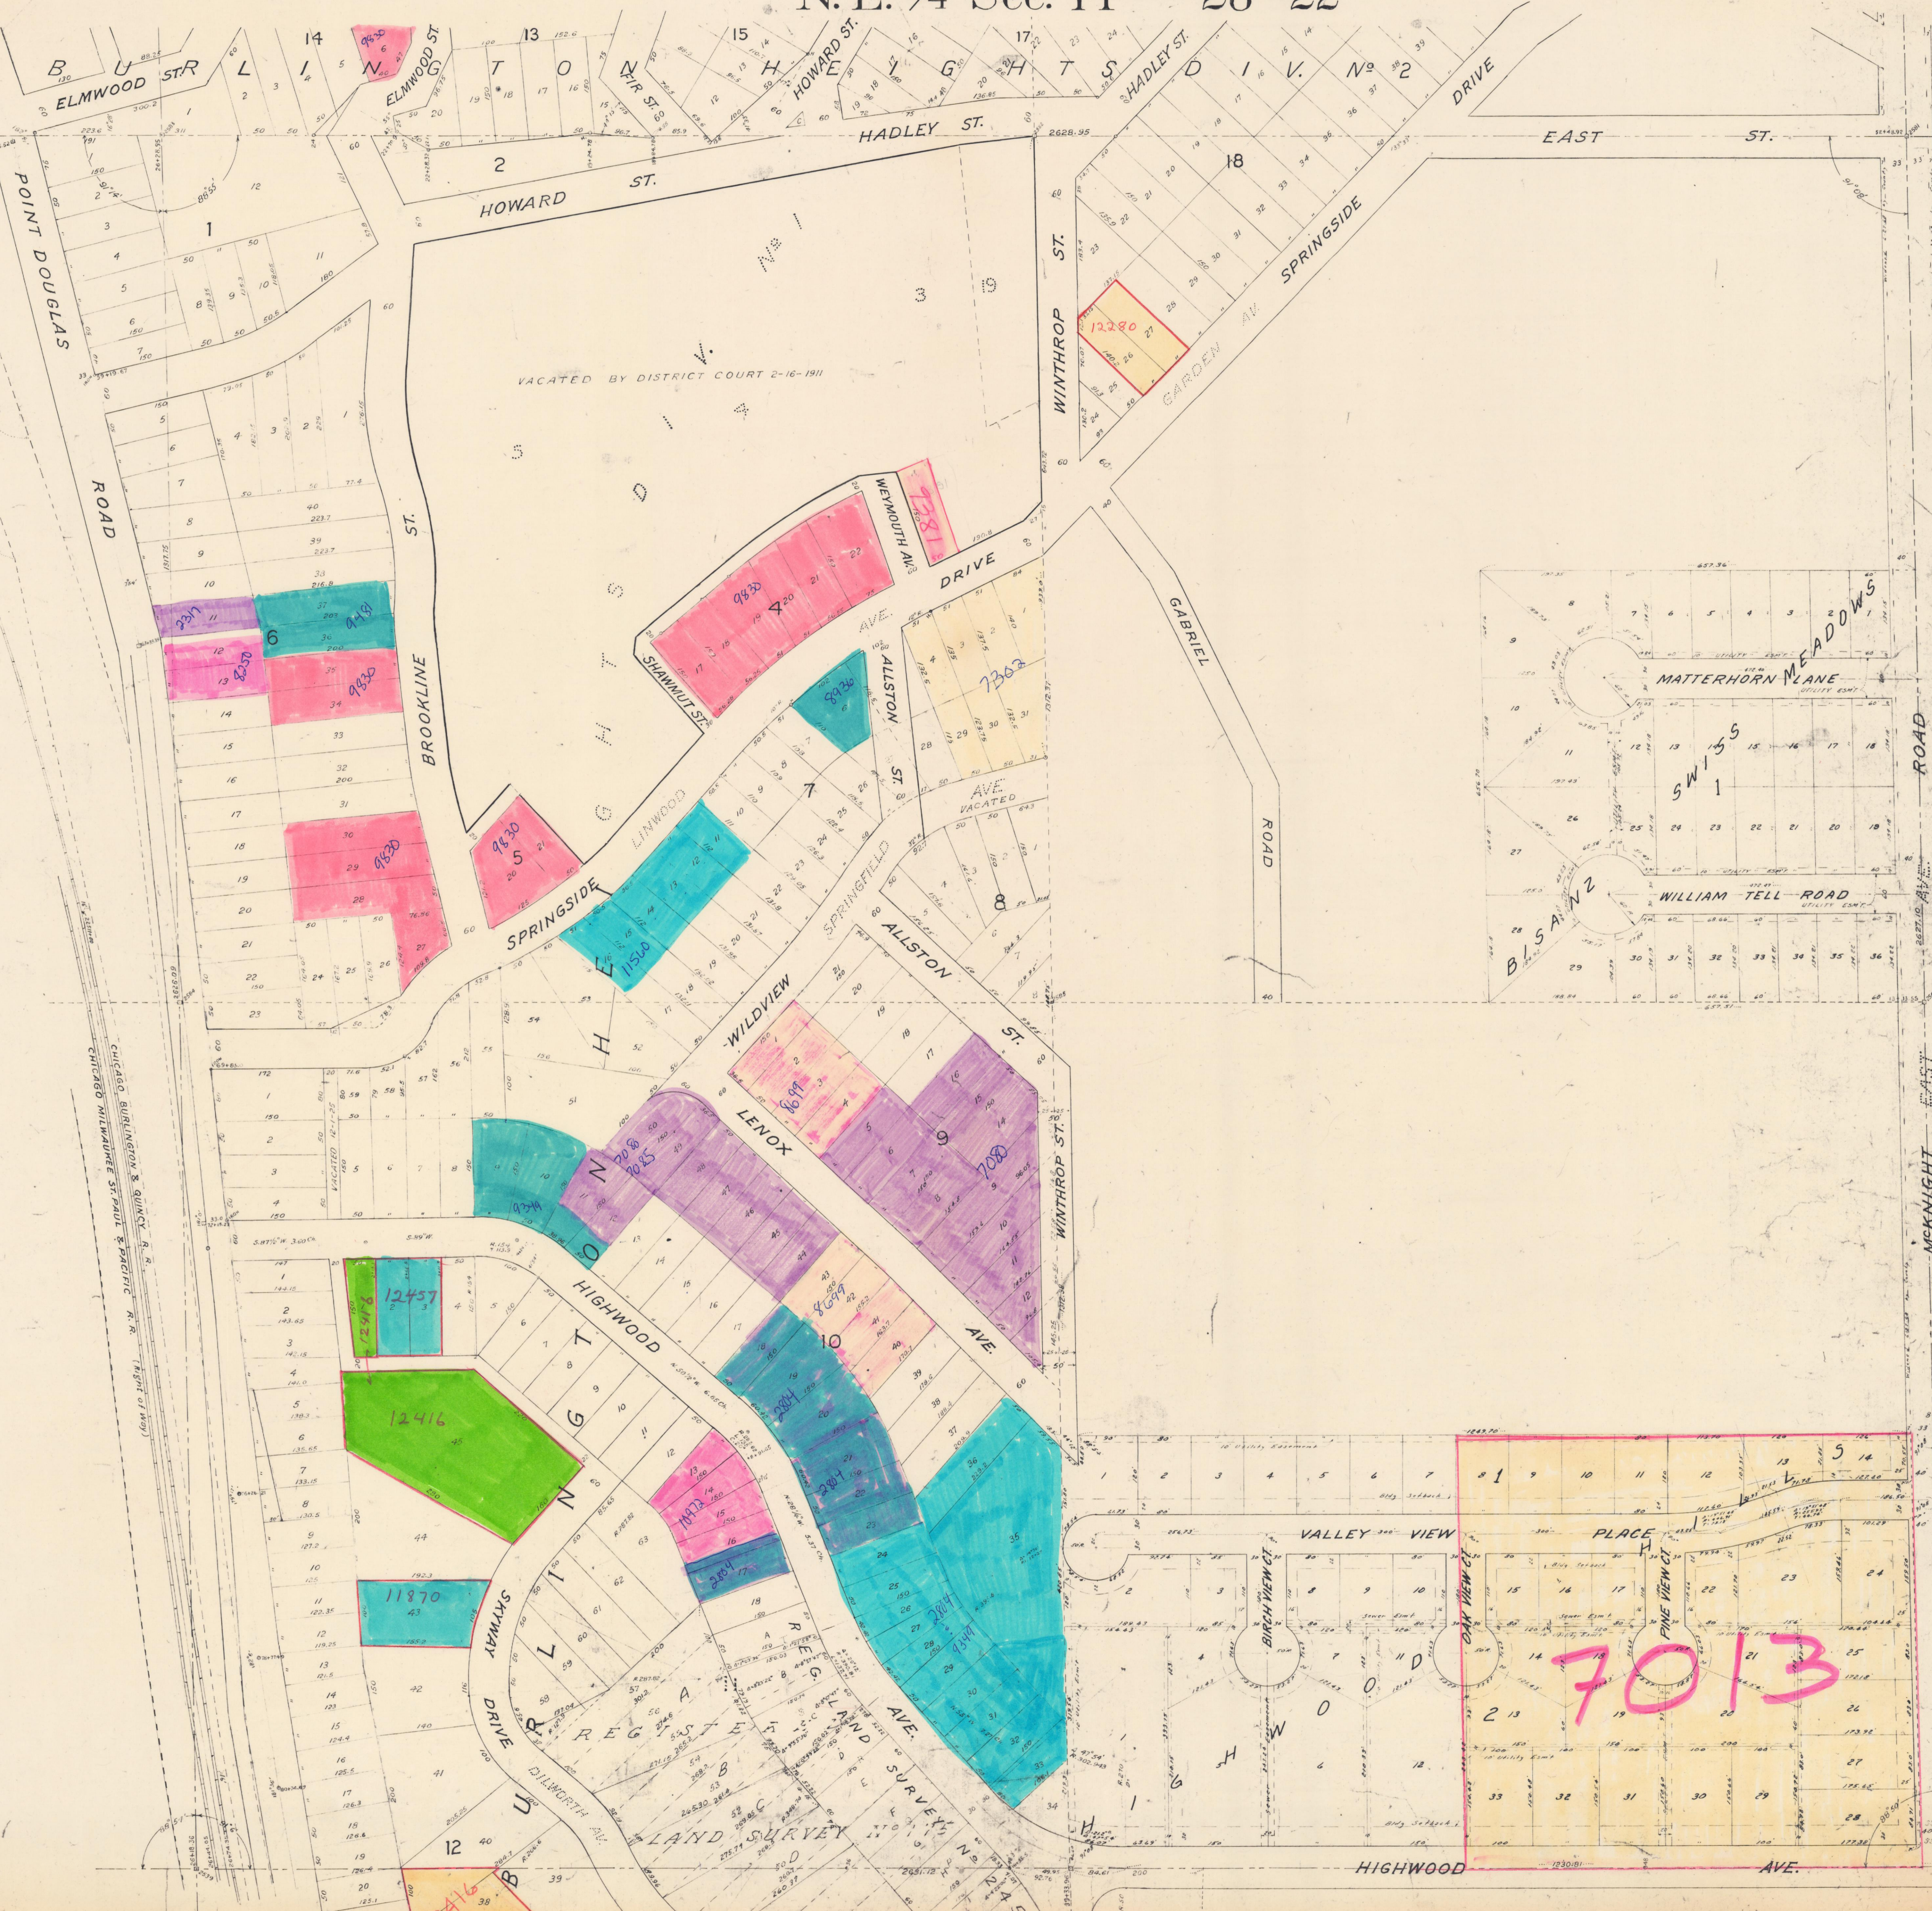

N.E. 1/4
14-28-22

7013