


N. E. 1/4 Sec. 23—29—22

BACCHUS			
(4)	(5)	(6)	(7)
LARPENTEUR			
1	2	3	4
WOODS			

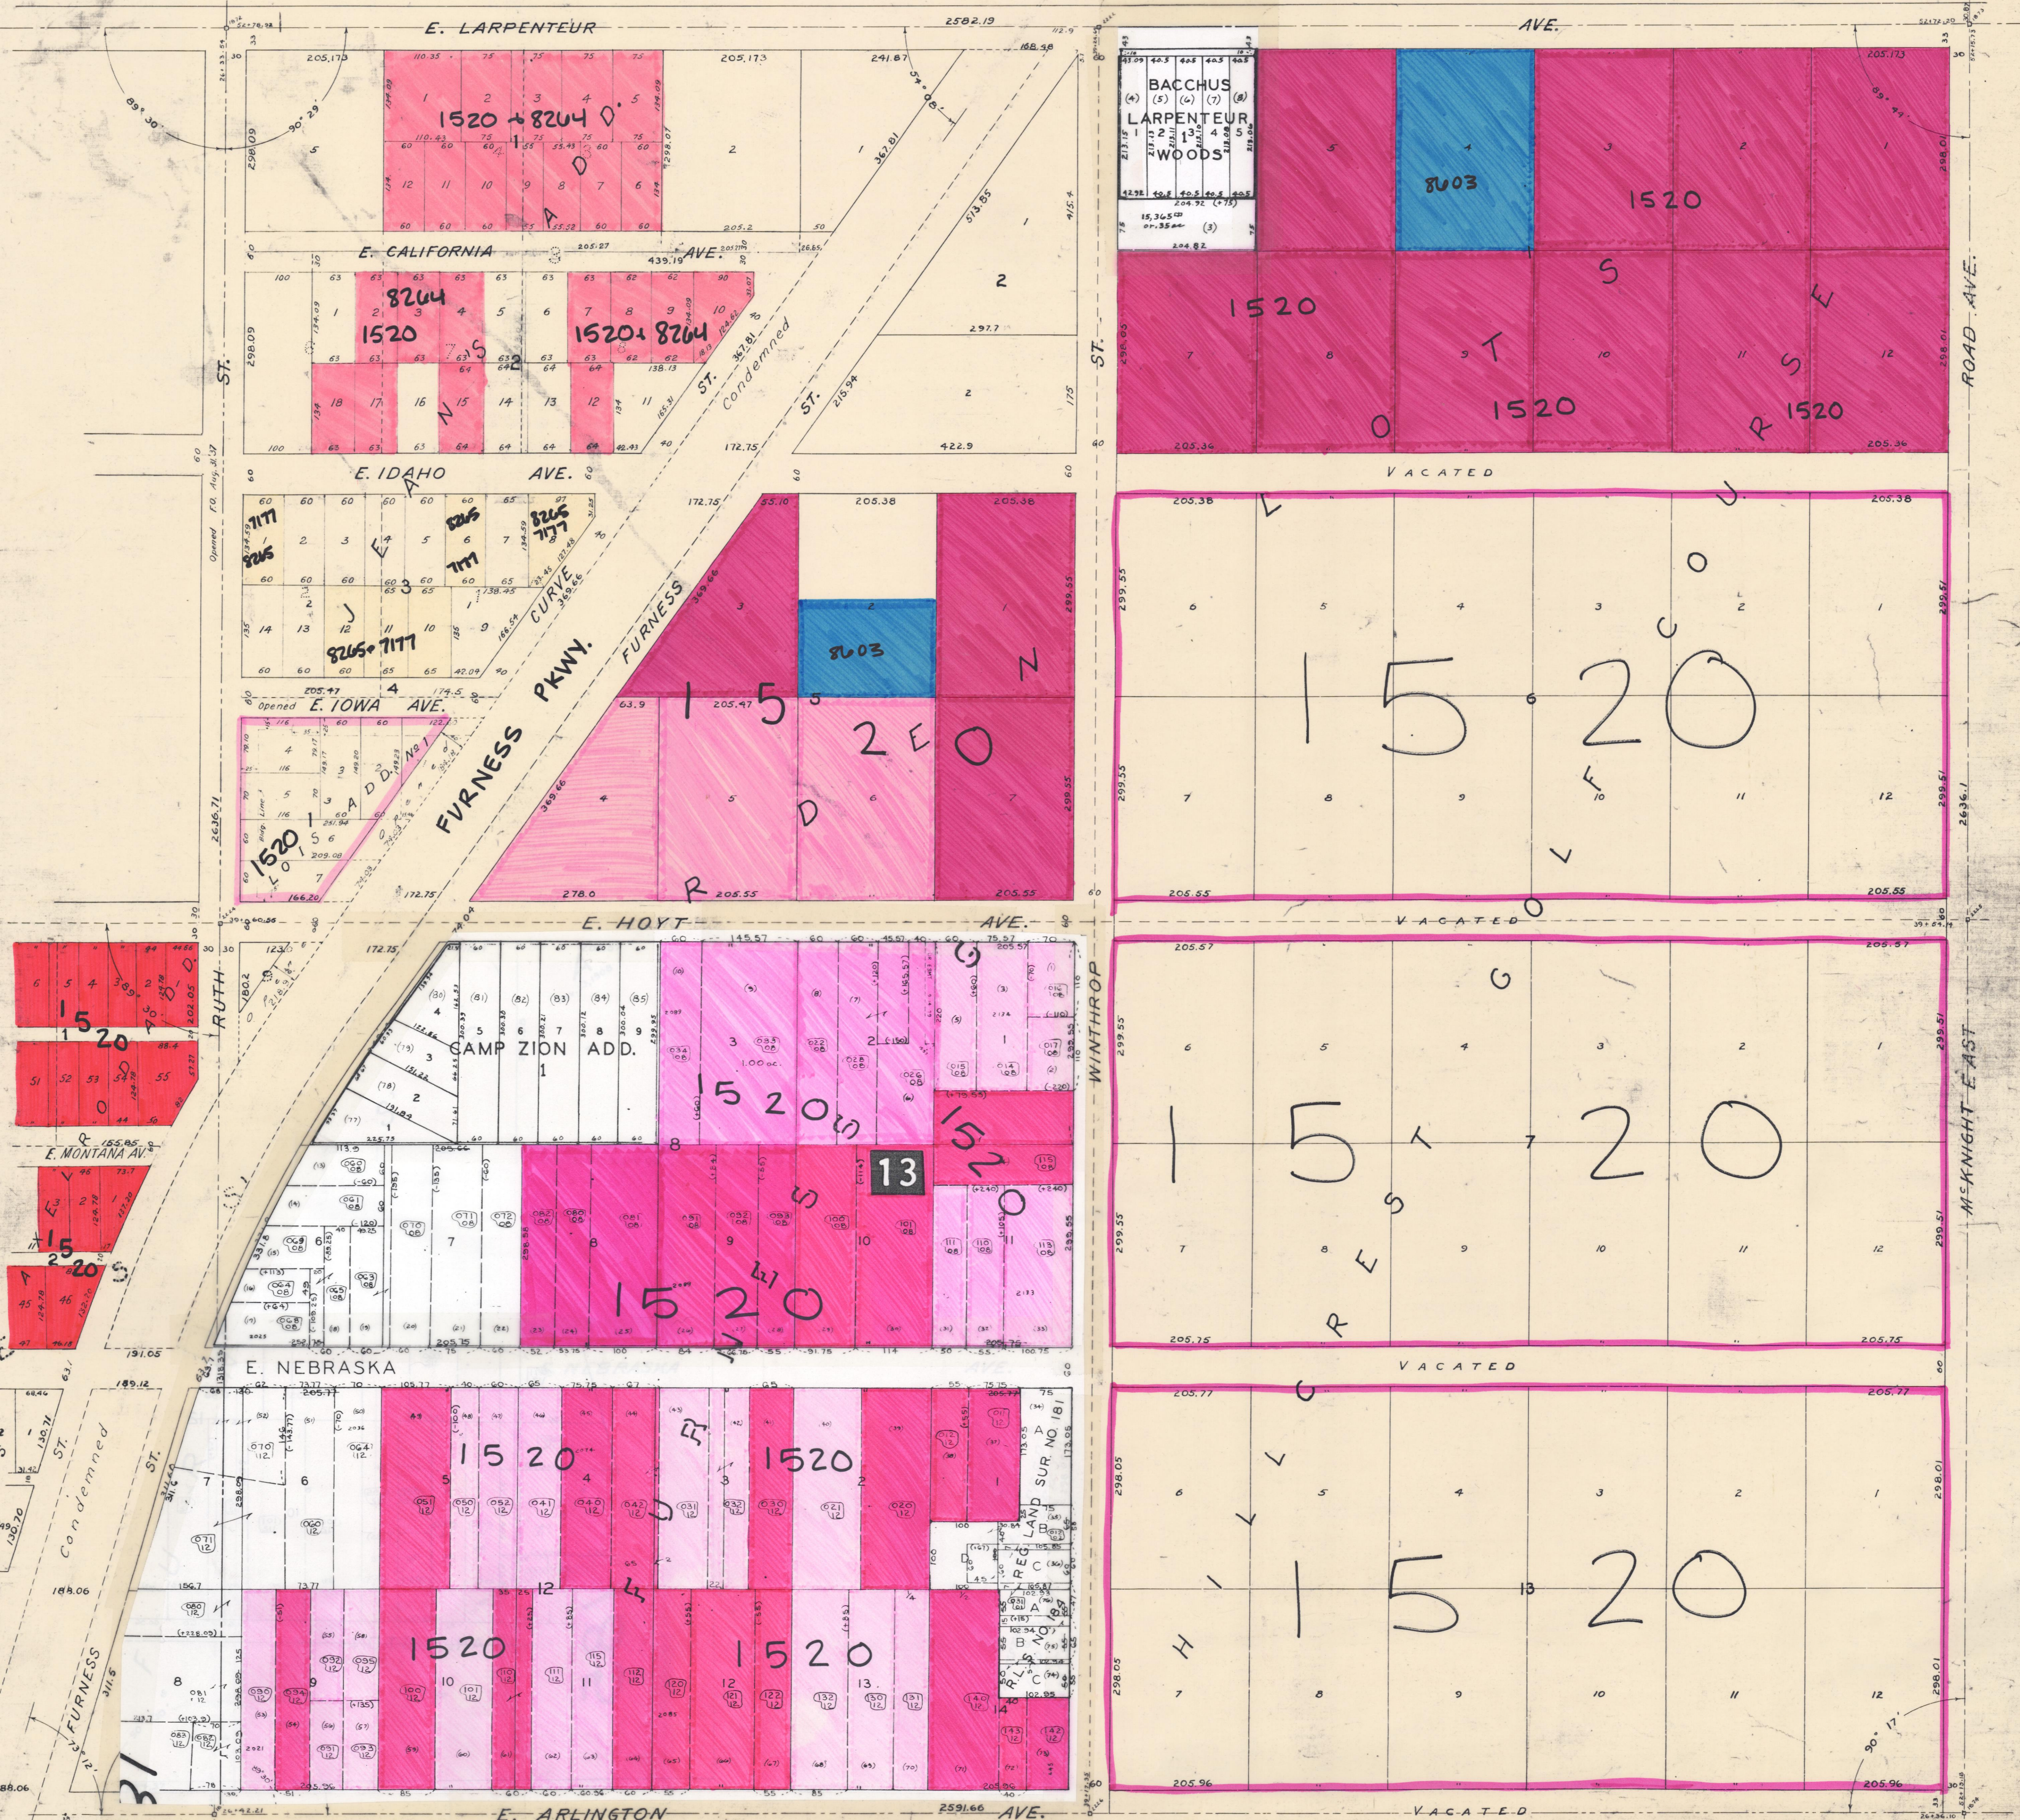

N.E. 1/4 23-29-22