


N. E. 1/4 Sec. 23—29—23

*N. Victoria NE 1/4 23-29-23*

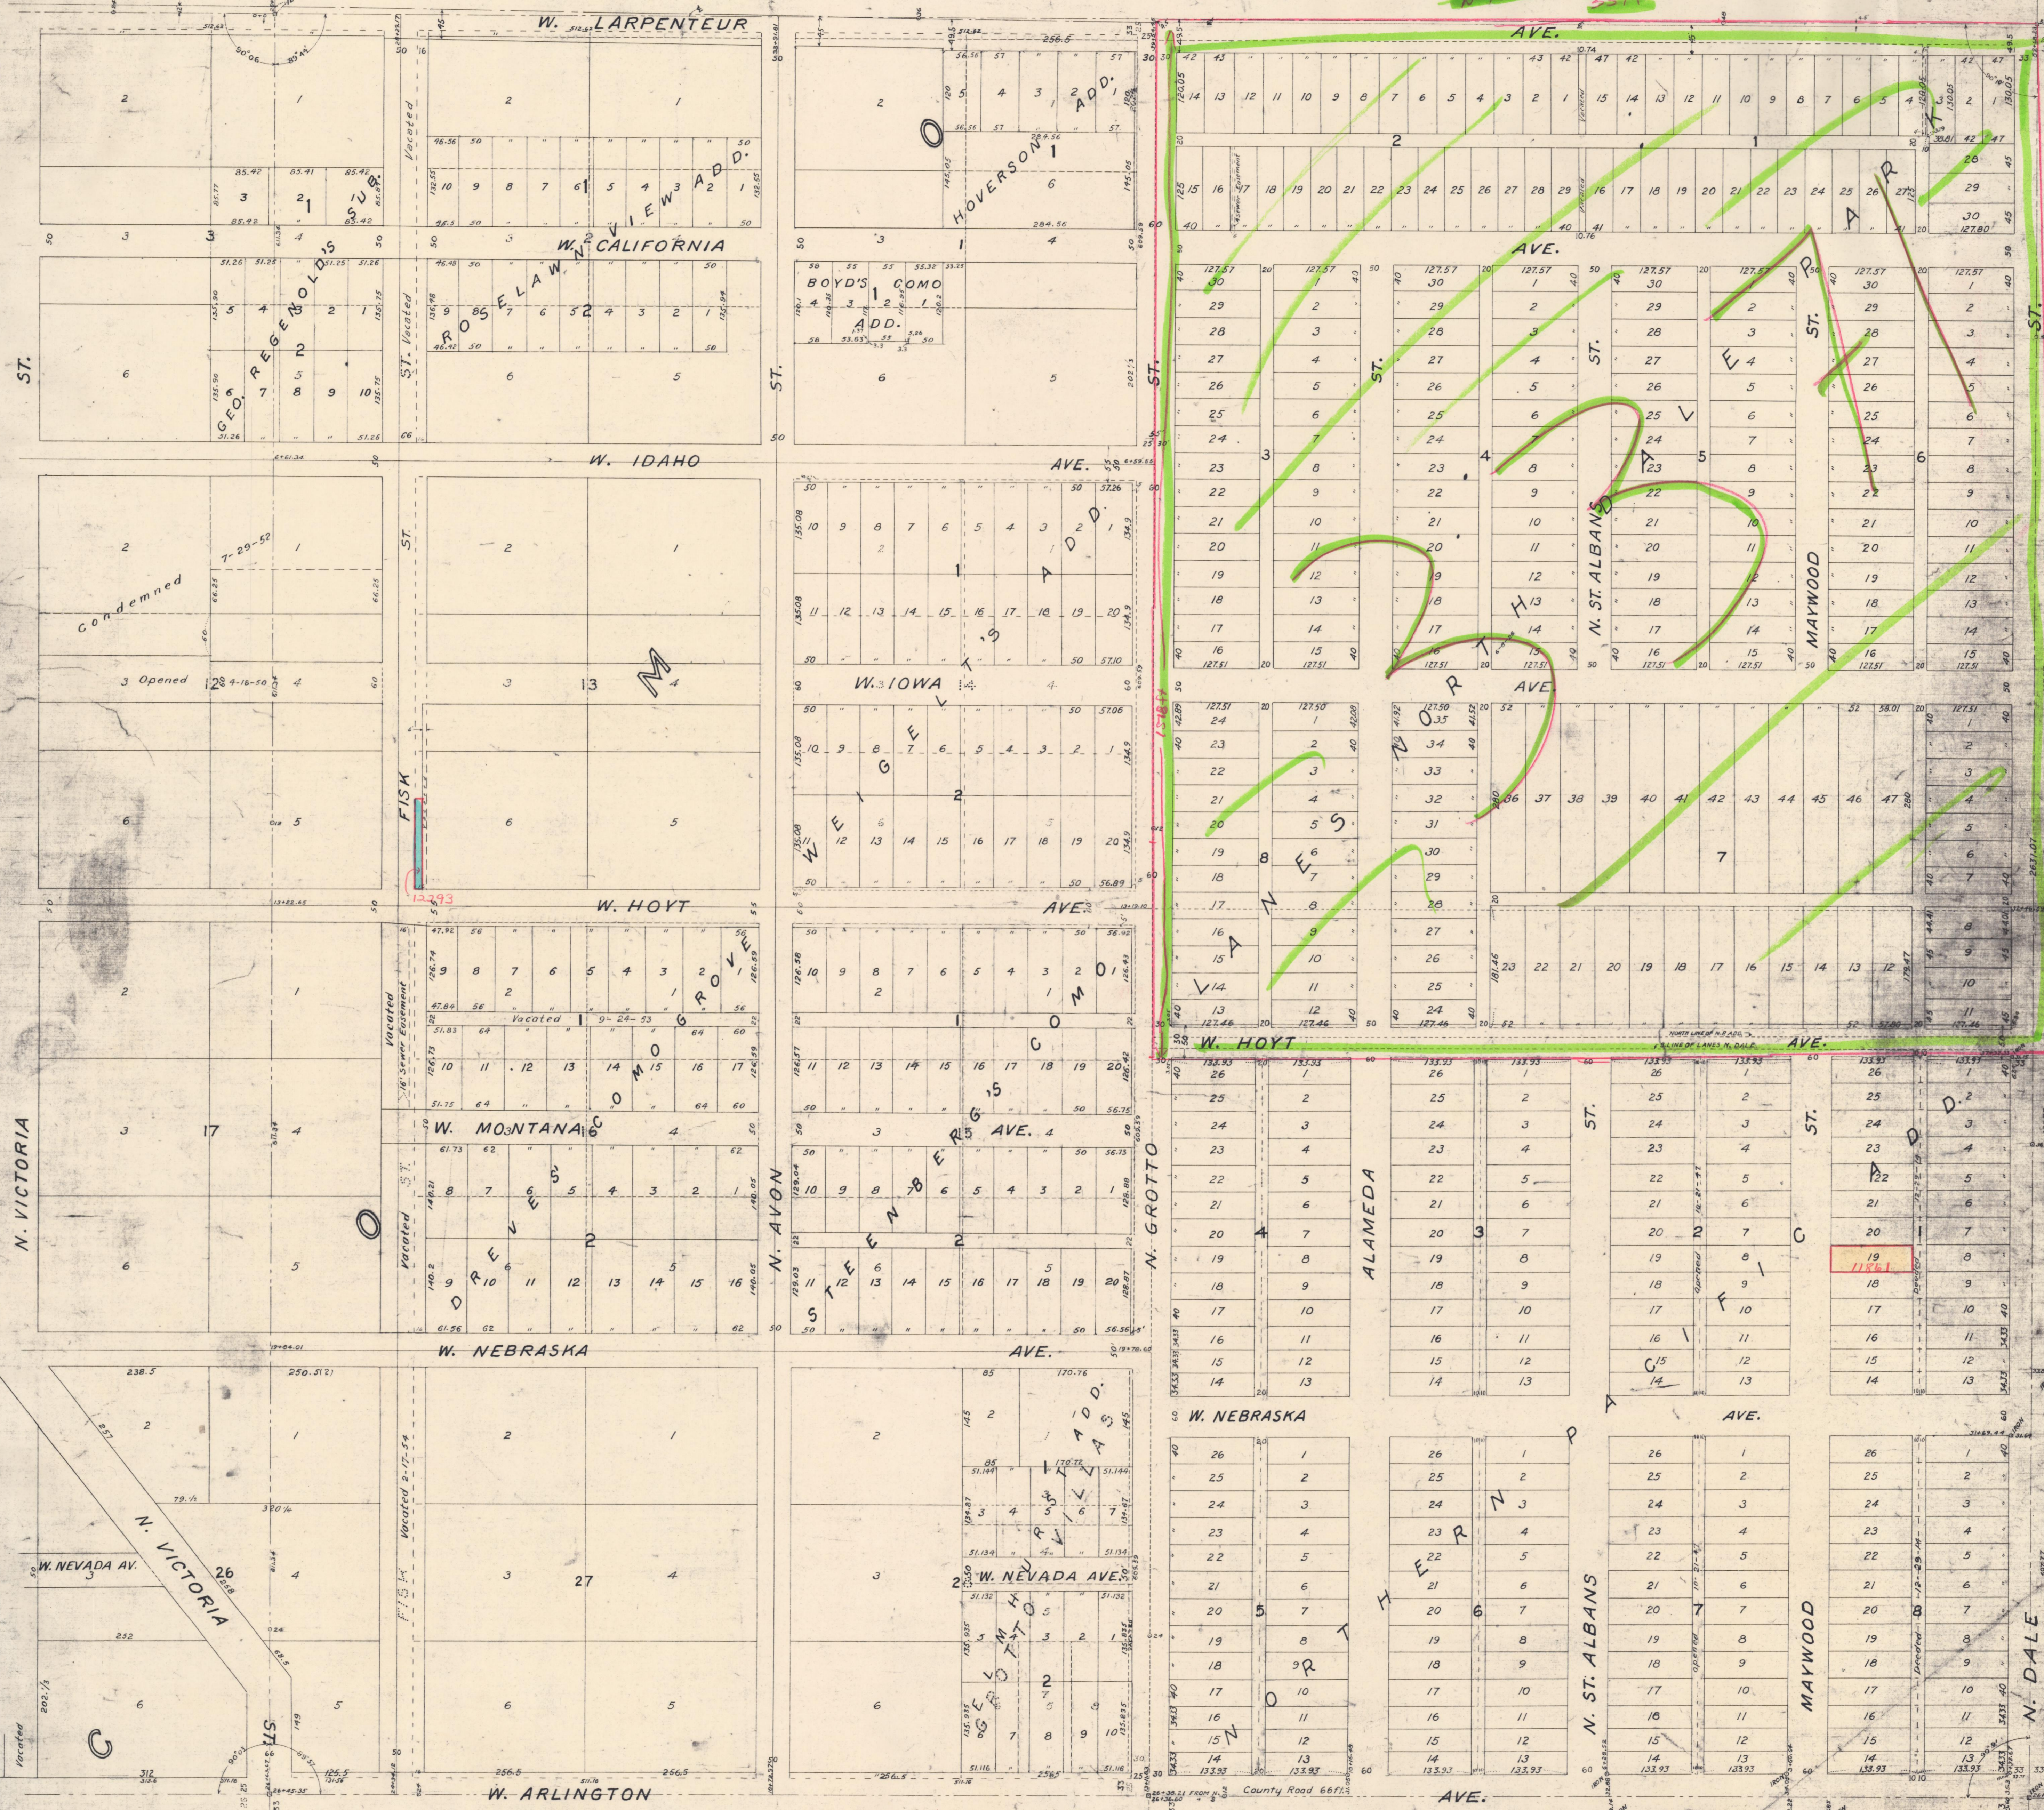

*NE 1/4 23-29-23*



