


N.E. 1/4 Sec. 25-29, 23

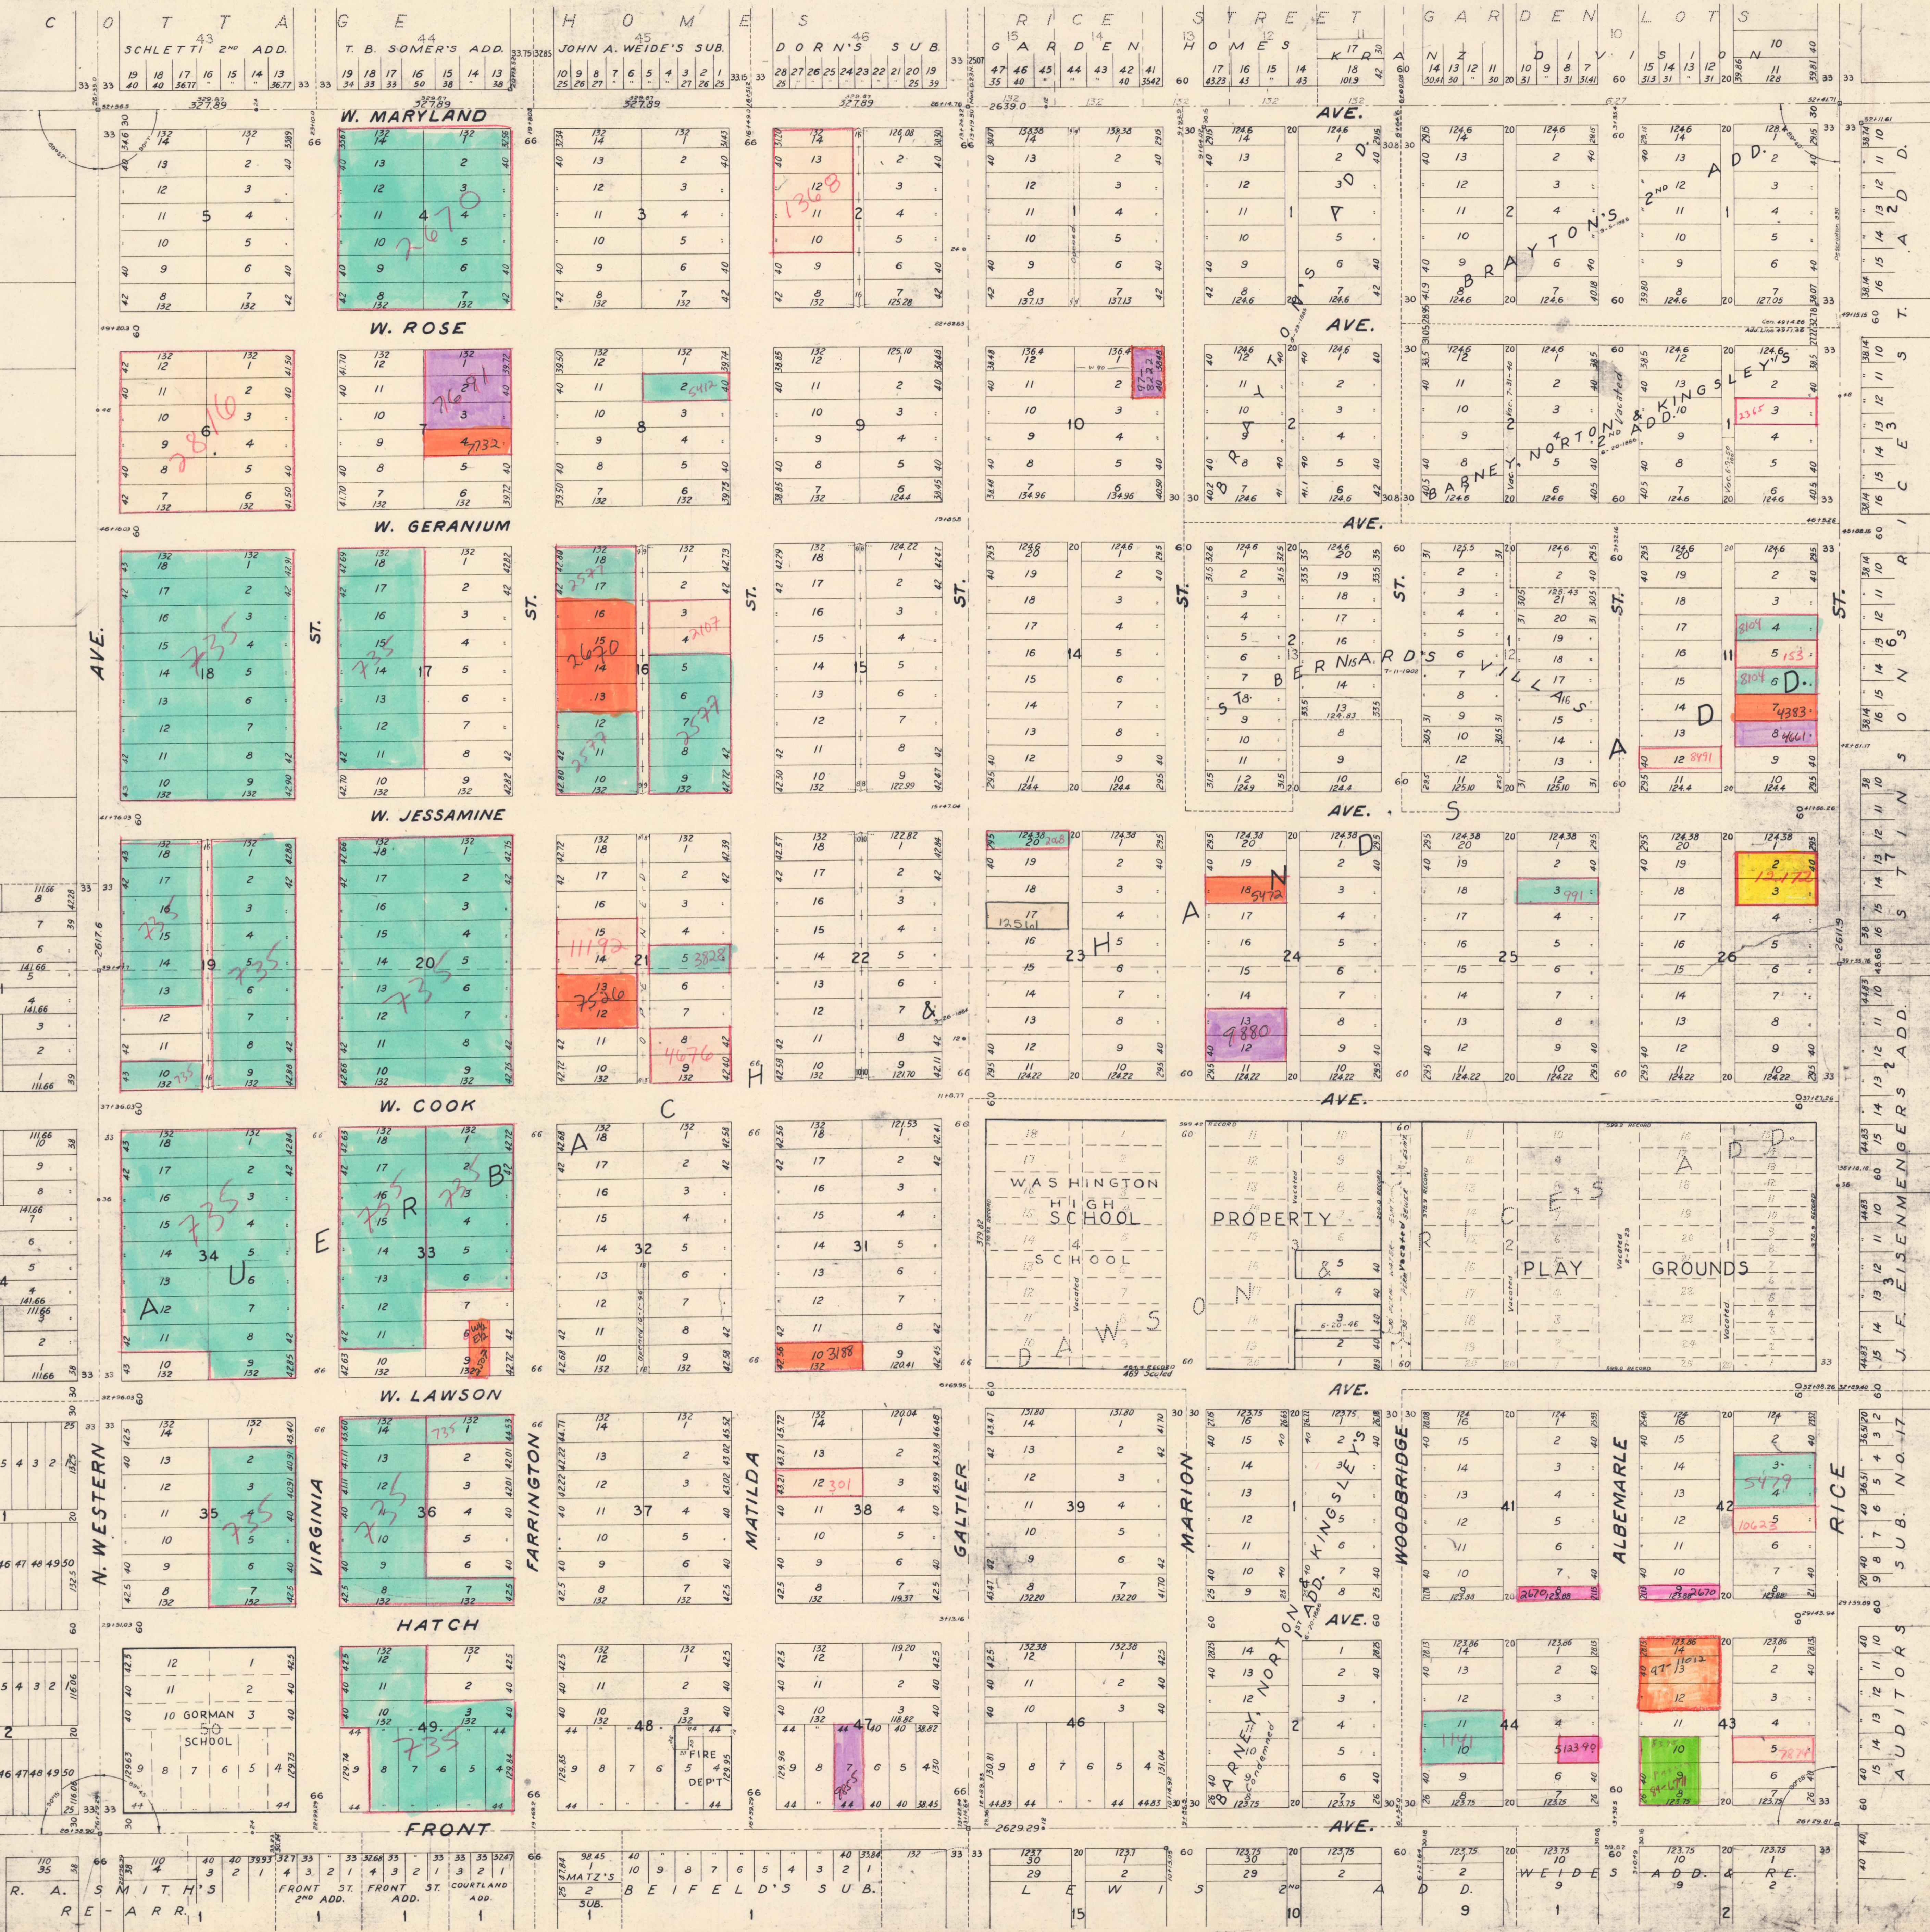

NE 1/4 25-29-23


RICE SUB. NO. 17

AUDITORS