


N.E. 1/4 SEC. 30, 29-22.

H G W B A S S G A R D E N L O T S

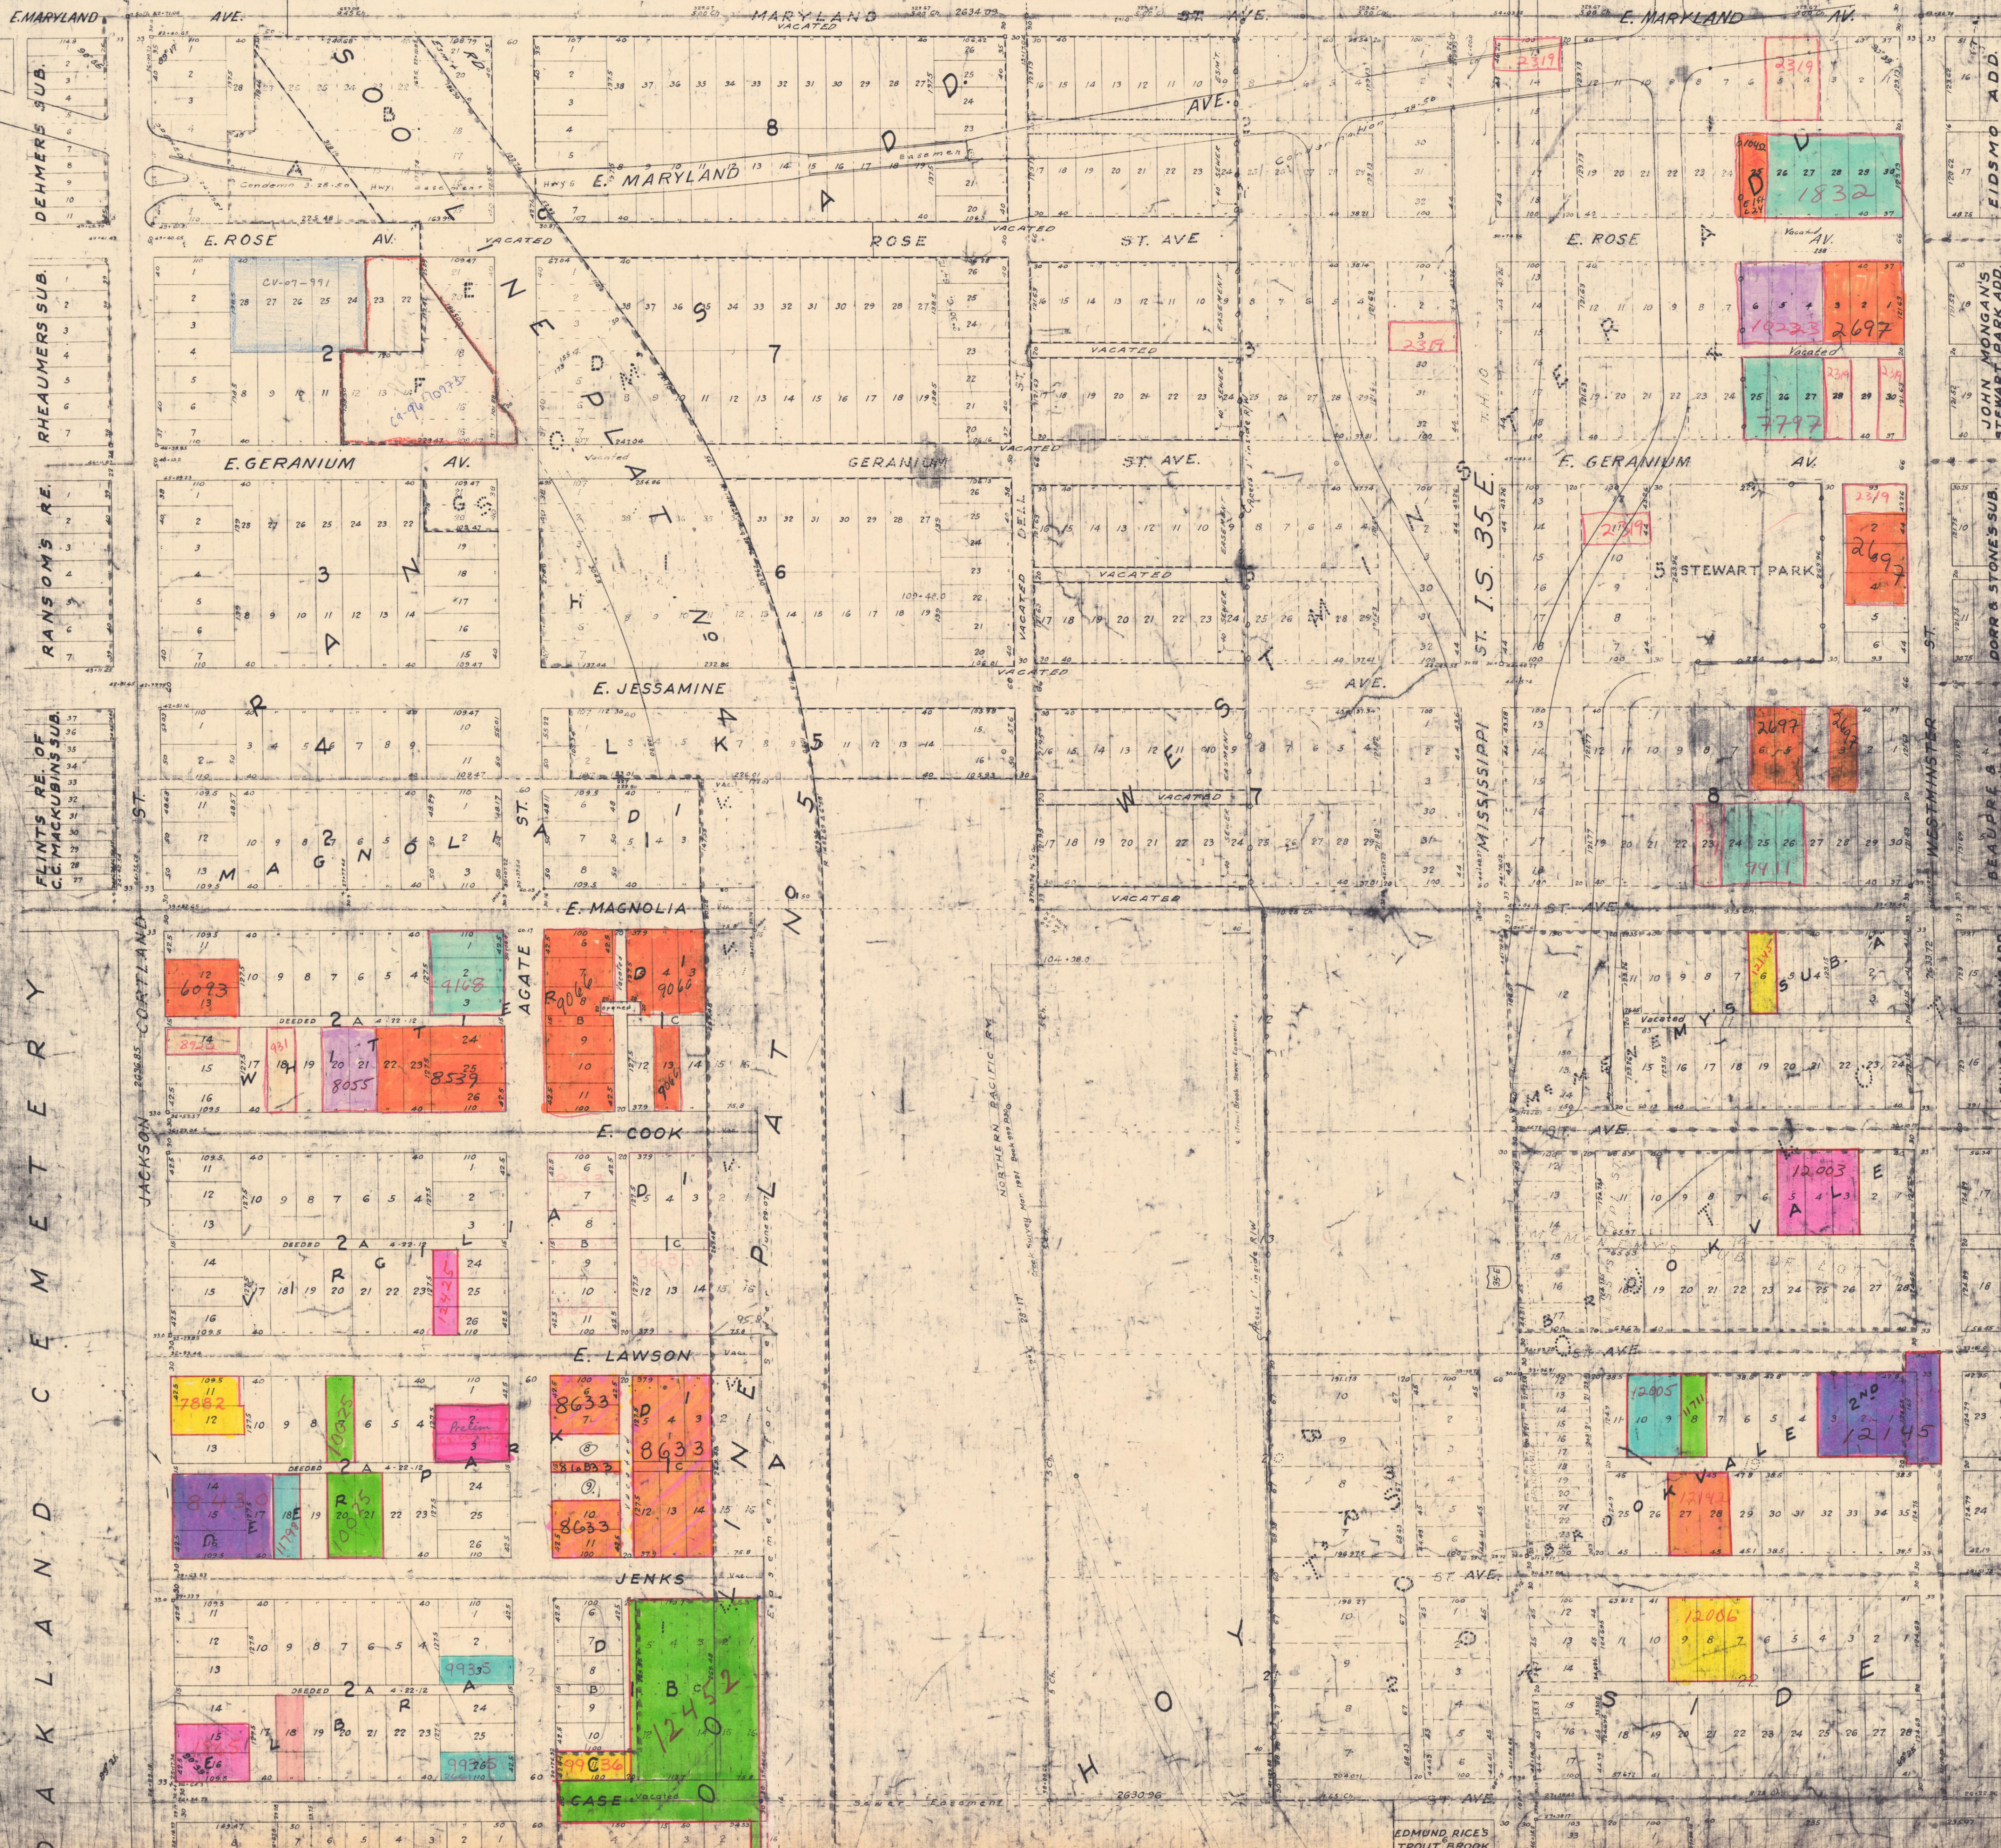

N.E. 1/4 30-29-22

EDMUND RICE'S TROUT BROOK ADD. EDMUND RICE'S 4TH ADD.