


N.W. 1/4, Sec. 12-28-23

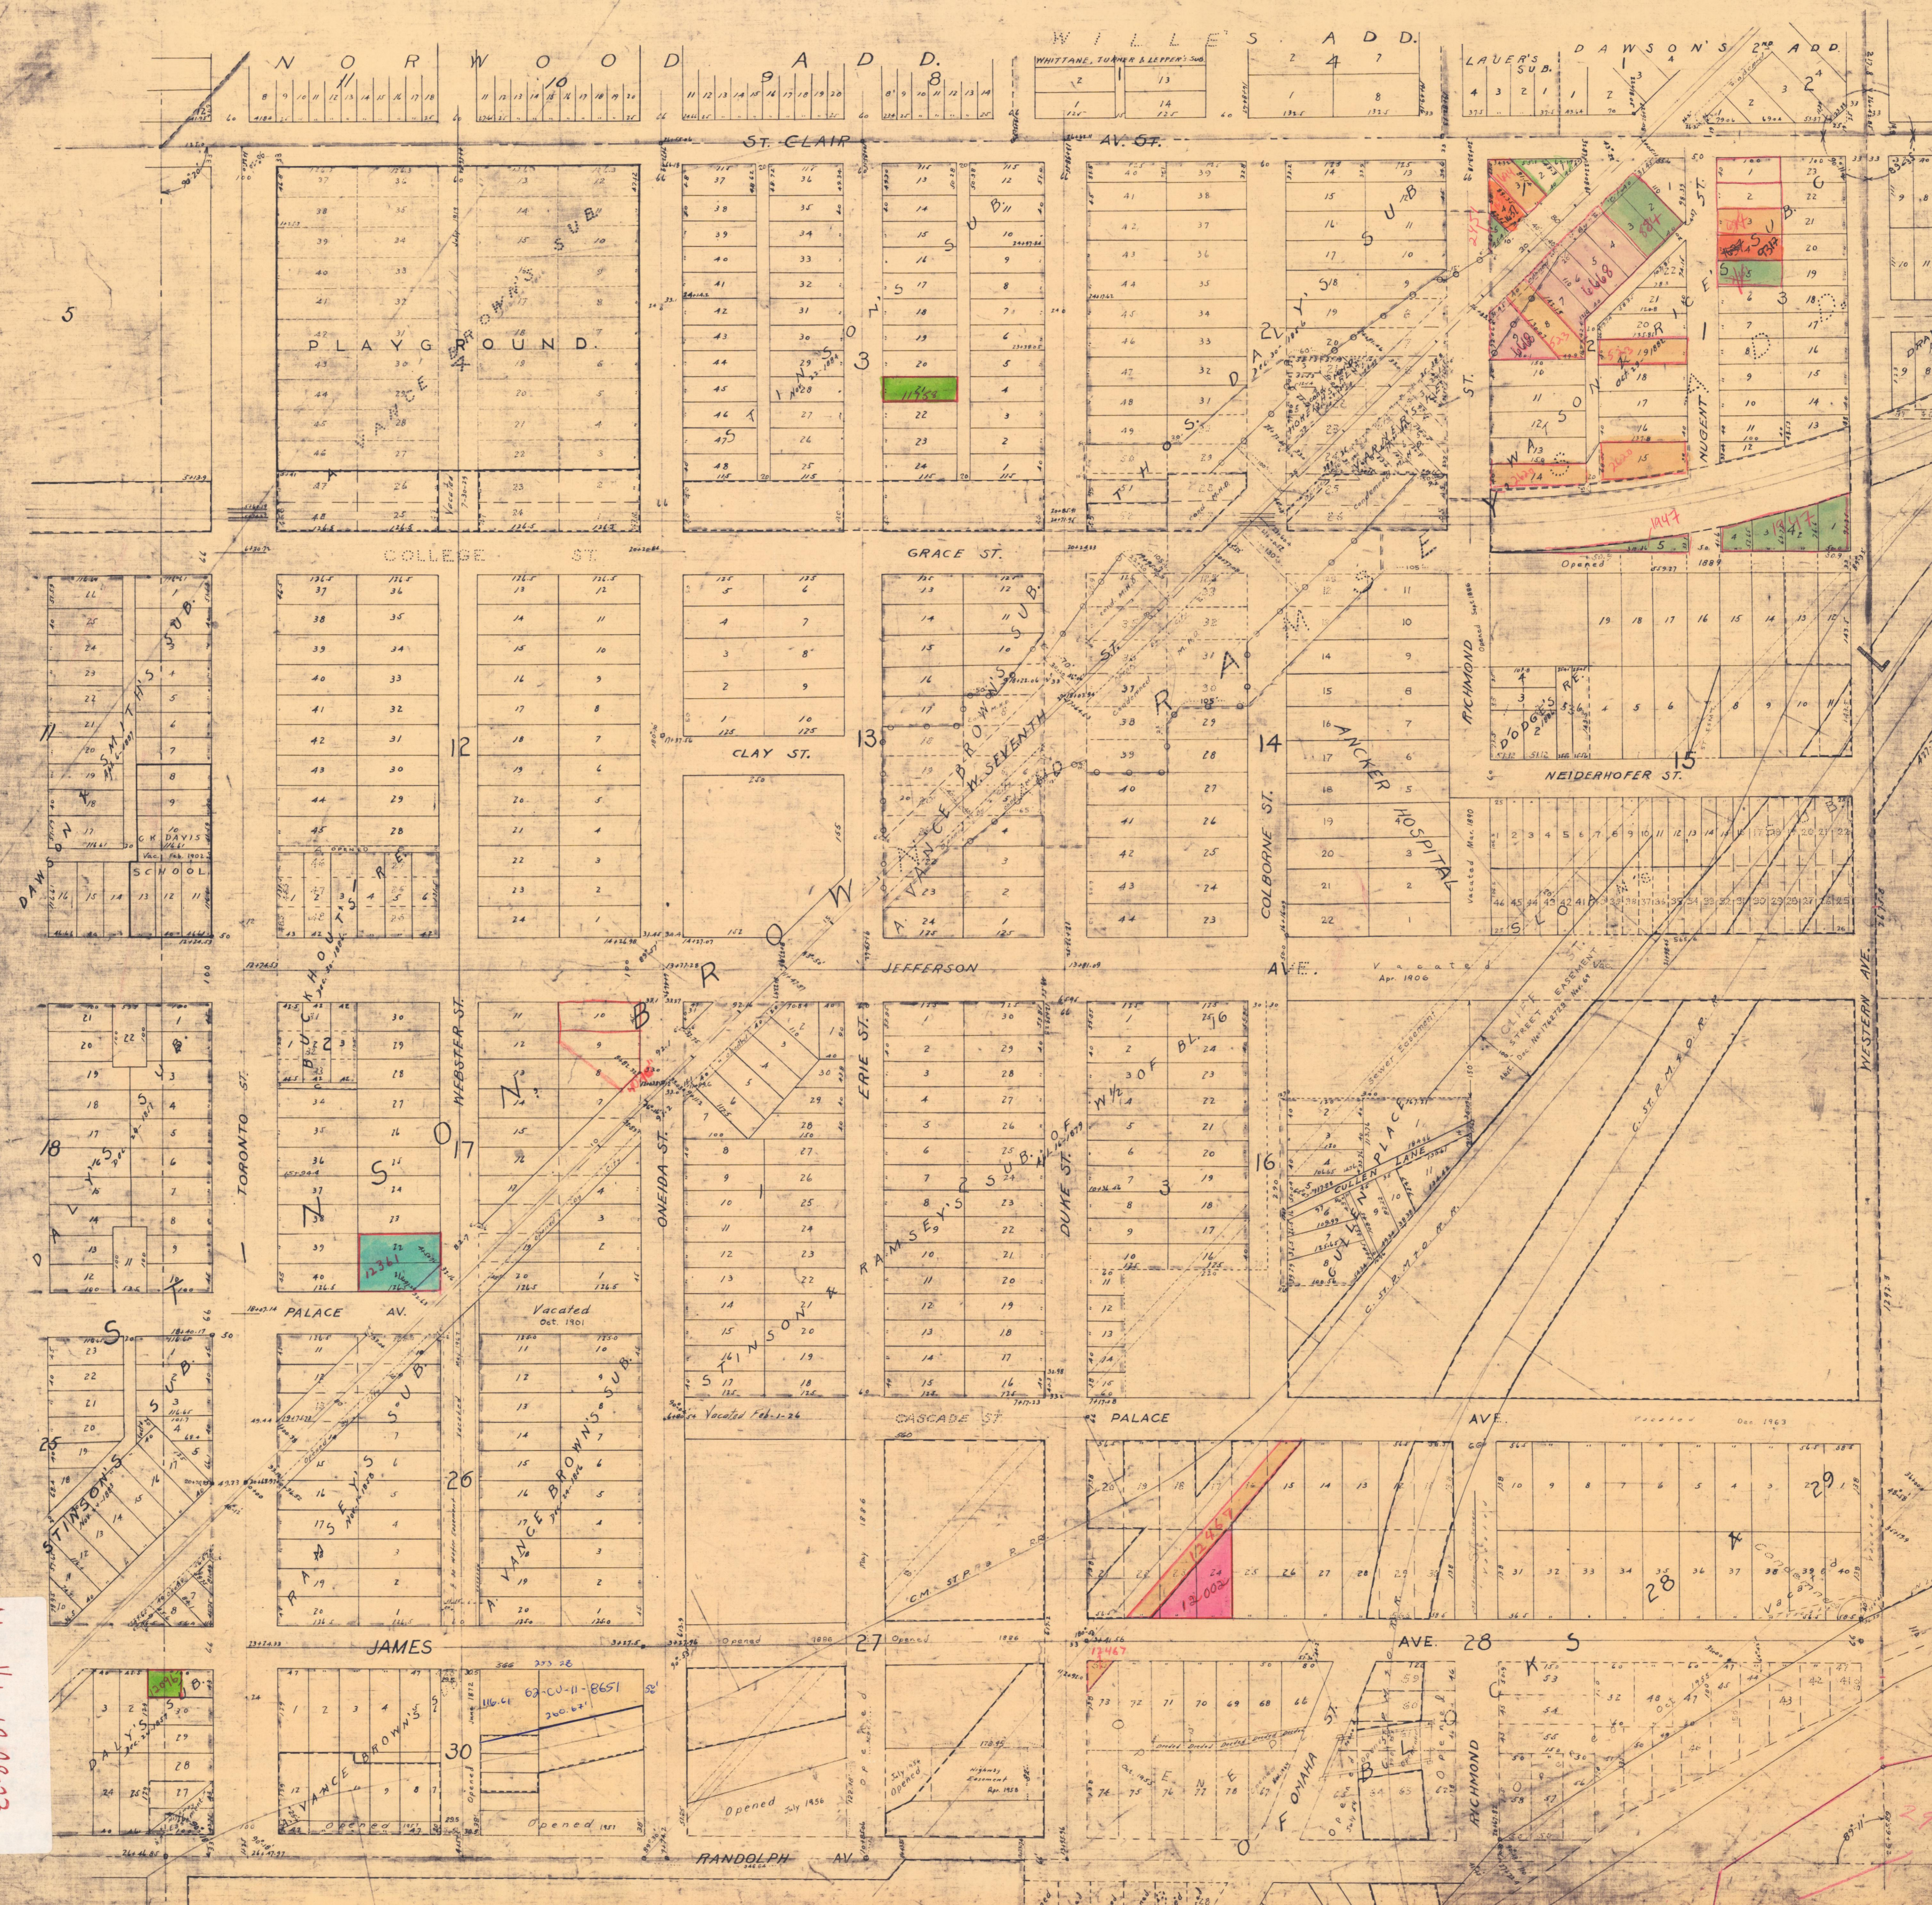

N O R W O O D A D D. W I L L E S A D D. L A U E R ' S S U B. D A W S O N ' S 2ND A D D.

ST. CLAIR AV. ST. COLLEGE ST. GRACE ST. CLAY ST. JEFFERSON

TORONTO ST. WEBSTER ST. ONEIDA ST. ERIE ST. DUME ST. CASCADE ST. PALACE AV. JAMES

ST. TINSOM'S VANCE BROWN'S SUB. DUNN'S SUB. NEIDERHOFER ST. COLBORNE ST. ANCKER HOSPITAL RICHMOND

ST. TINSOM'S VANCE BROWN'S SUB. DUNN'S SUB. NEIDERHOFER ST. COLBORNE ST. ANCKER HOSPITAL RICHMOND

RANDOLPH AV. WESTERN AVE. PALACE AV. JAMES

N.W. 1/4 12-28-23

2919