


N.W. 1/4 SEC. 20, T.29, R.23.

HENN. CO. 17-29-23
2

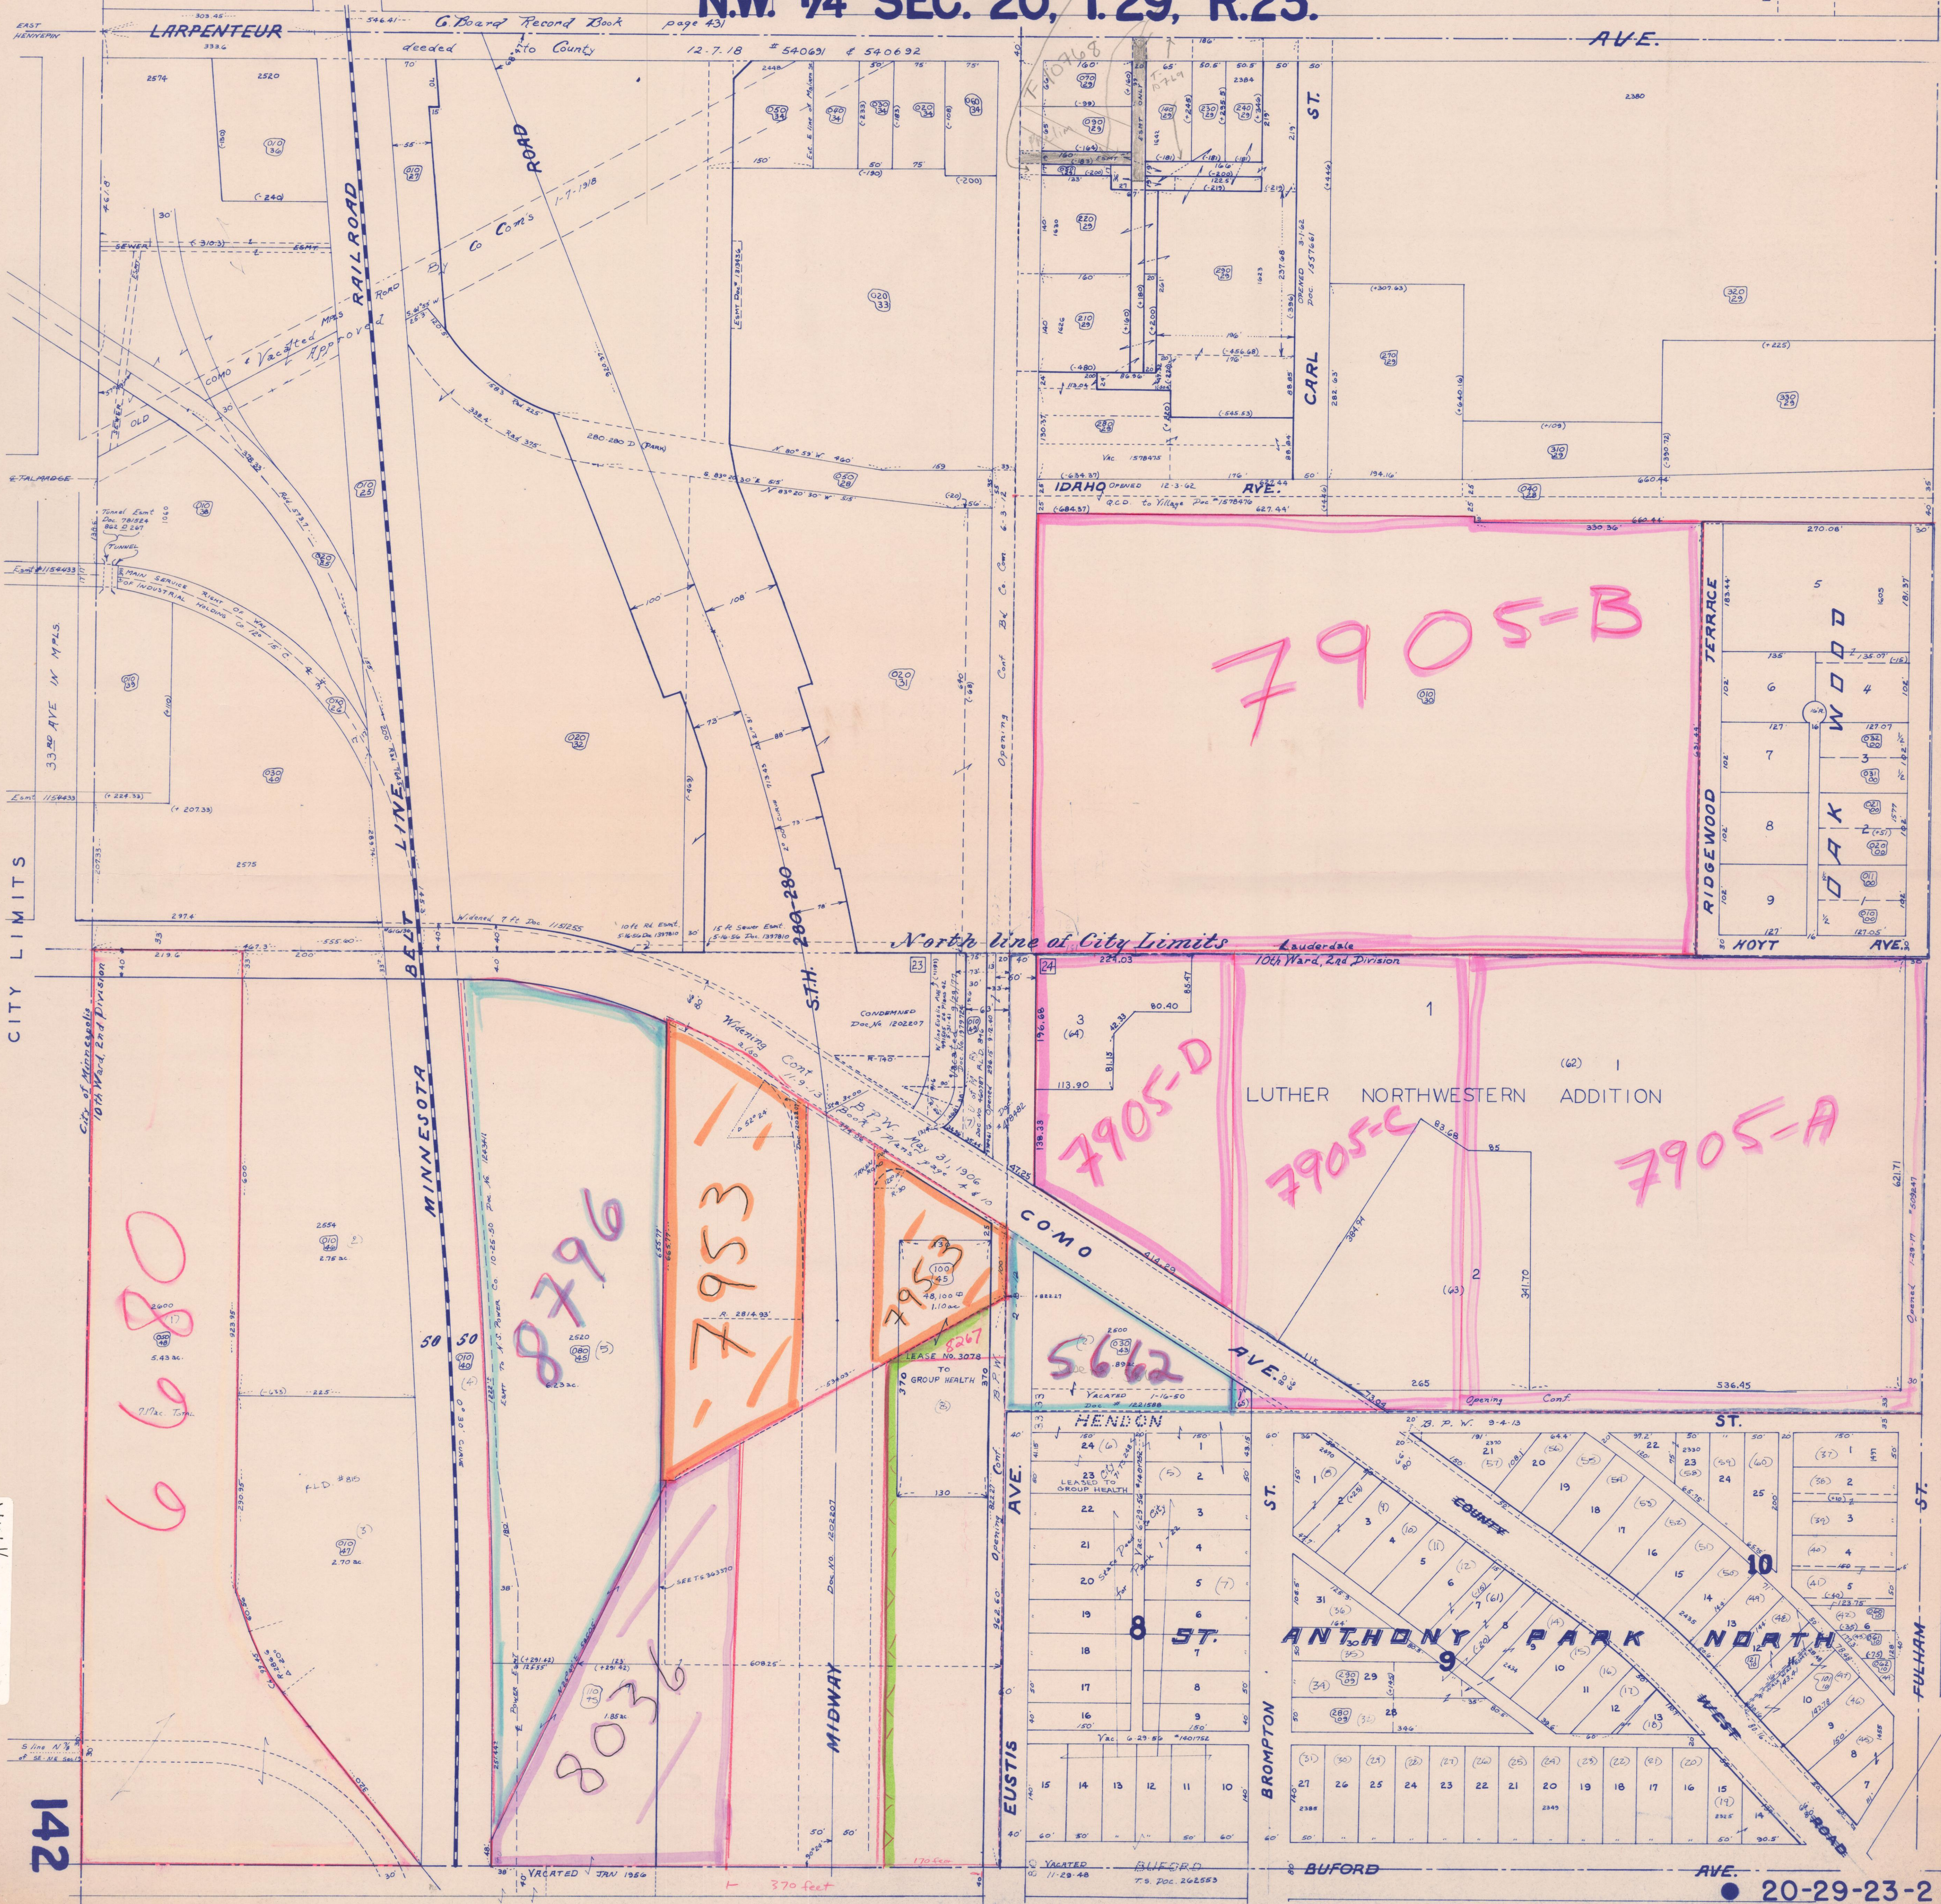

7-10768
shaded easement area also in prelim stage 1959 Easement 1959 only.

CITY LIMITS

City of Minneapolis
10th Ward, 2nd Division

North line of City Limits

LUTHER NORTHWESTERN ADDITION


8796
7953

7905-D

7905-C

7905-A

5662


NW 1/4
20-29-23

142