


N. W. 1/4 Sec. 22—29—22

GLADSTONE PLATS

12	19	2	12
13	18	3	13
15	17	4	14
16	16	5	15
105.8	156.74	106.74	

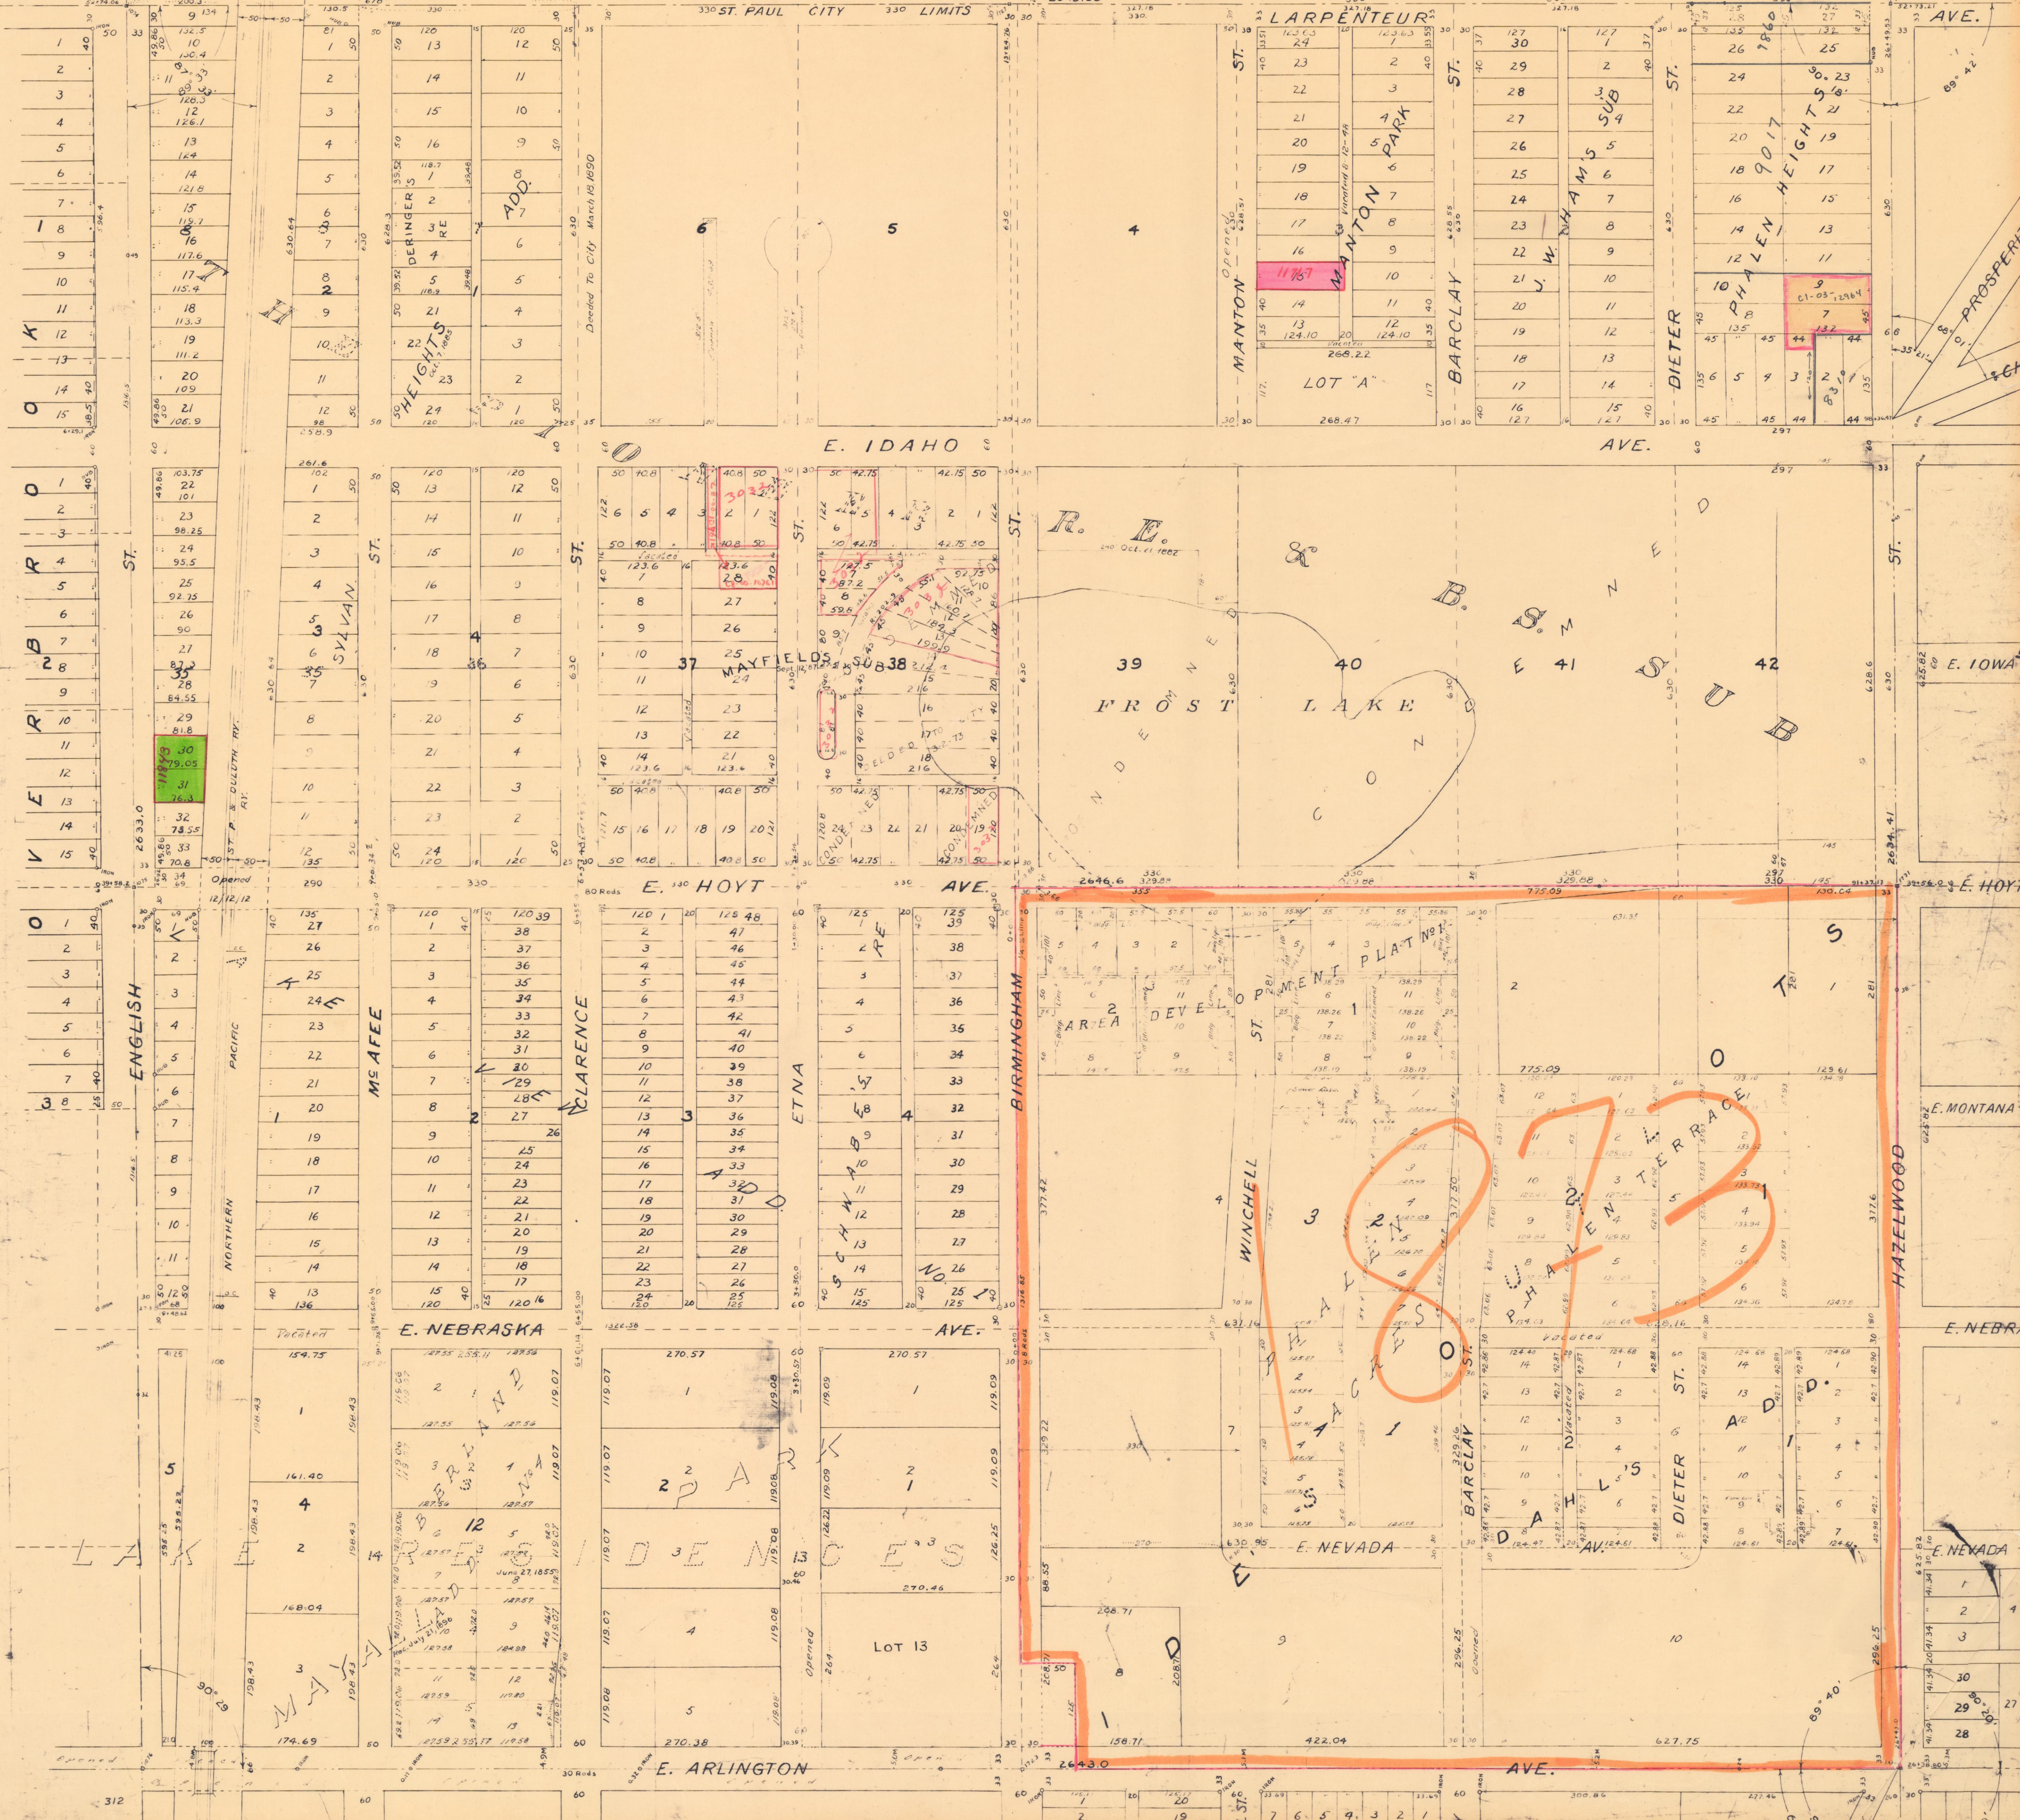

22-29-22 N.W. 1/4