


N. W. 1/4 Sec. 27—29-22

DR 17

WOOD'S ADD. ST. 12 11 10 41 42 50

GERD & HENDRICKS ACRE LOTS NO. 2
NILSSON'S SUB. 15 16 17 

GERD & HENDRICKS ACRE LOTS NO. 2

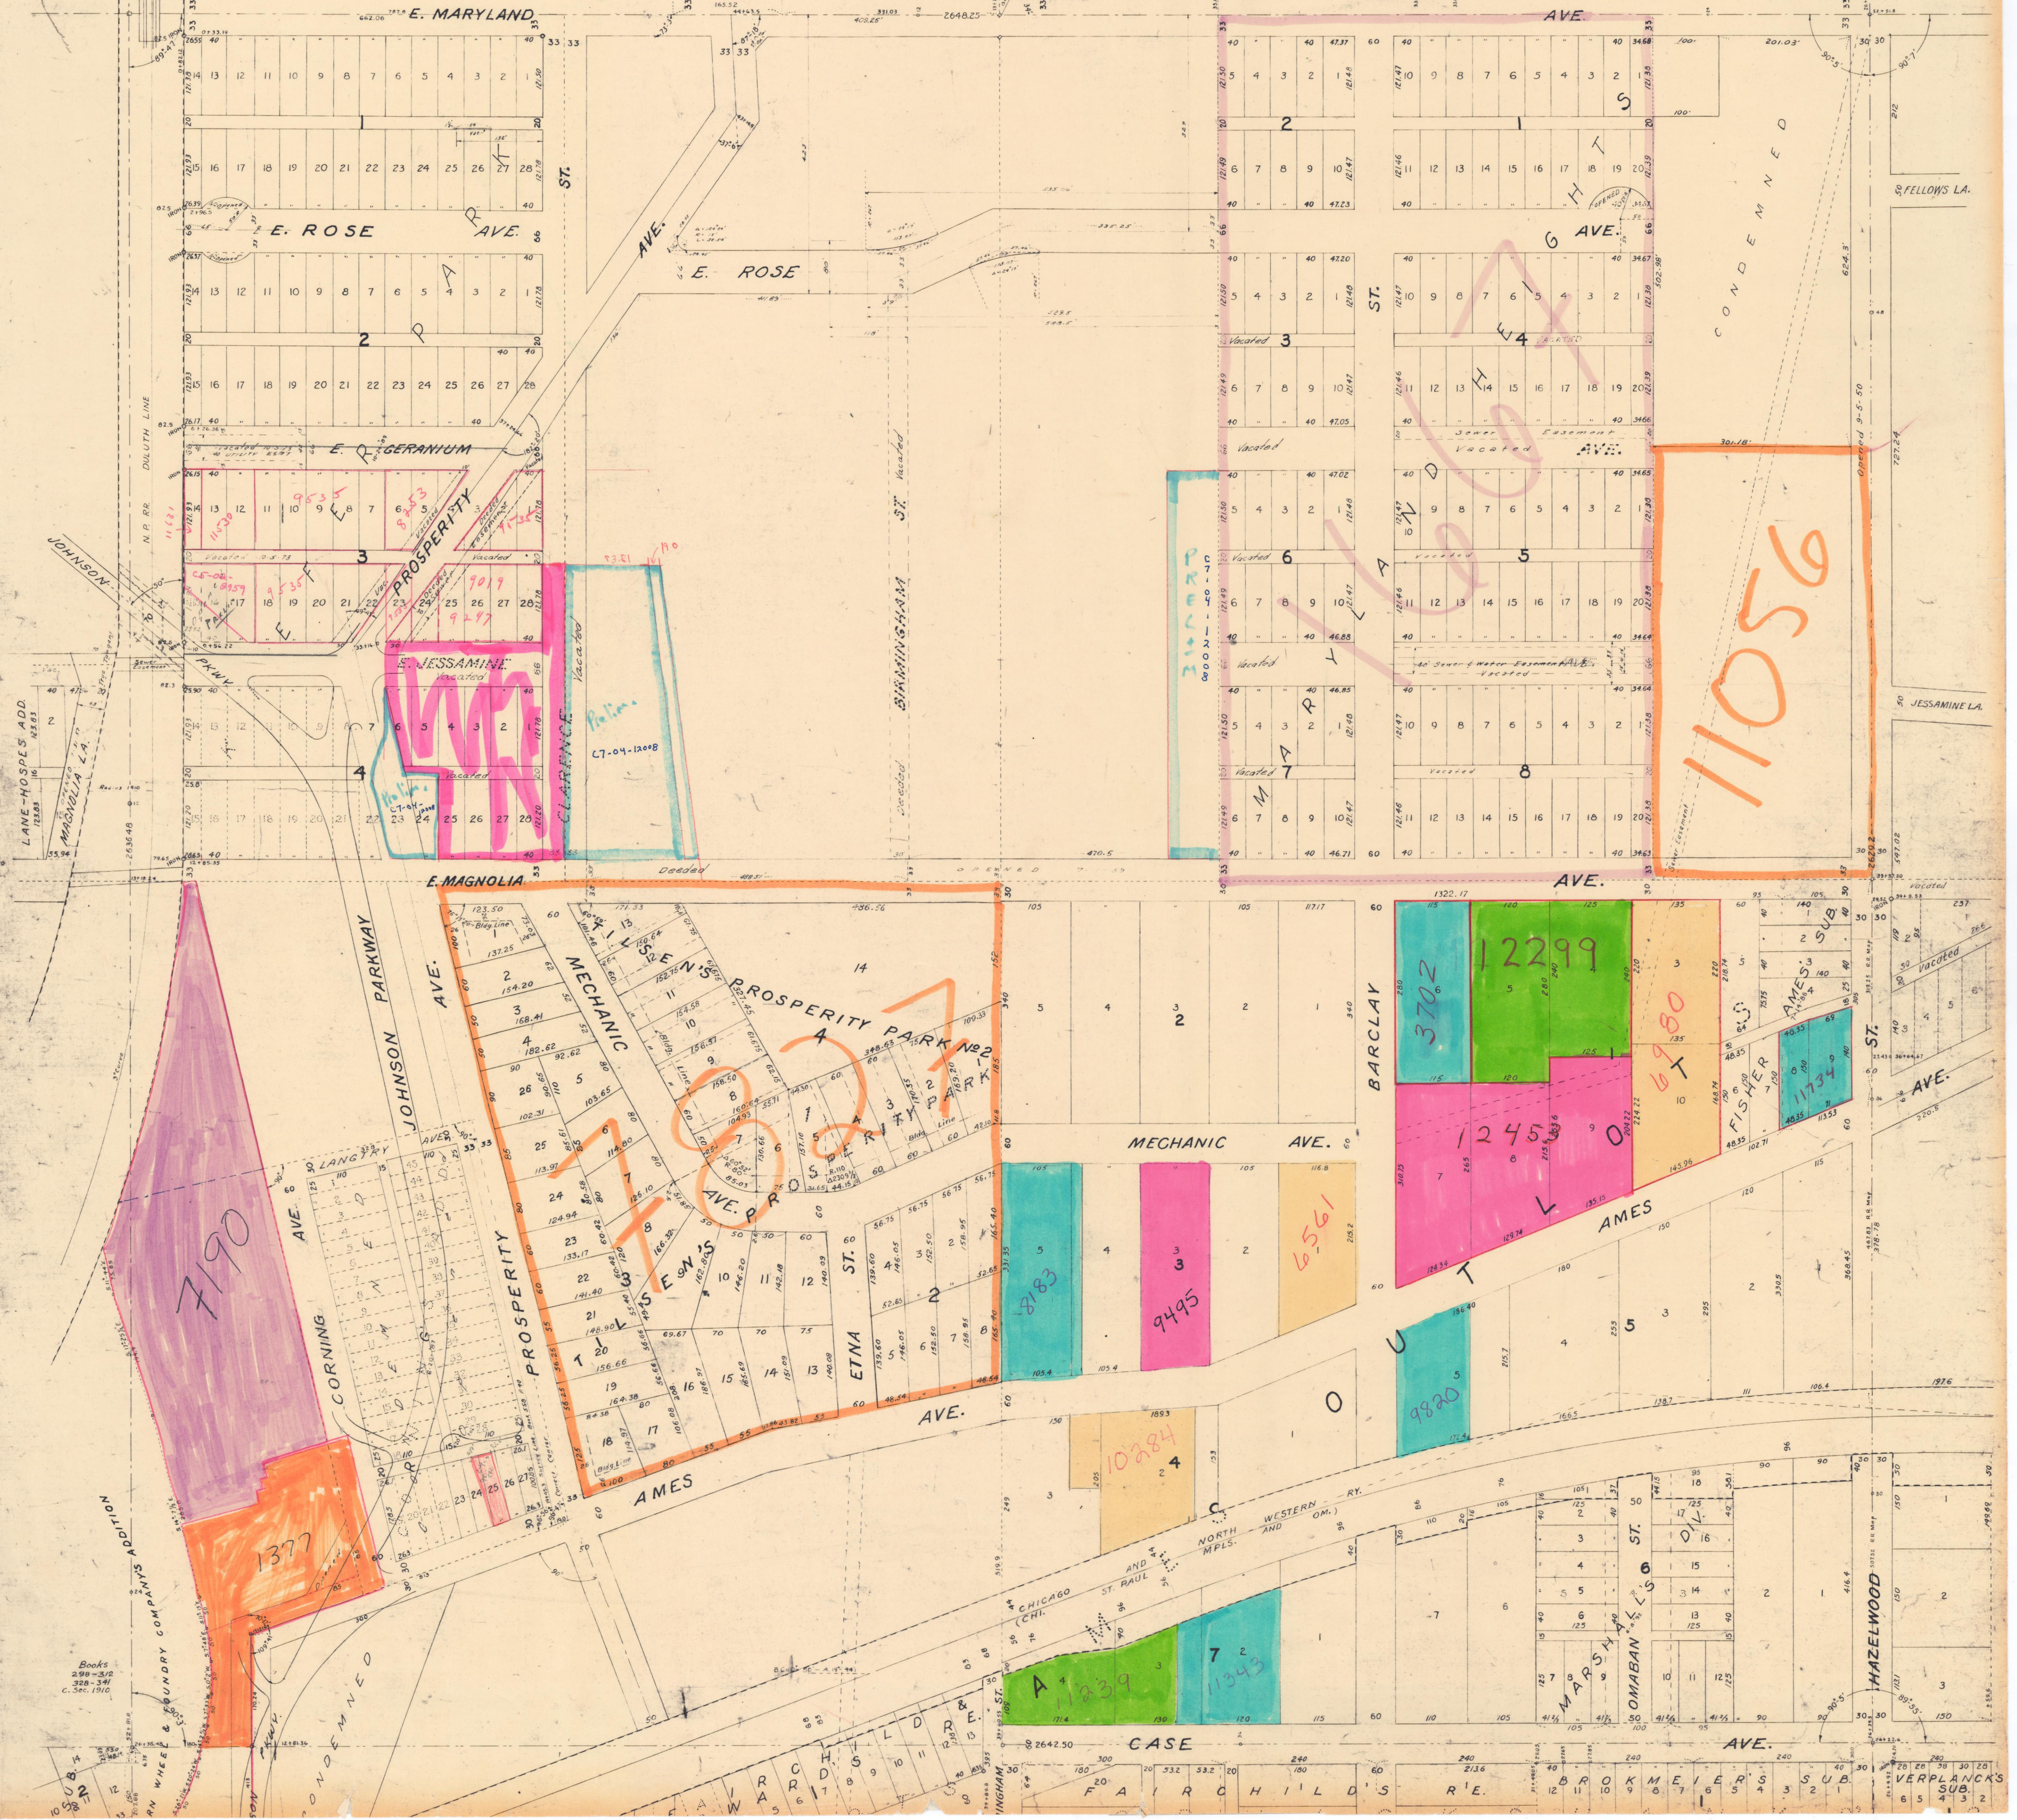

11056

7190

1377

3702
12299
12450
6980
9820
9495
6561
10284

N.W. 1/4 27-29-22



VERPLANCK'S SUB. 6 5 4 3 2