


N. W. Sec. 32 — 29-22

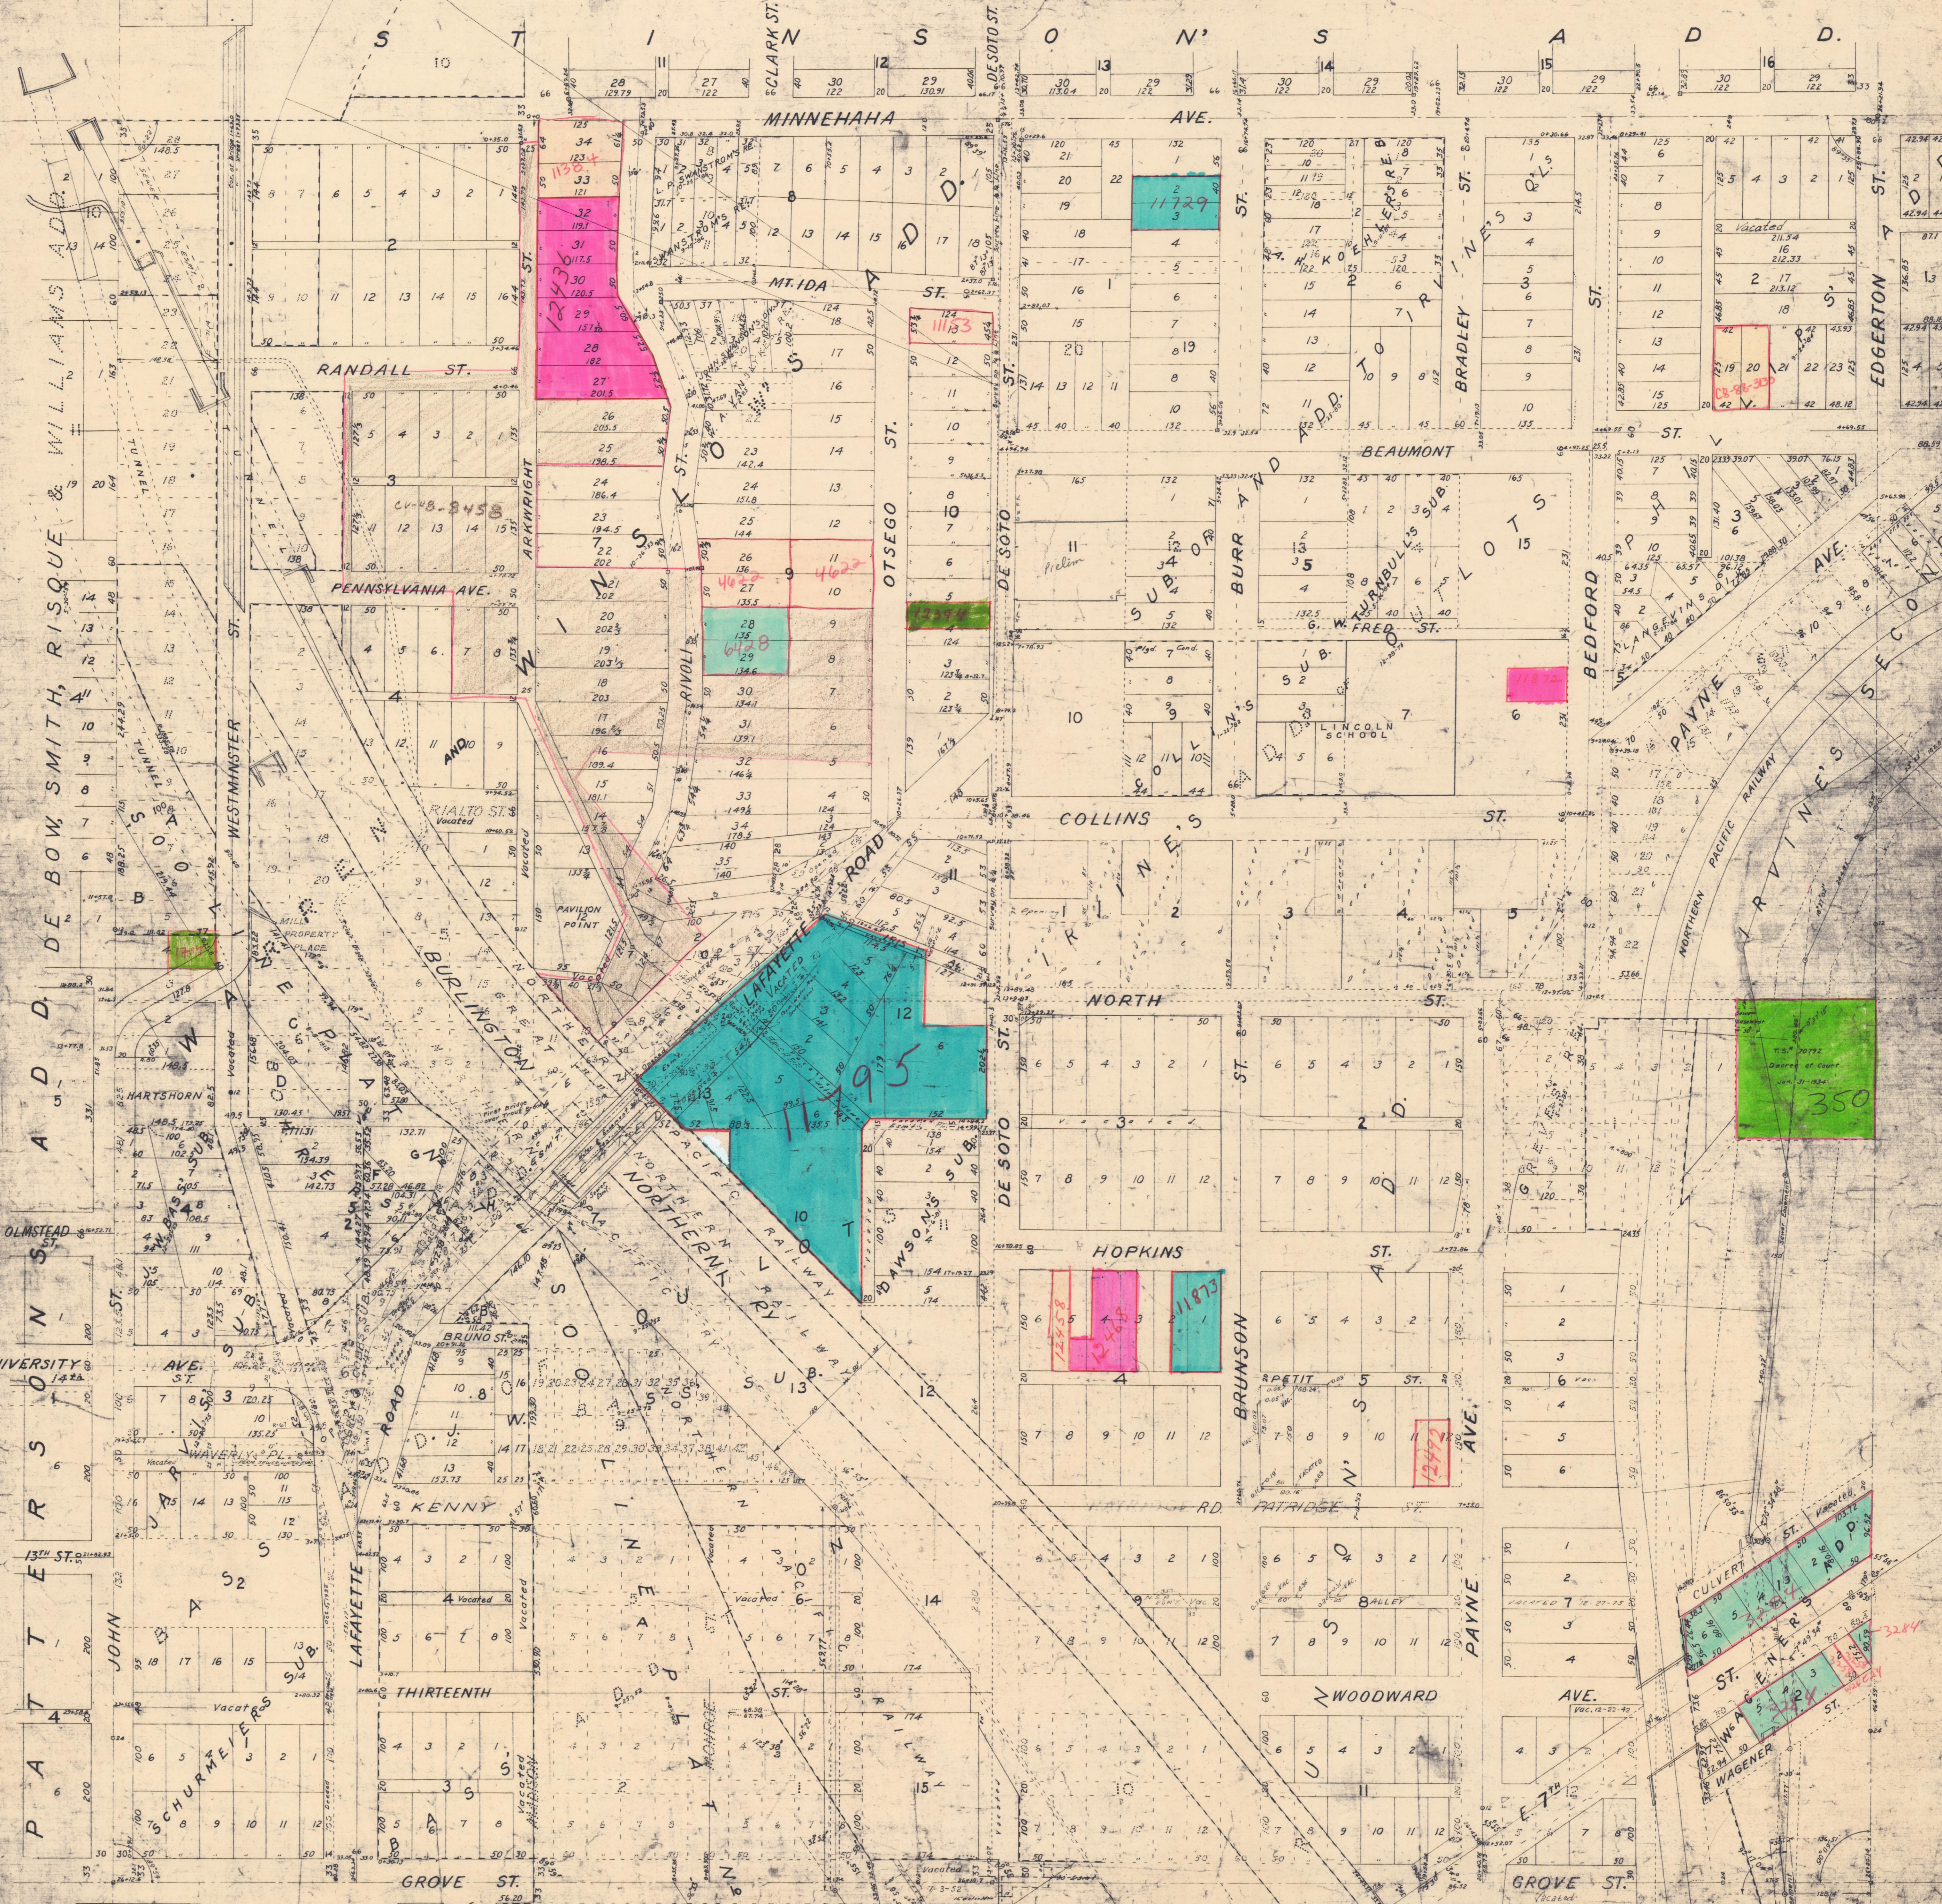


NW 32-29-22

350

3244

Books  
197  
206  
290  
299