


N.W. 1/4 Sec. 32-29-23

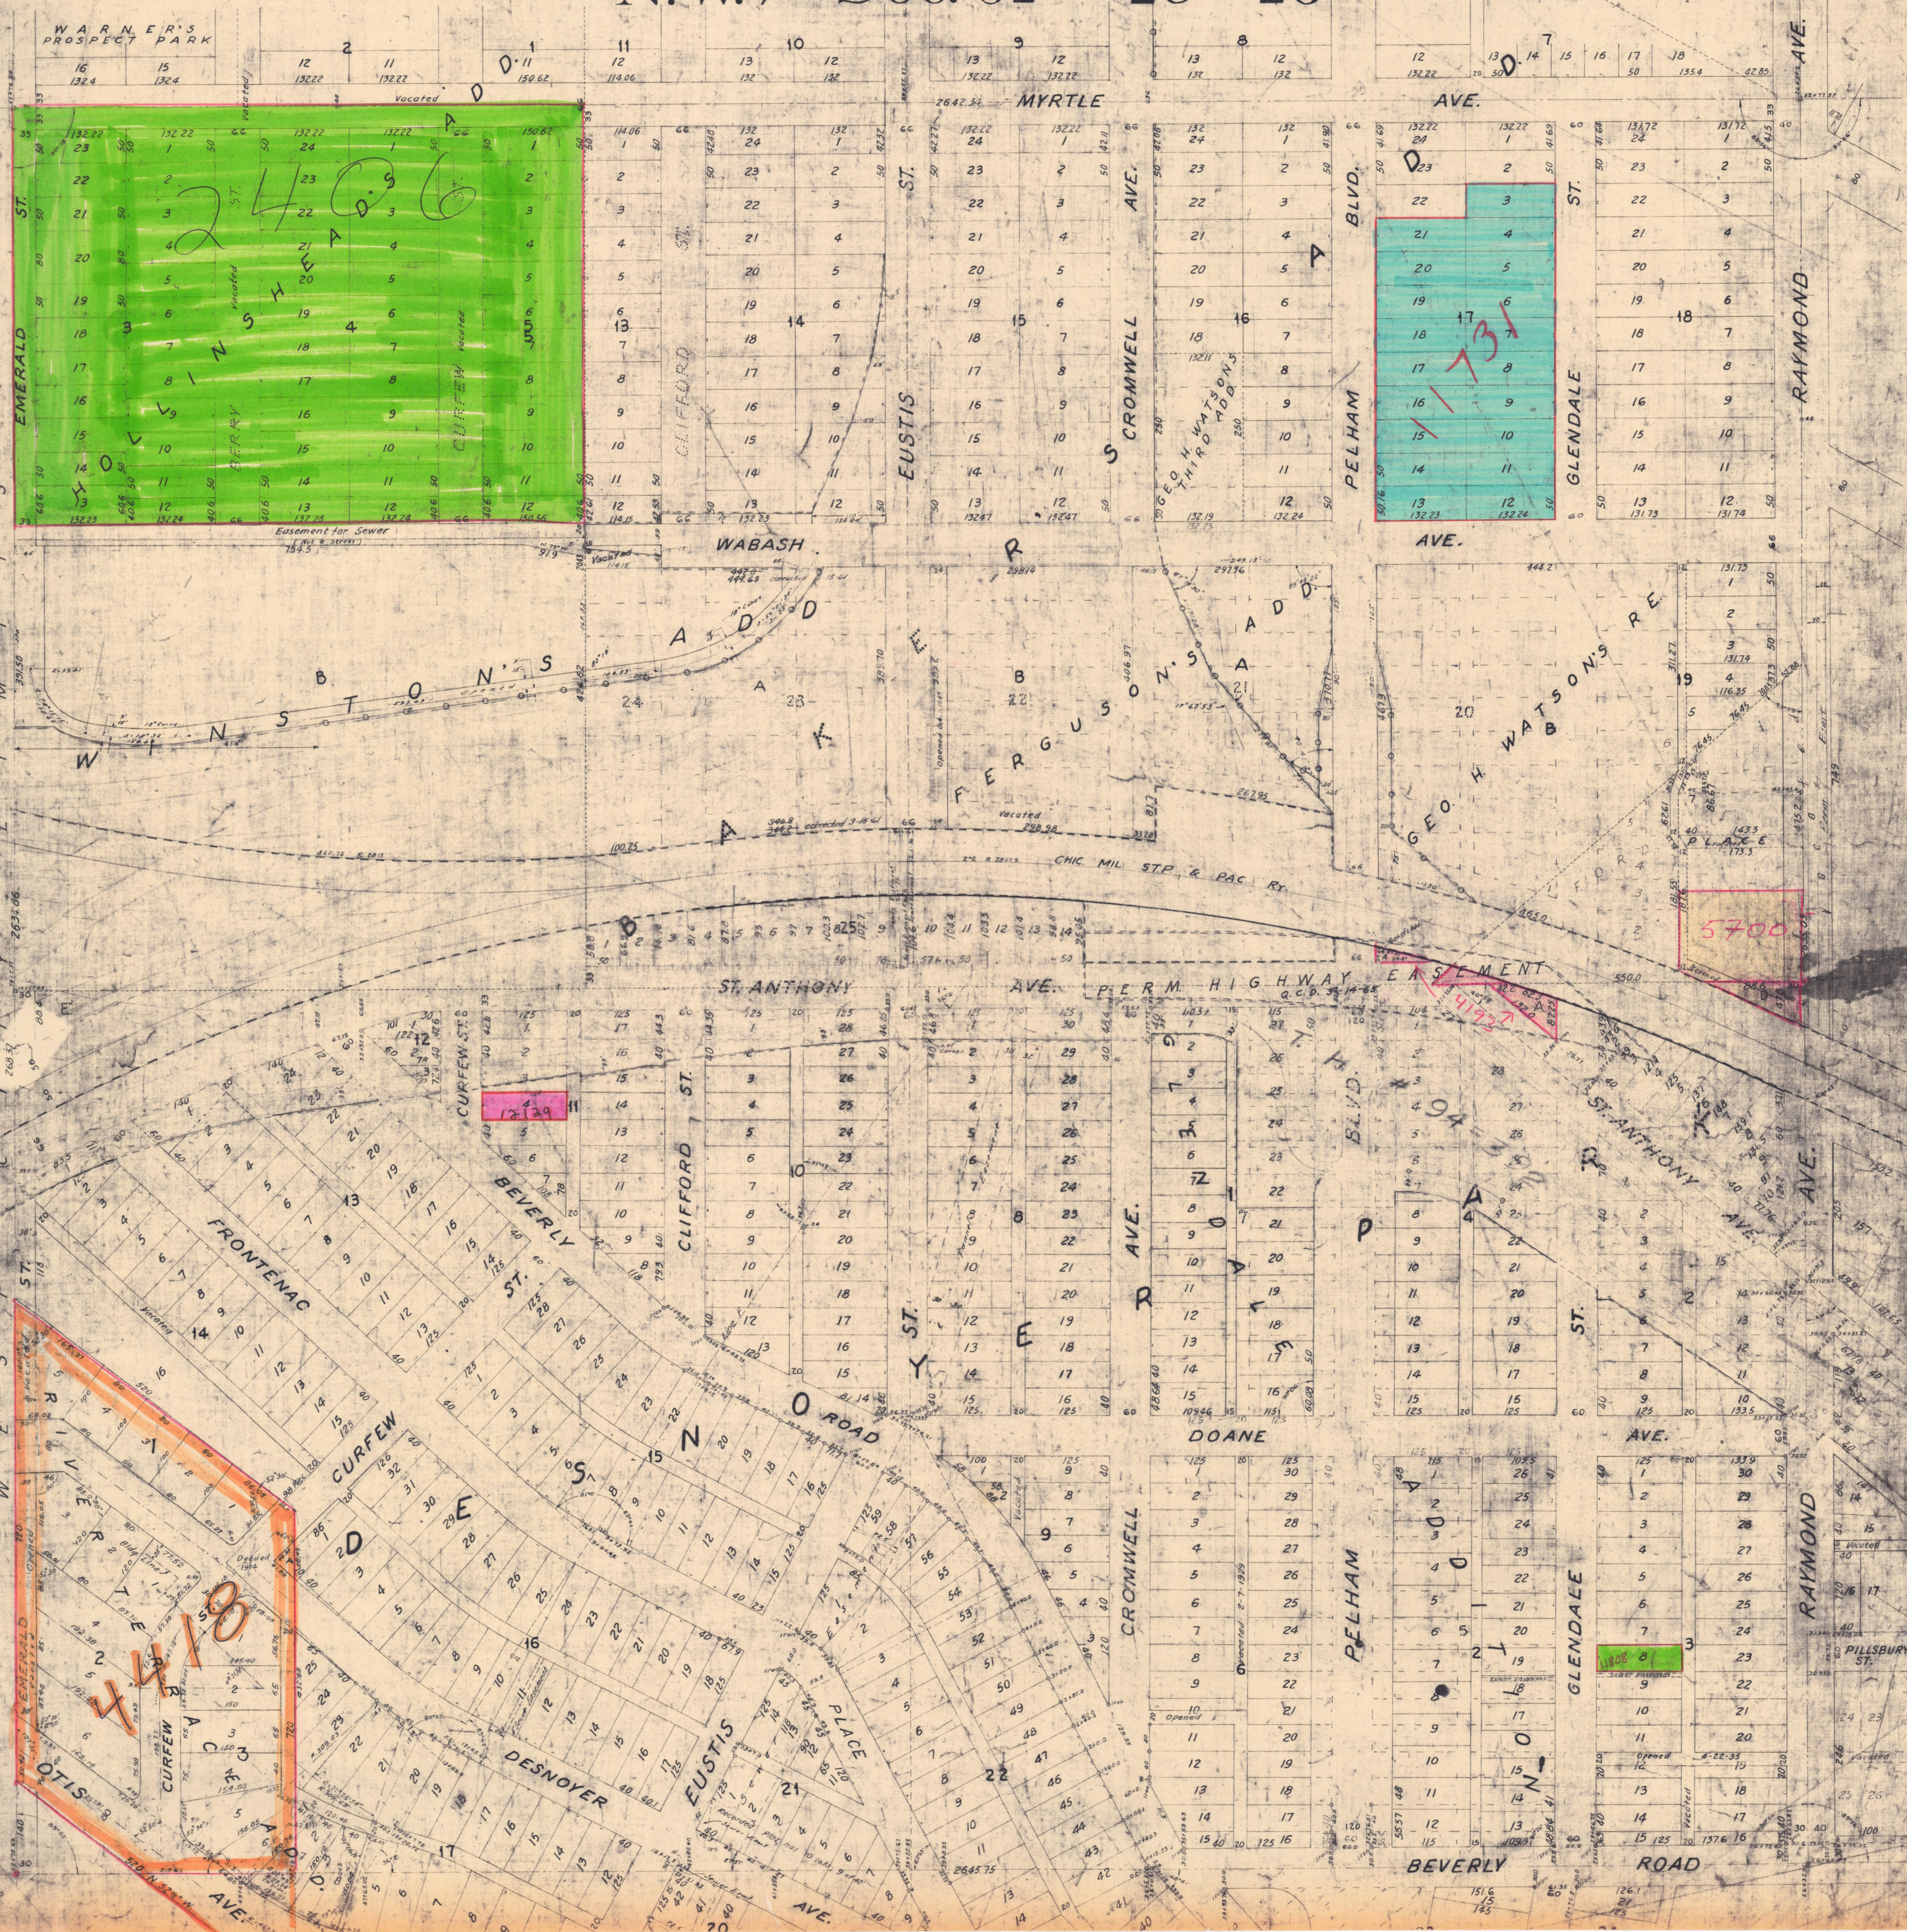

N.W. 1/4 32-29-23

Backs  
216  
218