


S.E. 1/4 - SEC. 10 - T. 28 - R. 23

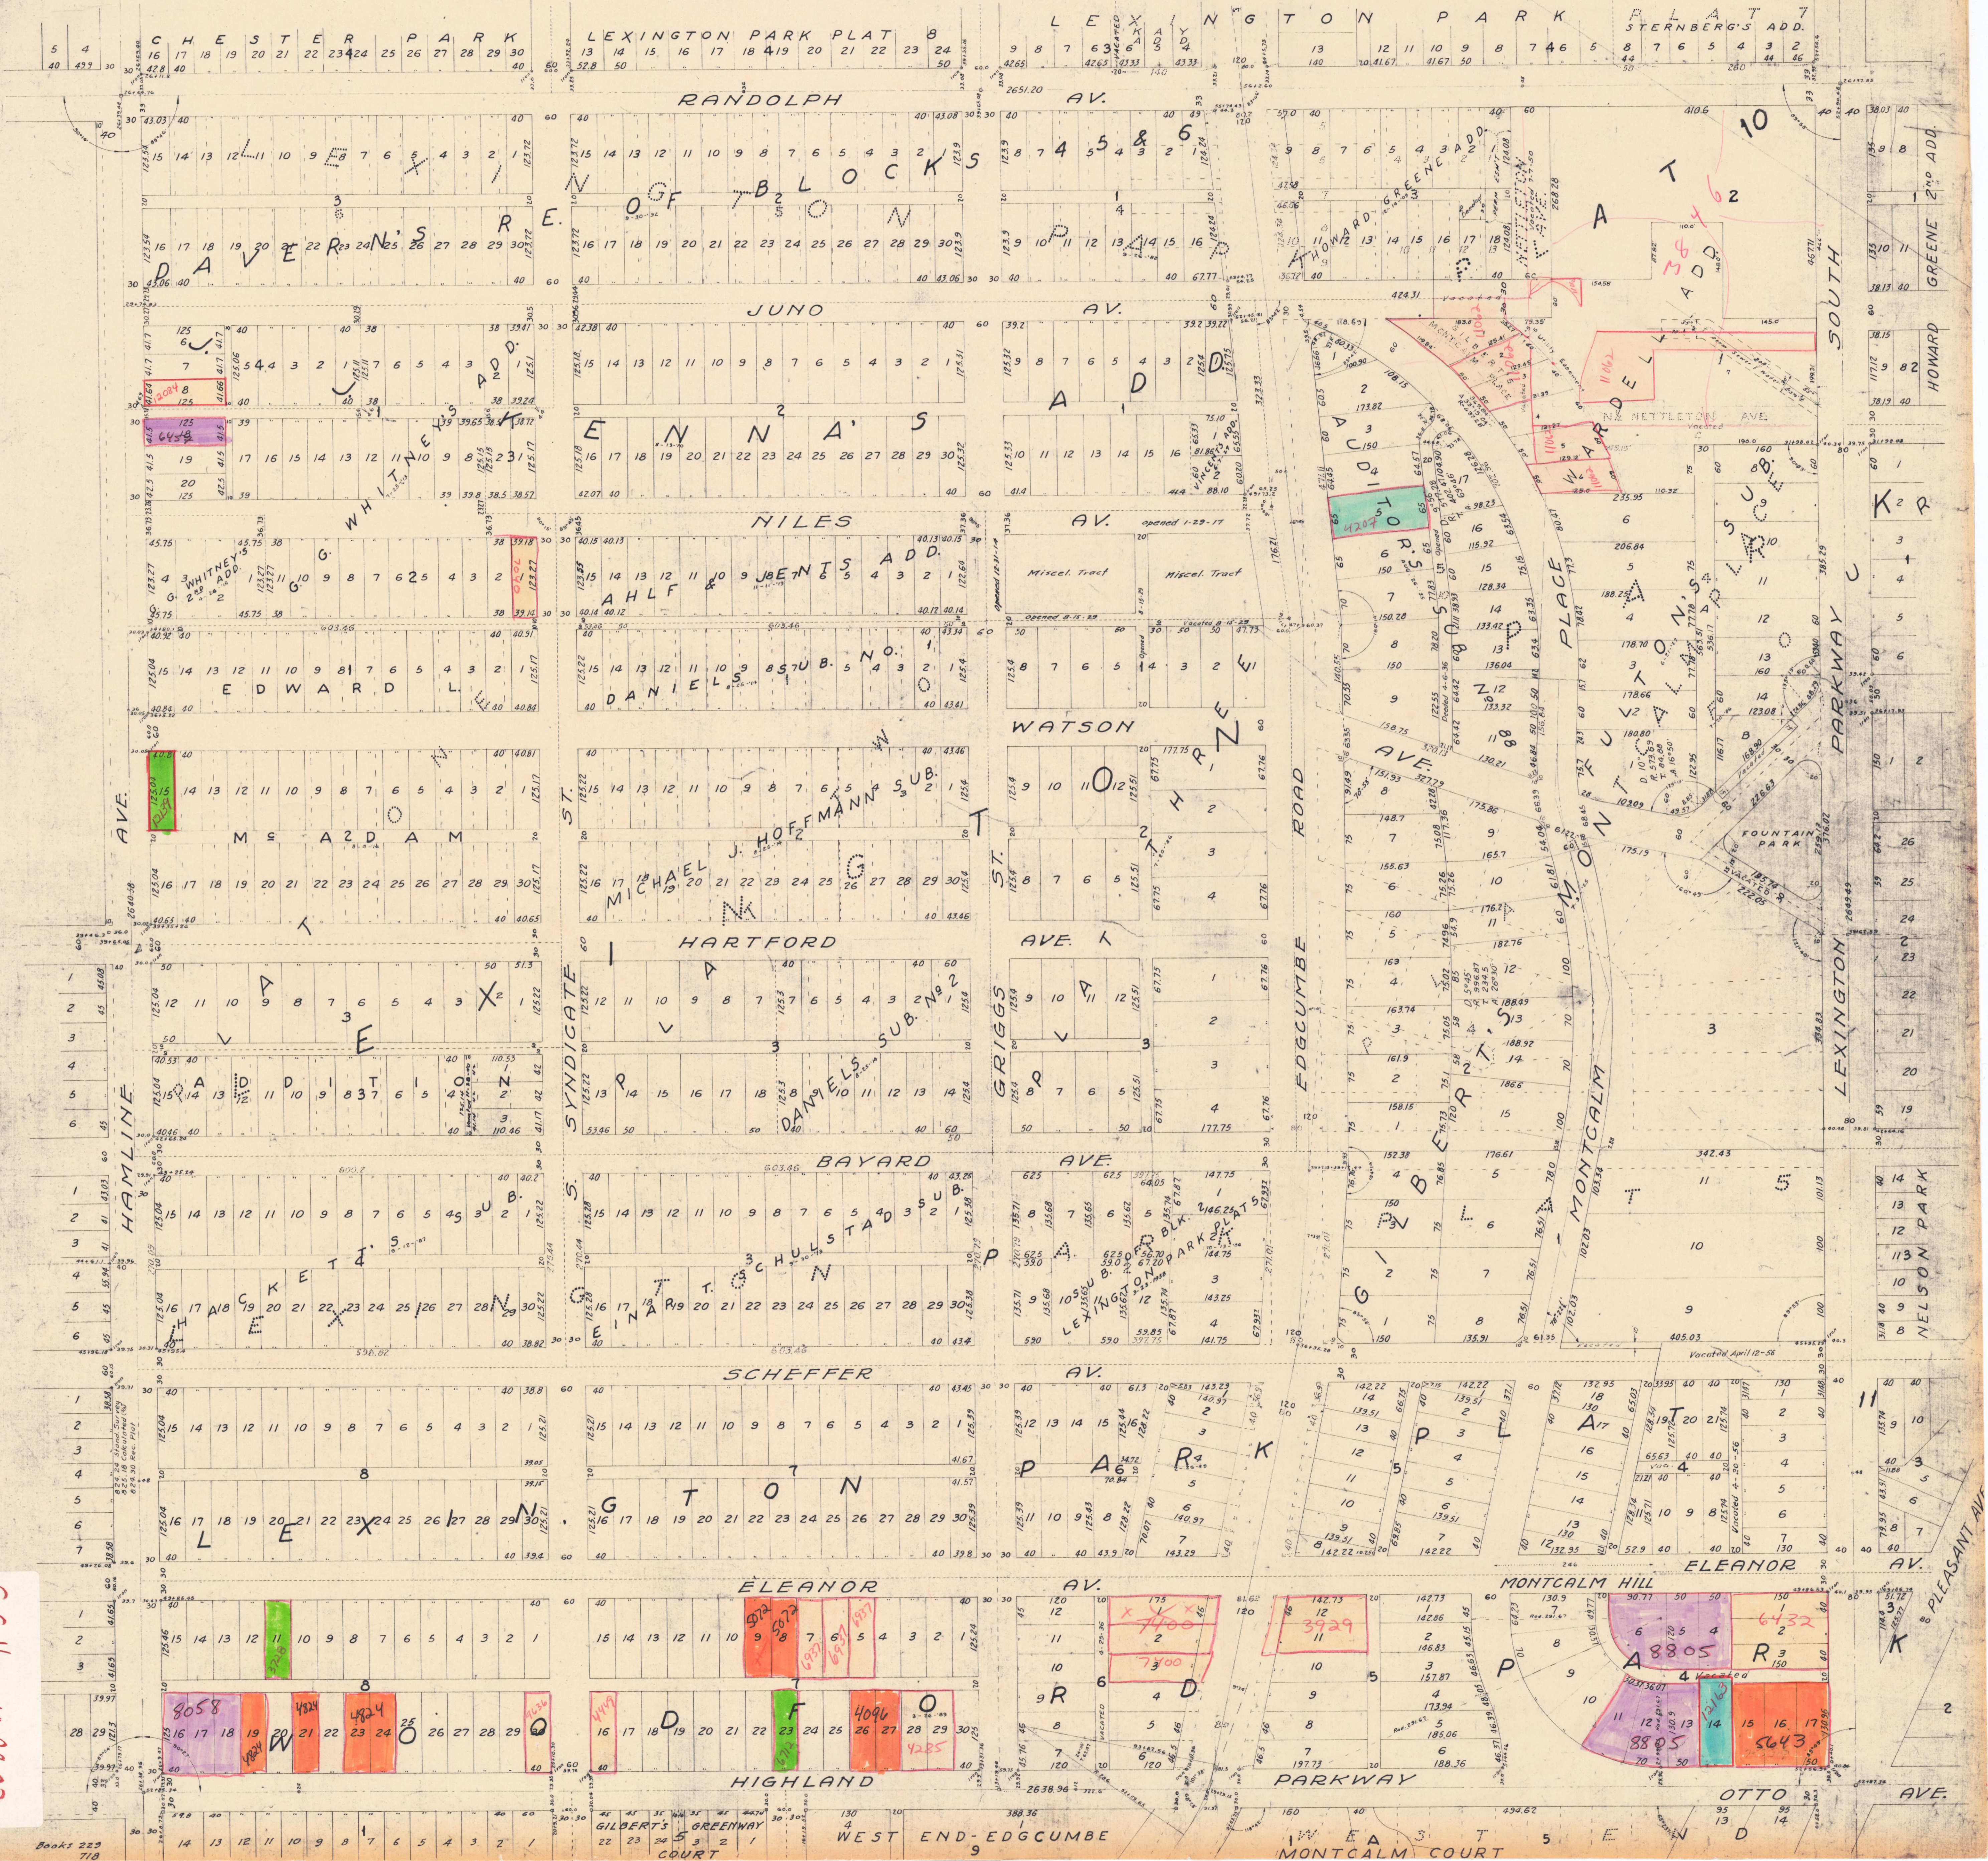

S.E. 1/4
10-28-23