


SE 1/4 SEC 11-28-22

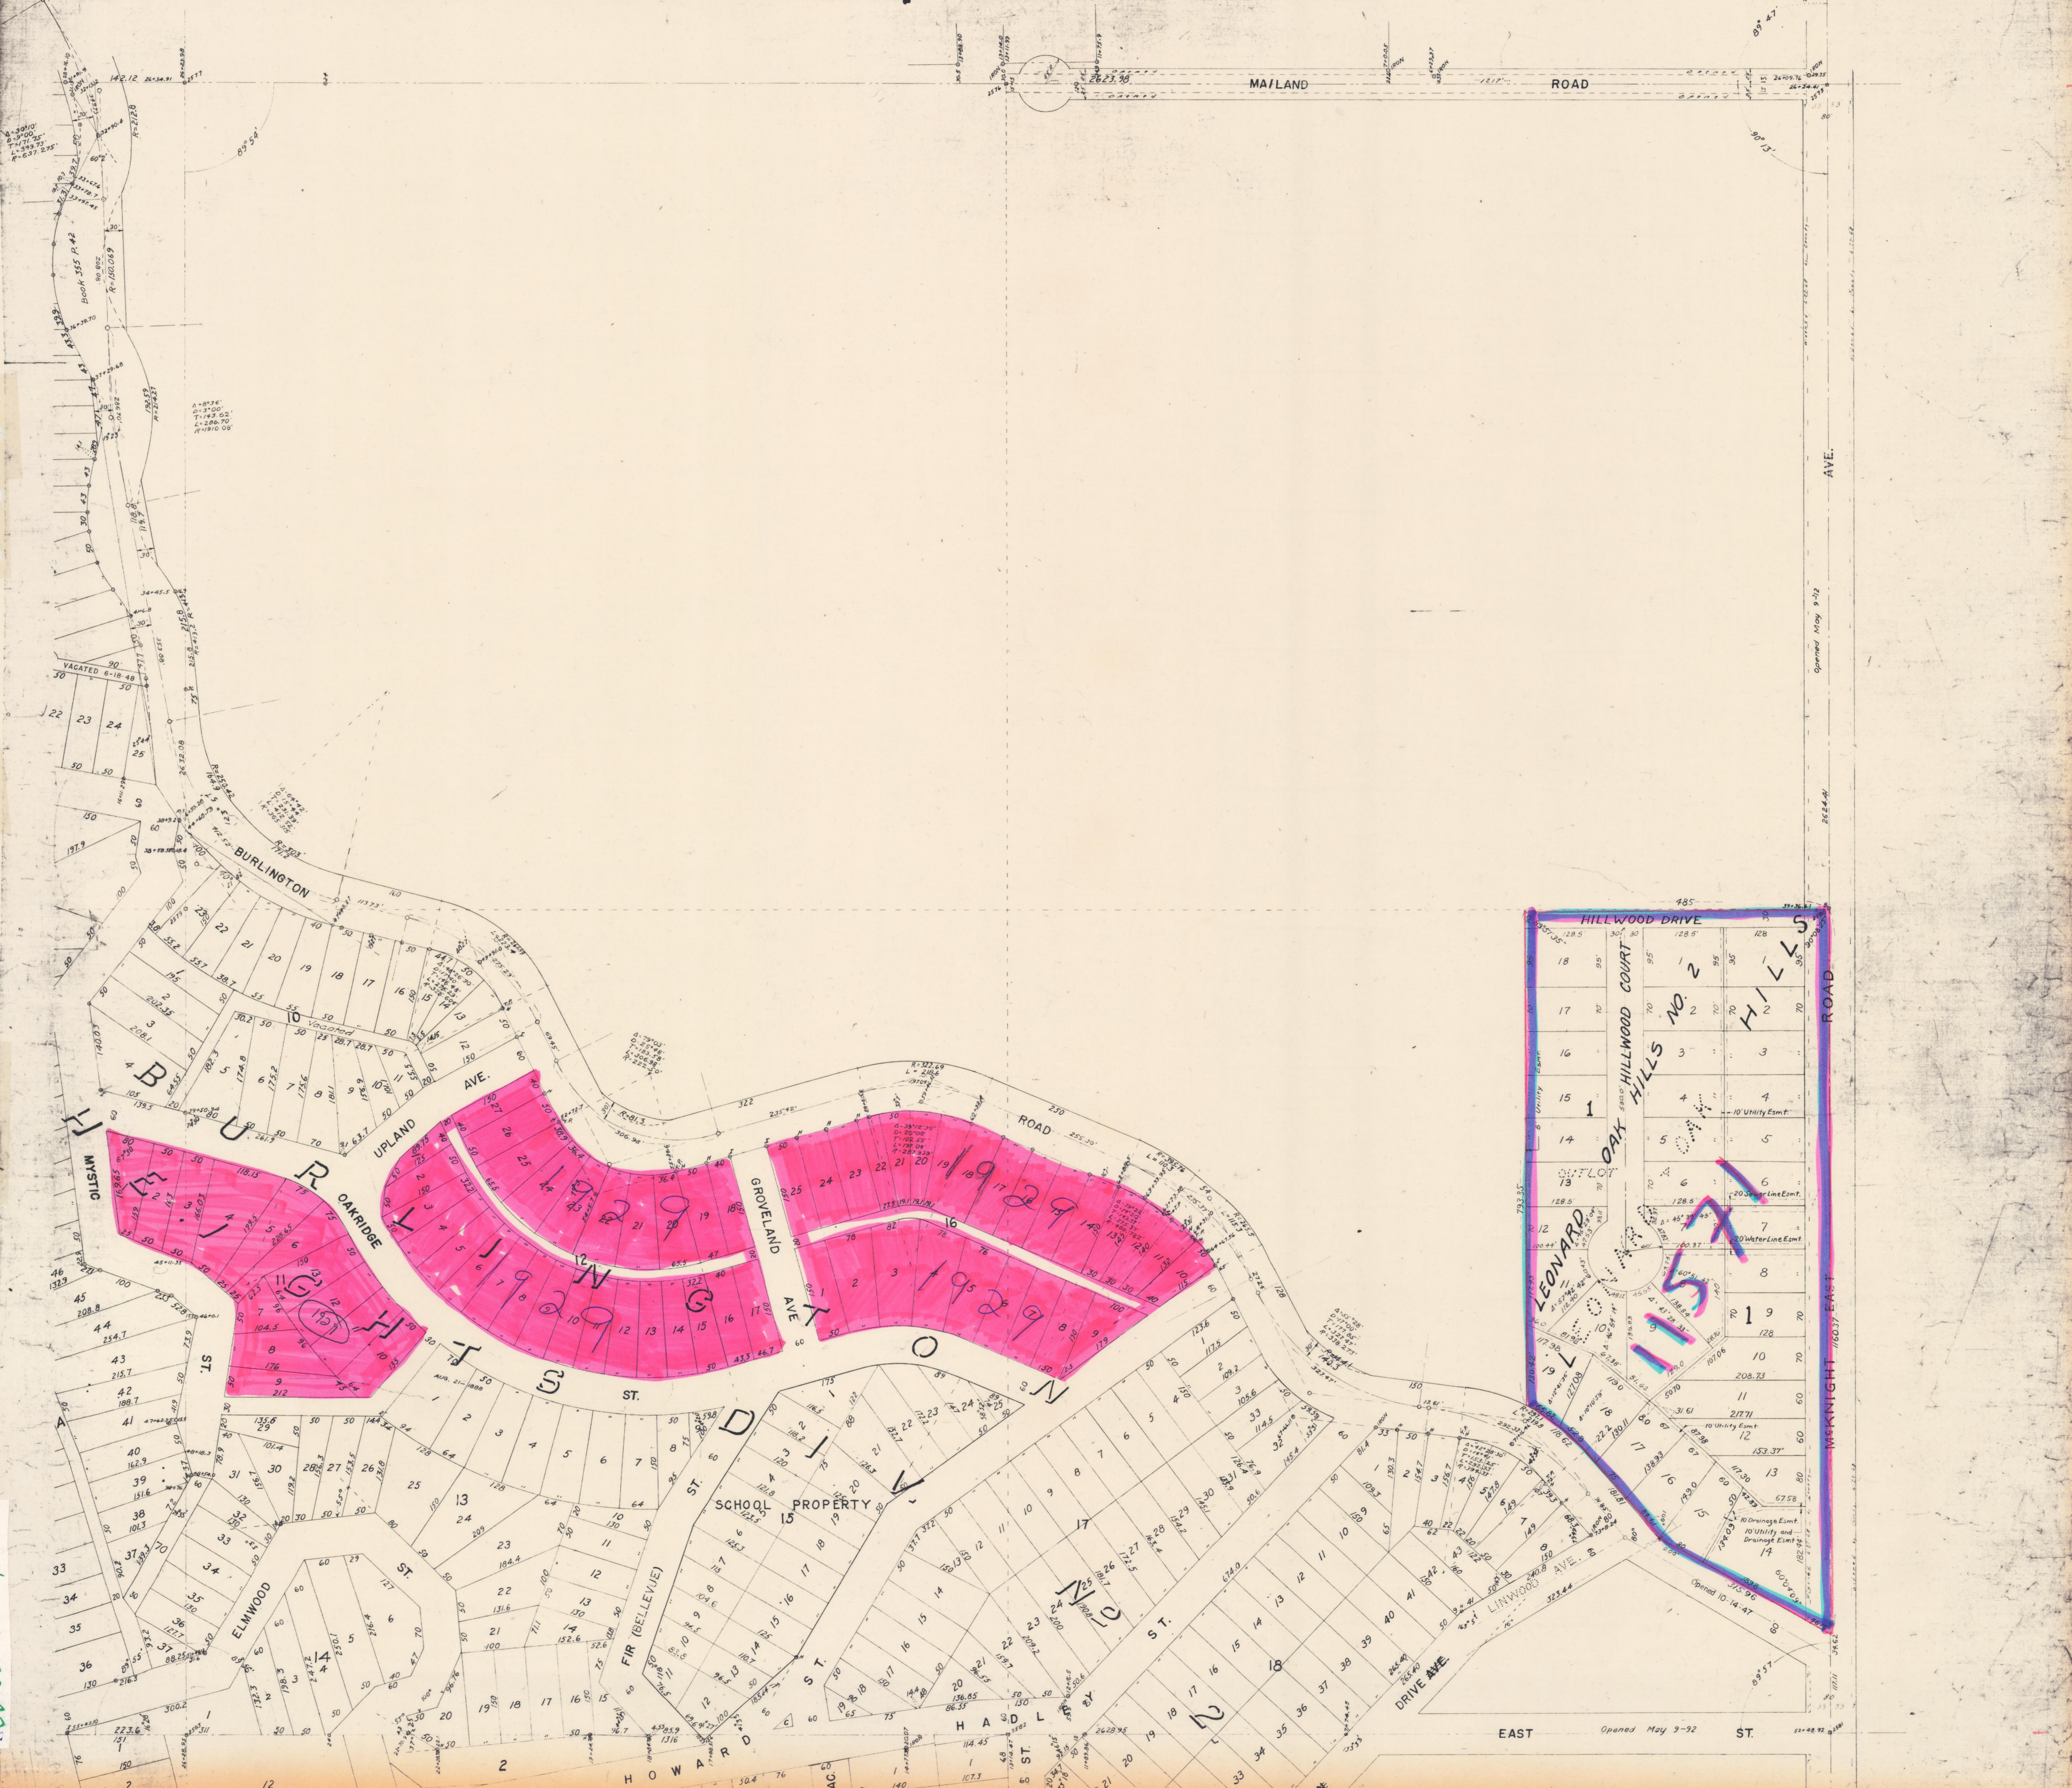

SE 1/4
11-28-22

Opened May 9-32

Opened May 9-32

Opened 10-14-47