


S.E. 1/4 Sec. 12-28, 23.

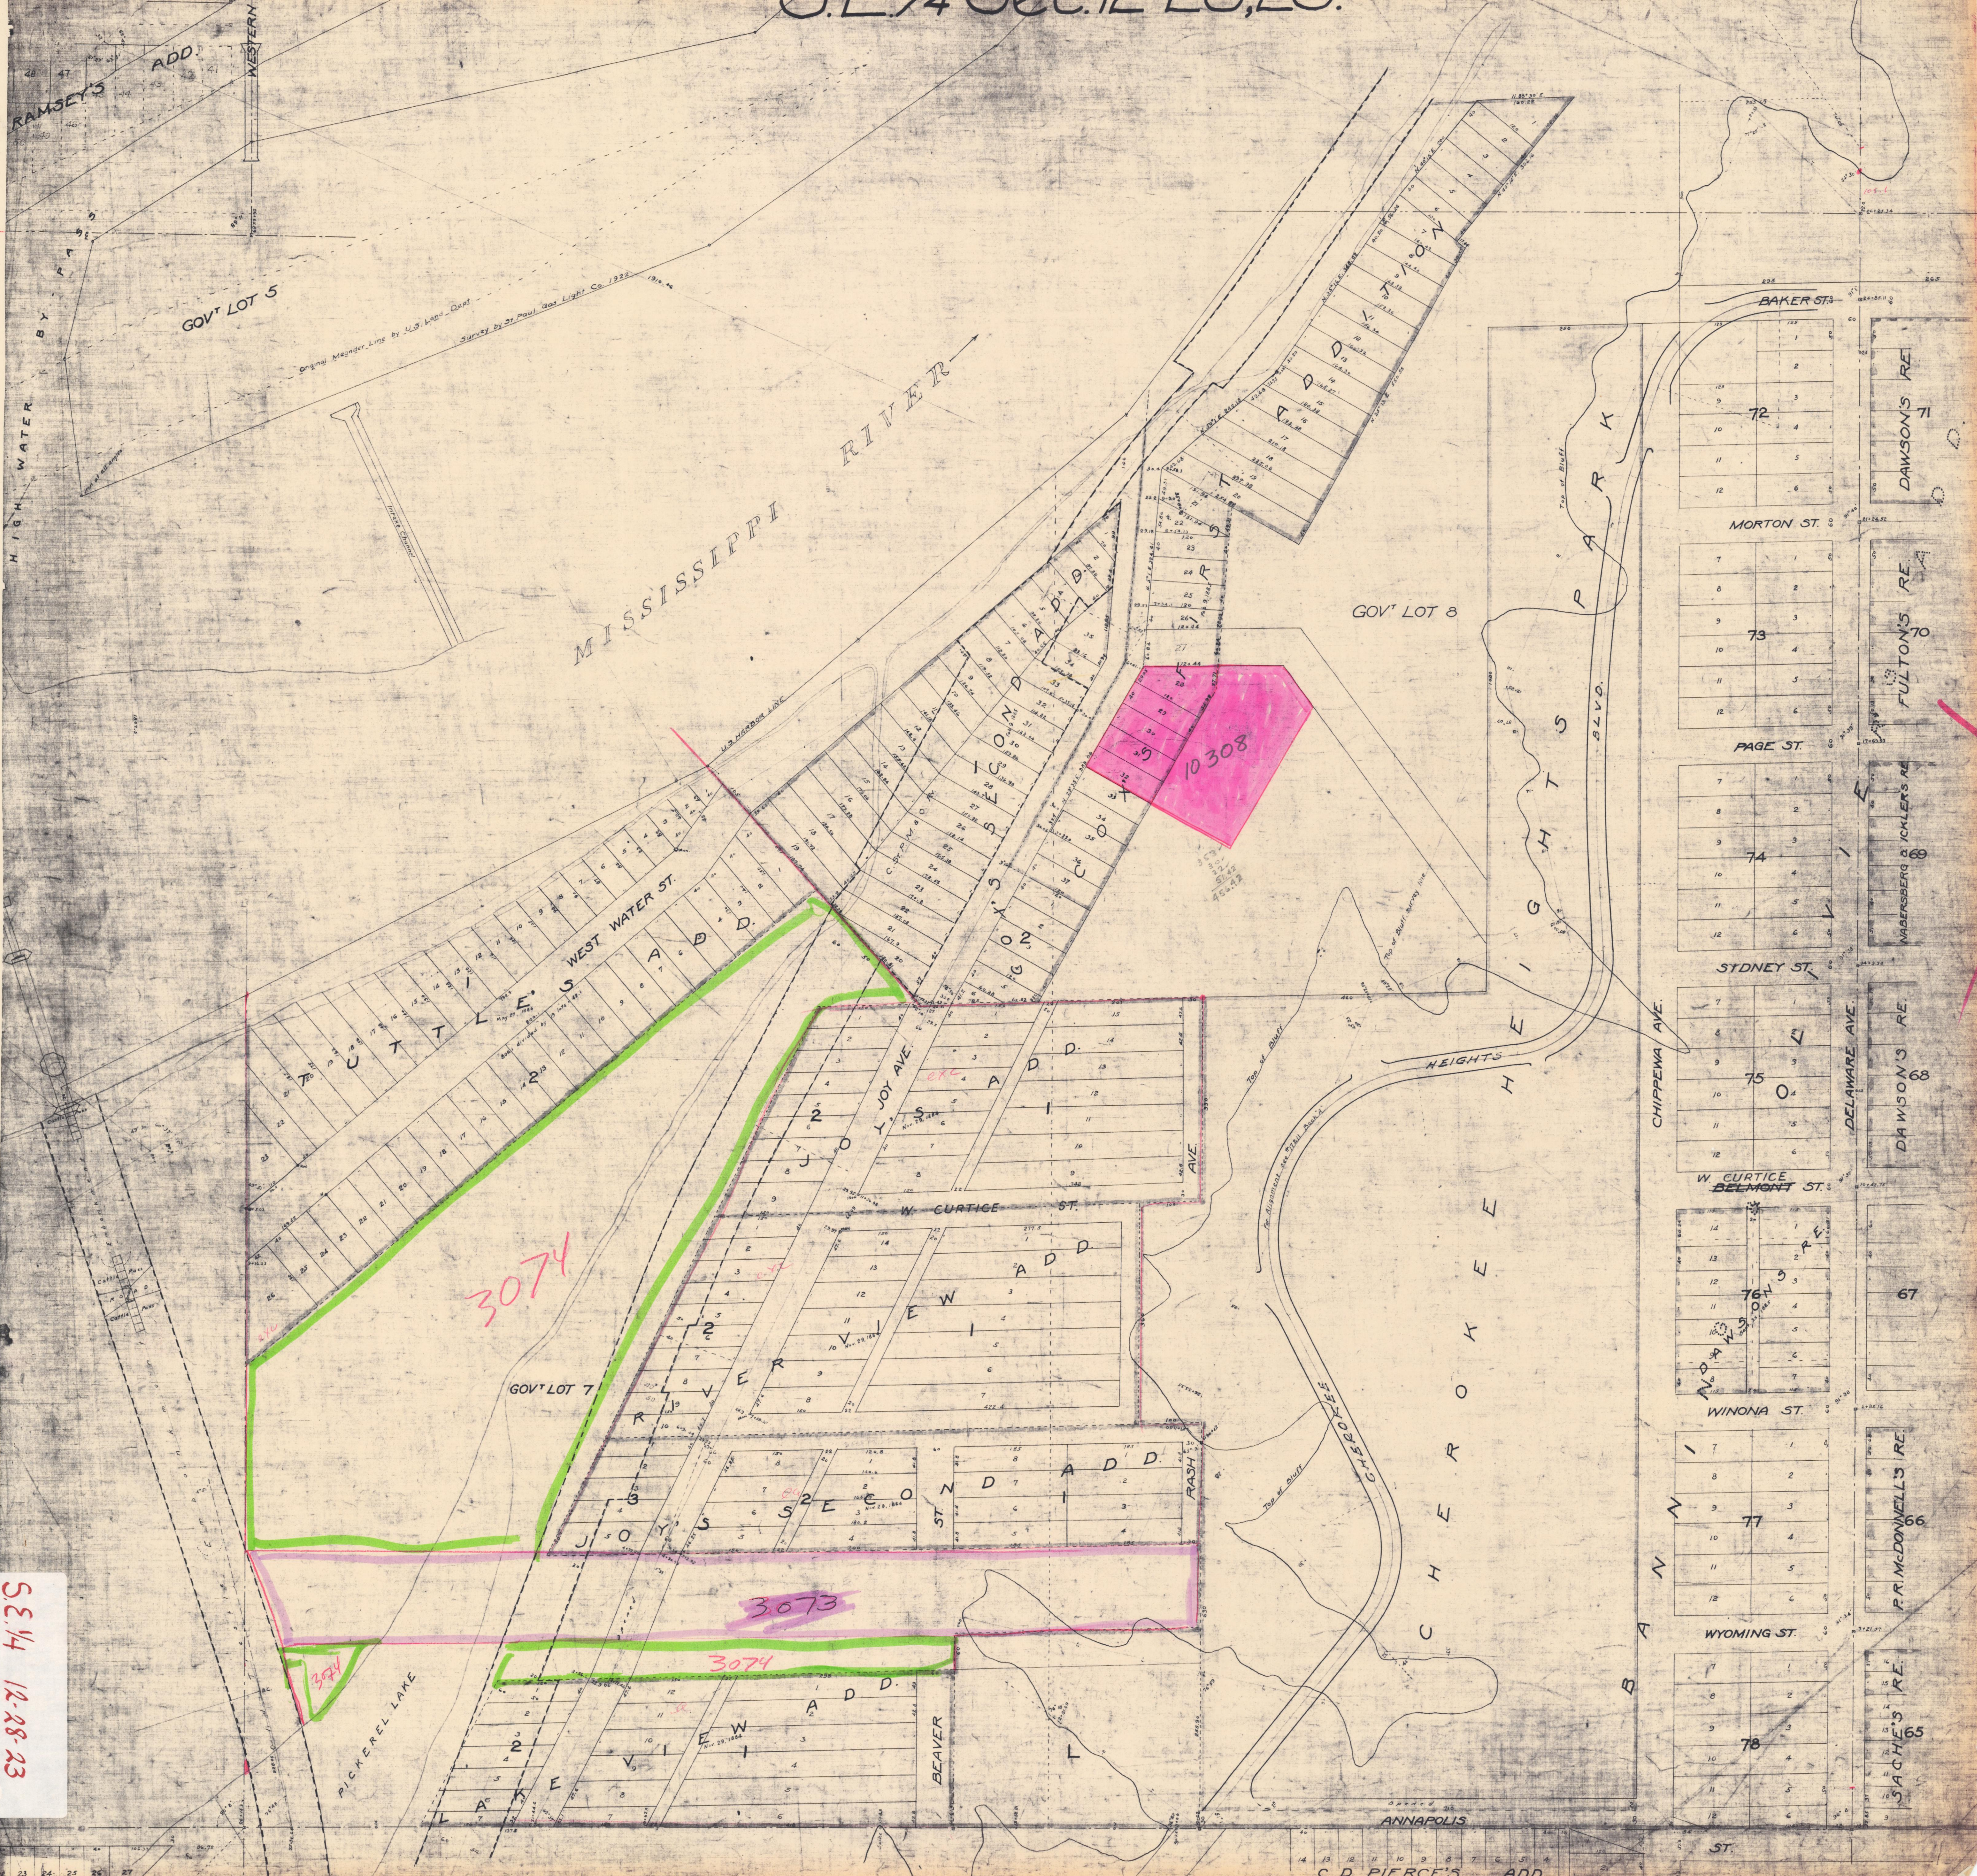

S.E. 1/4 12-28-23