

S.E. 1/4 - SEC. 2 - T. 28 - R. 23

BRYANT'S A.D.D. 4 5 6 4 5 6

BRYANT'S SUB. 9 8 7 6 5 4 3 2 1 60 63 100

H O L C O M B E S A D D. 15 16 17 18 19 20 21 22 23 24 25 26 27 28 29 30 40 60

ADD.

PARK




























SUMMIT

ADD.

AVON

MADE

LINWOOD

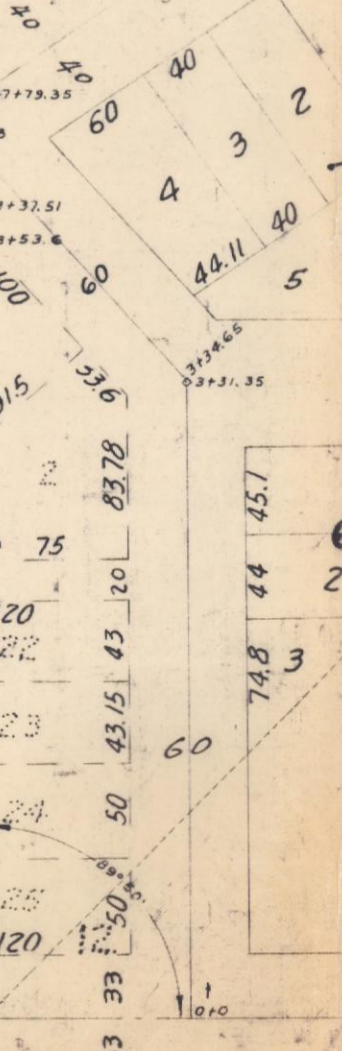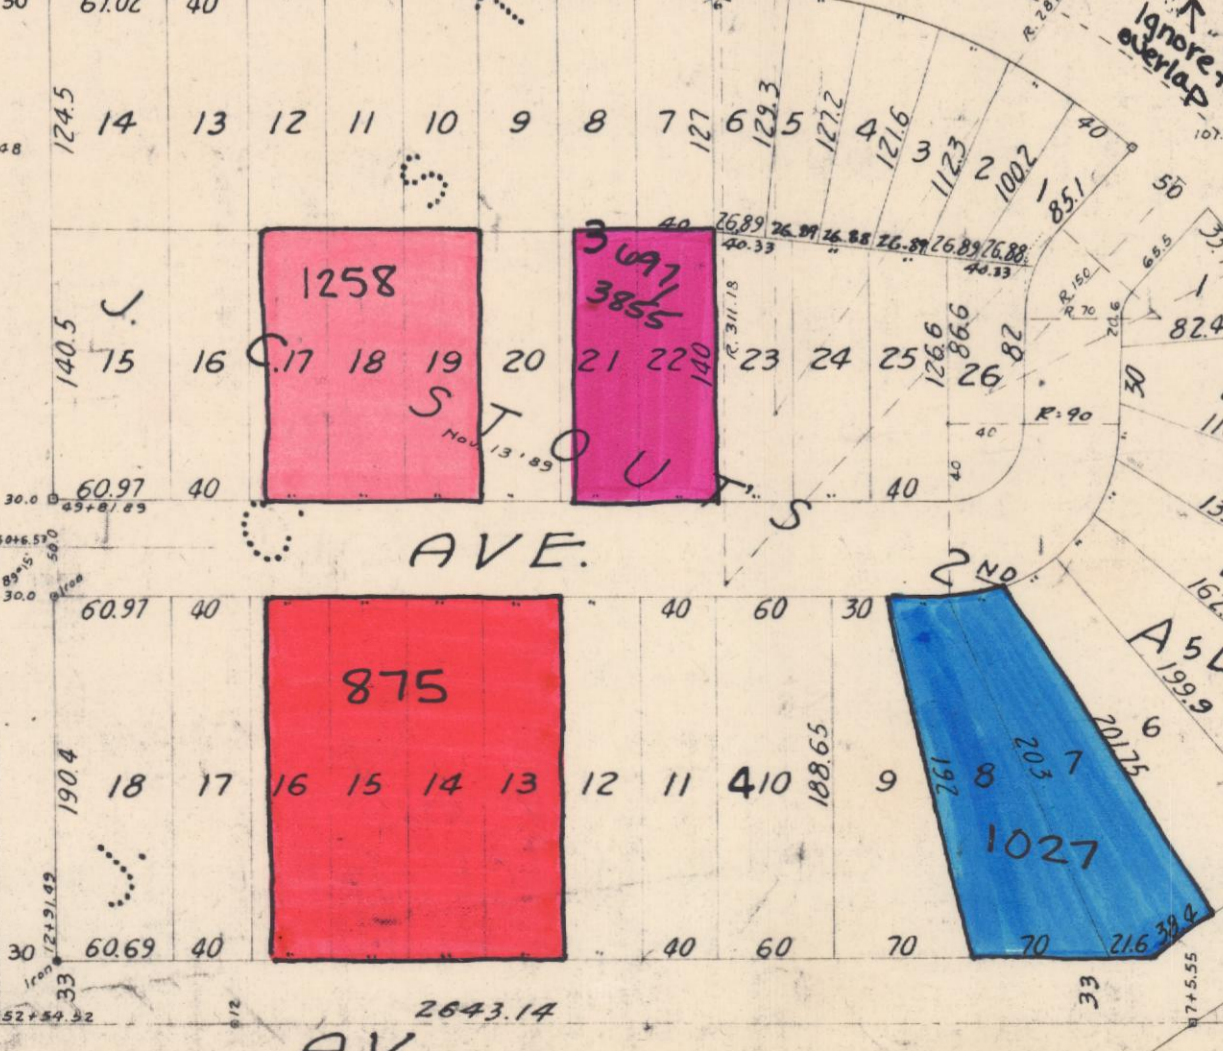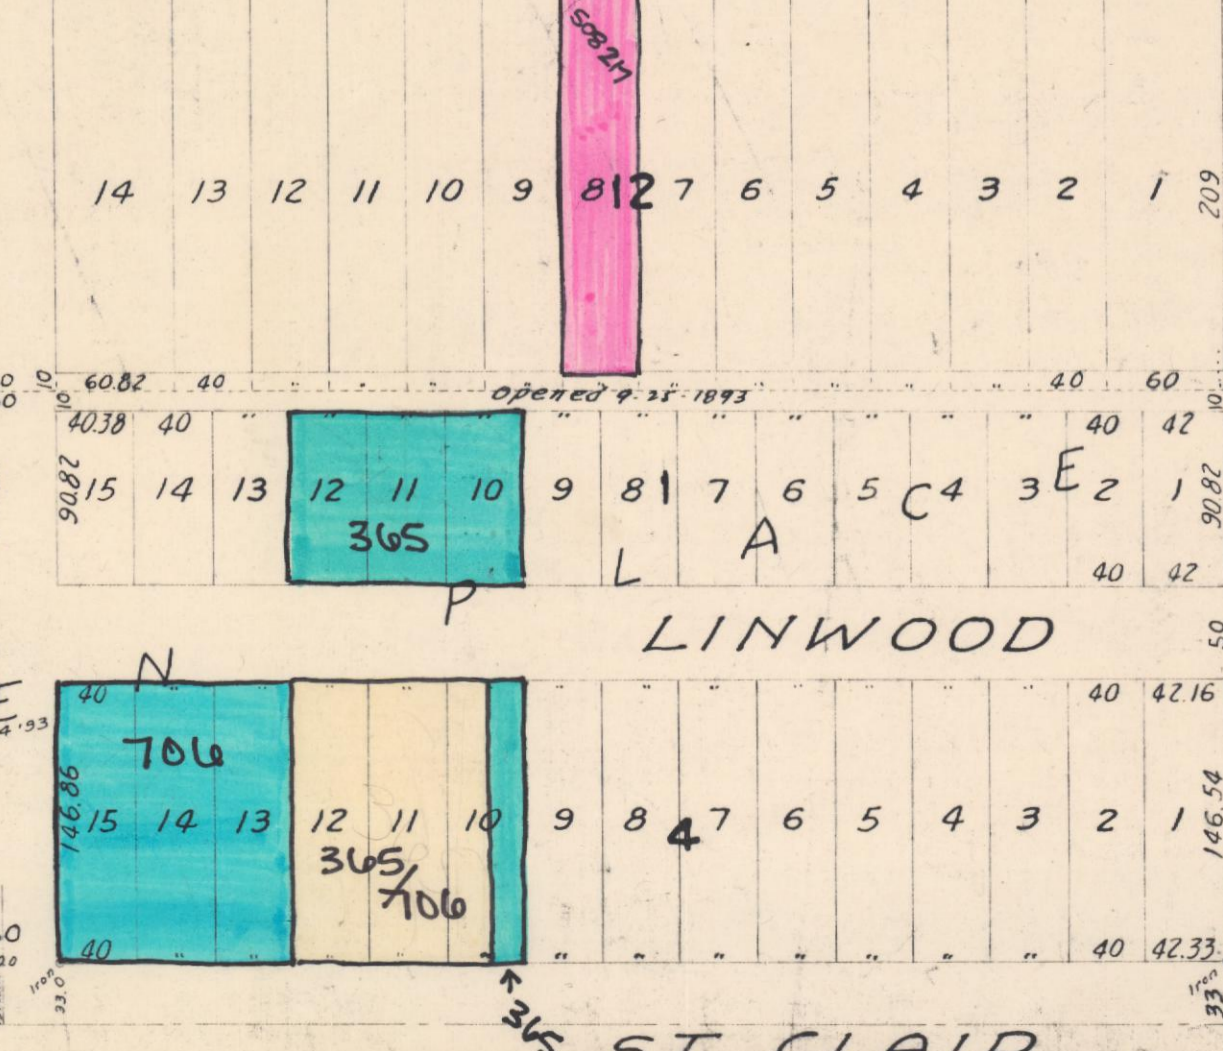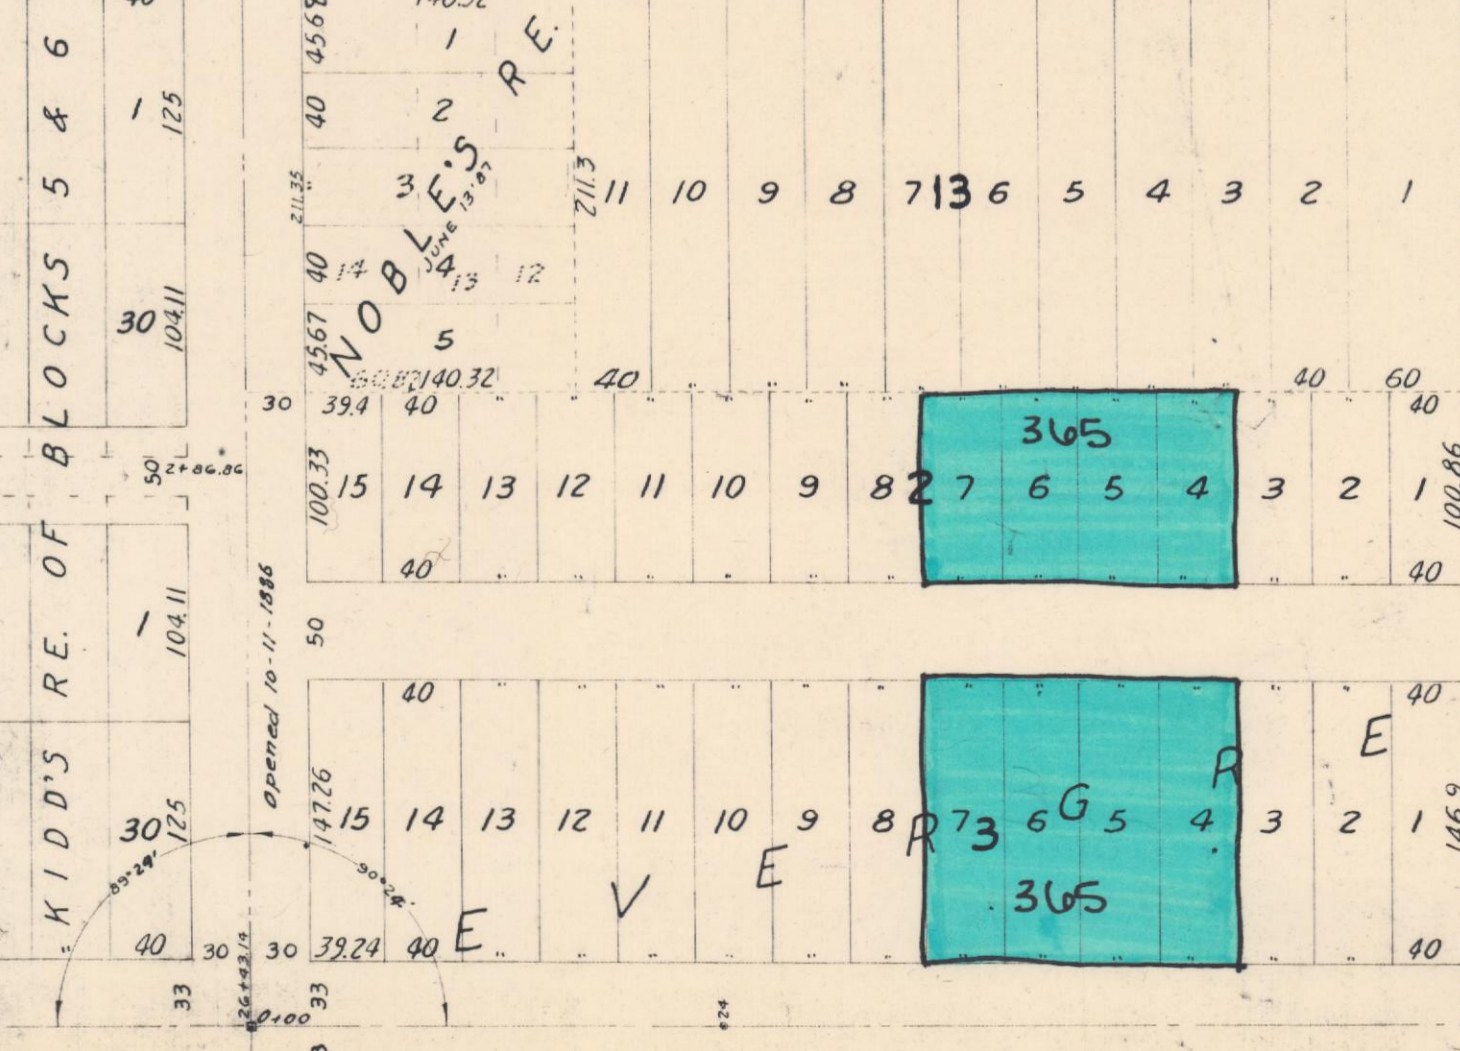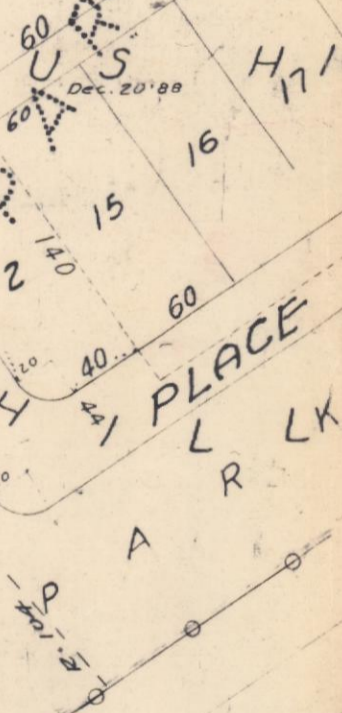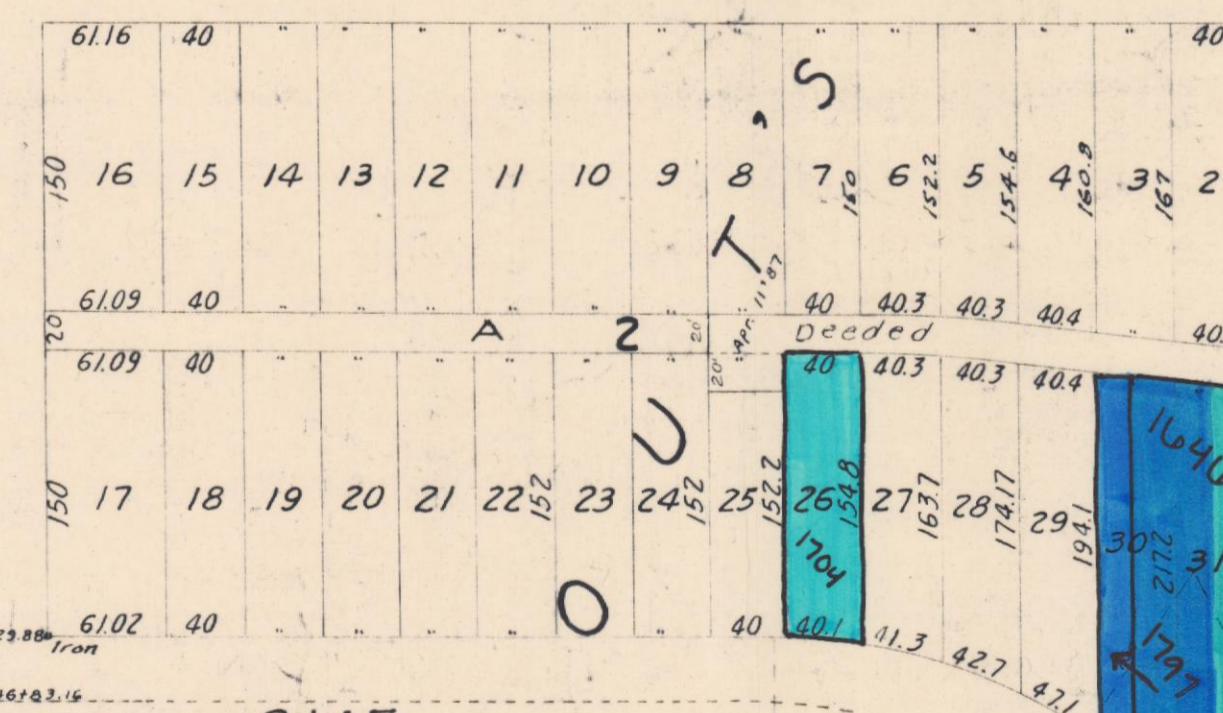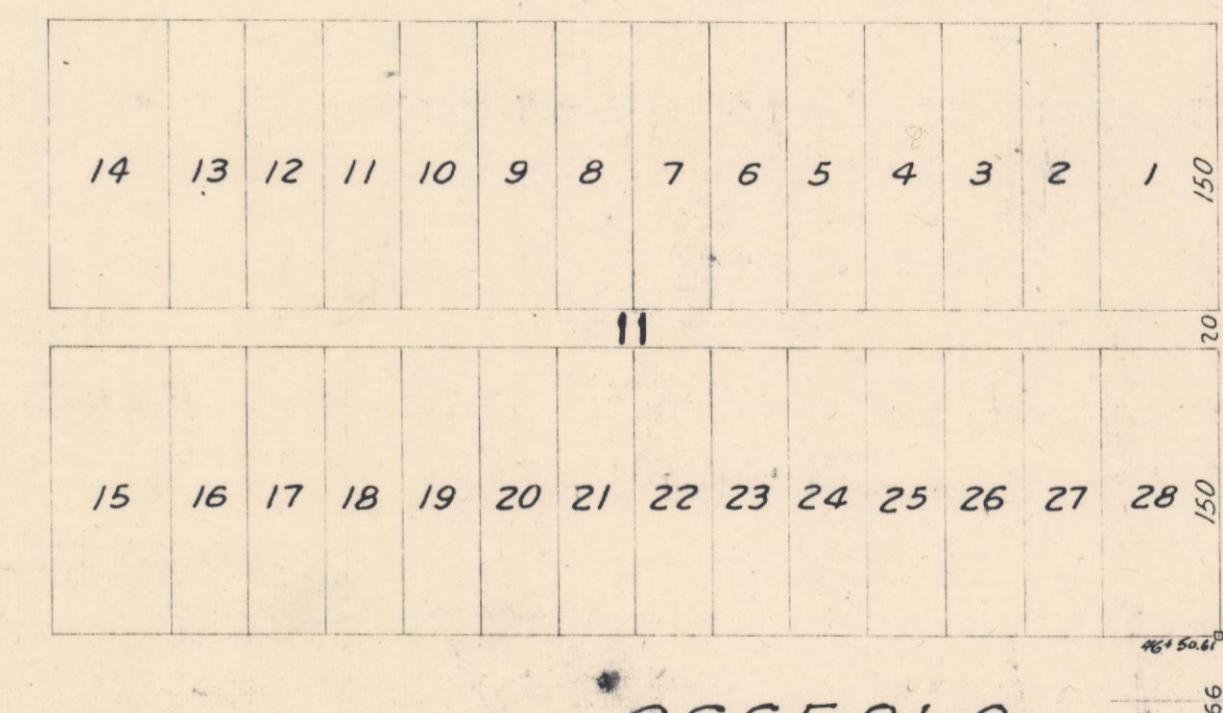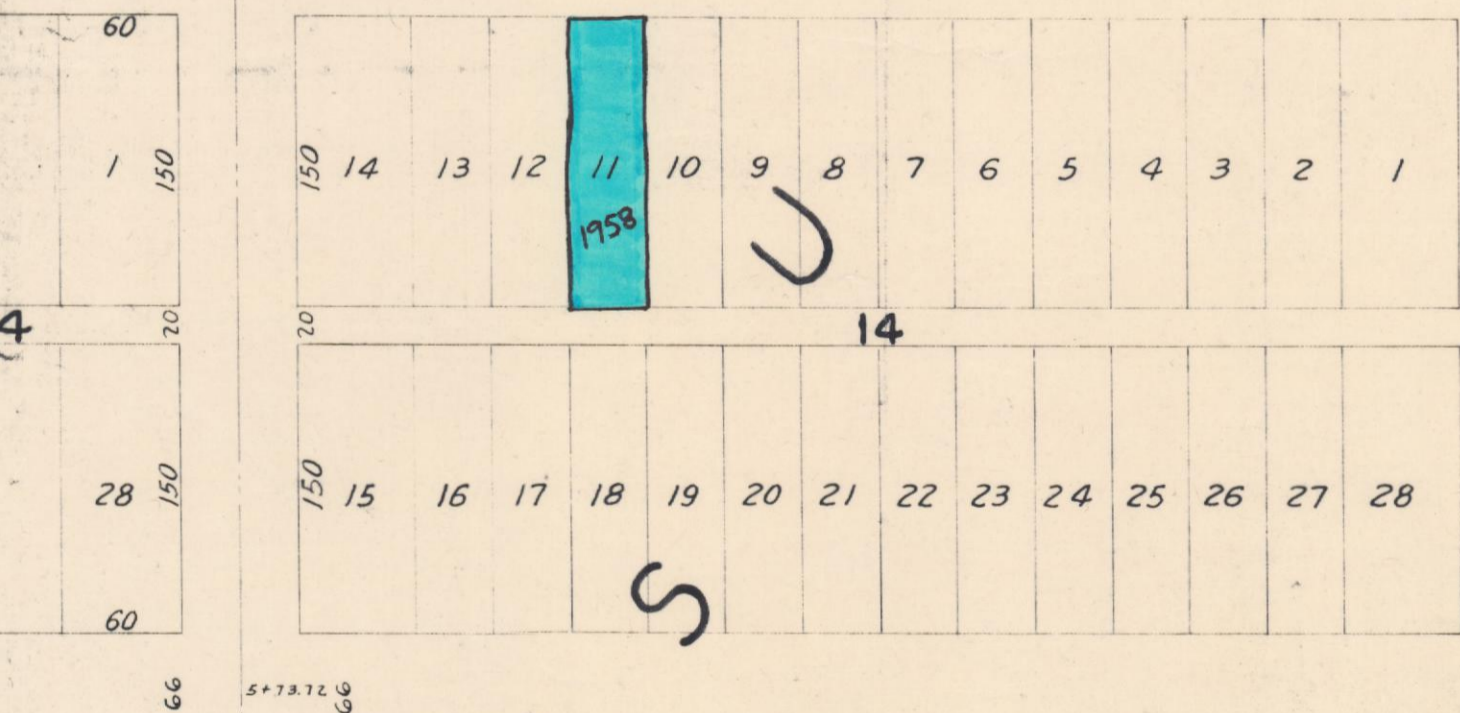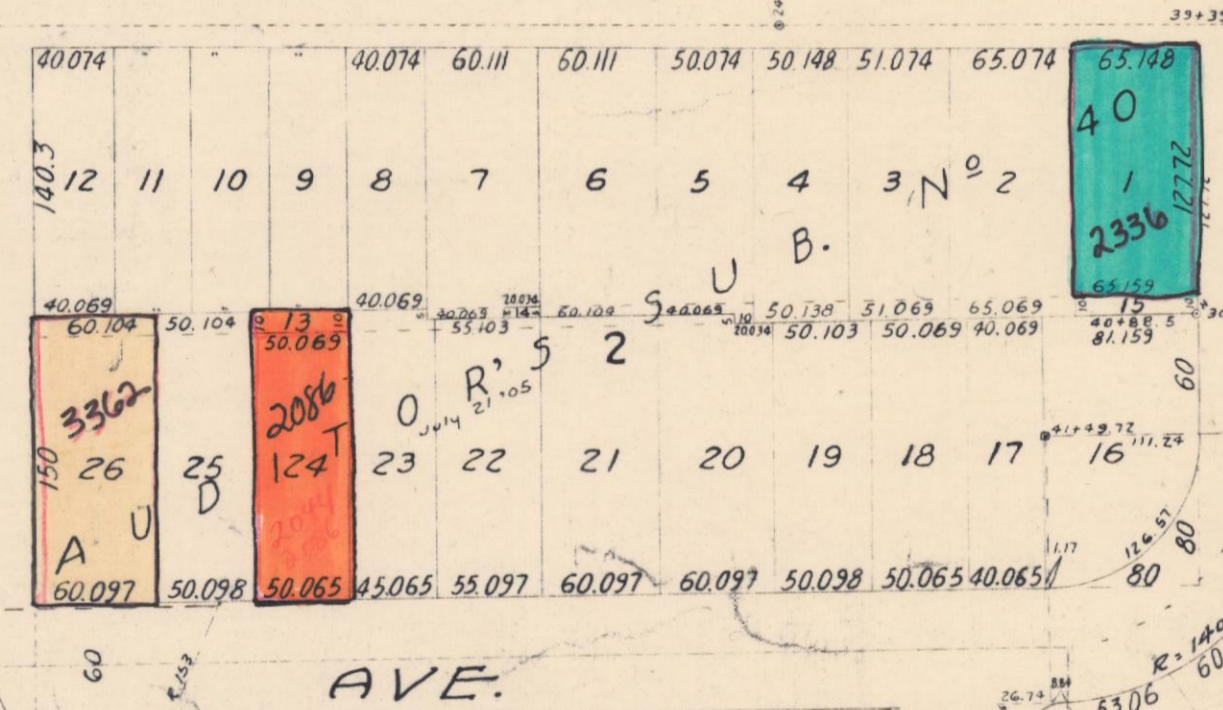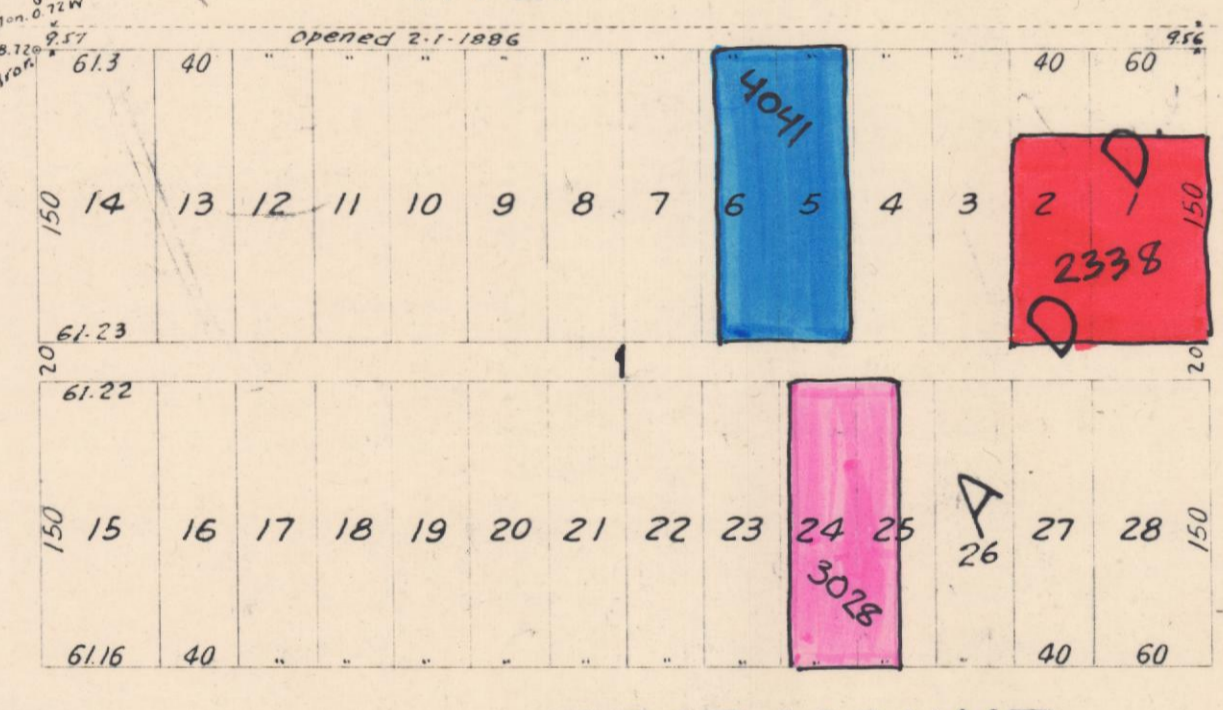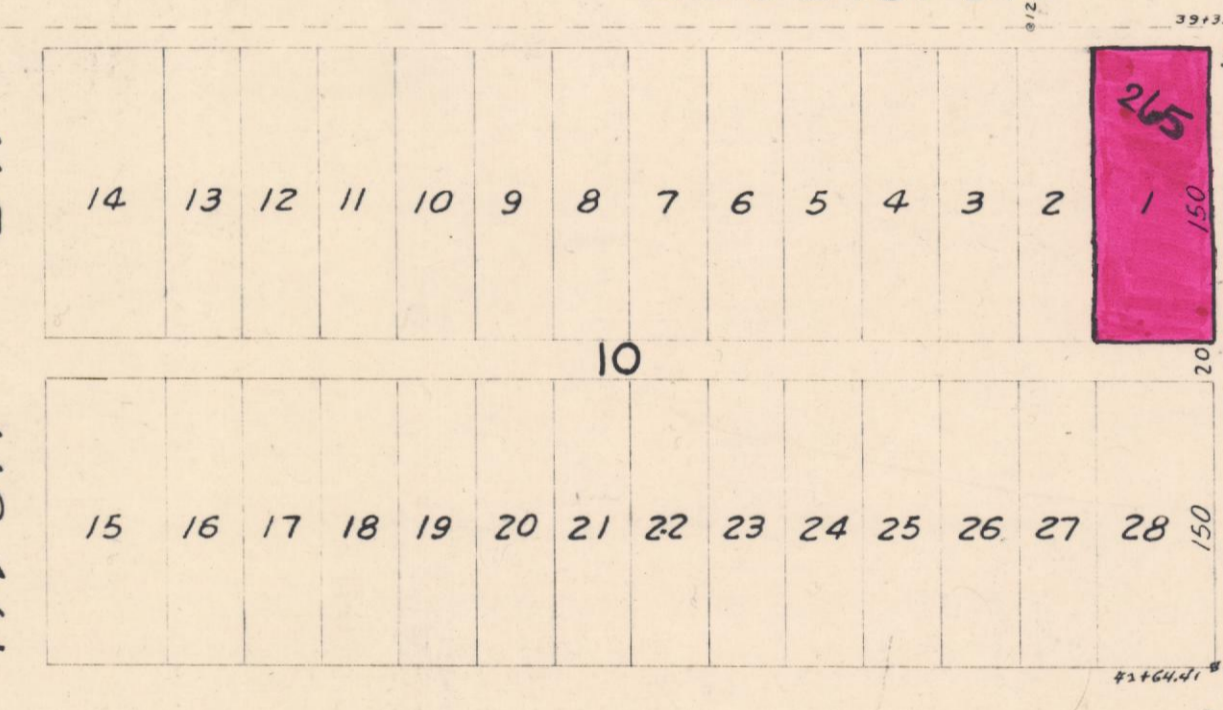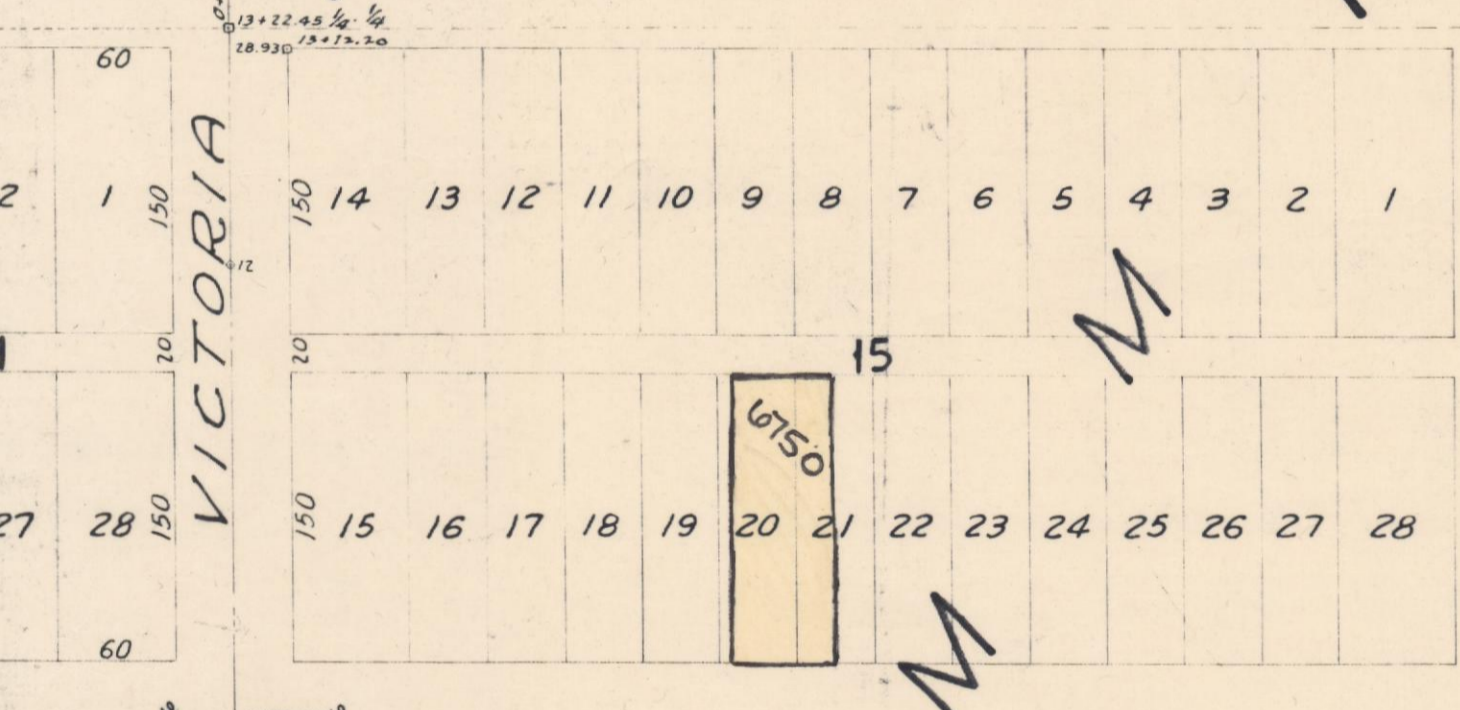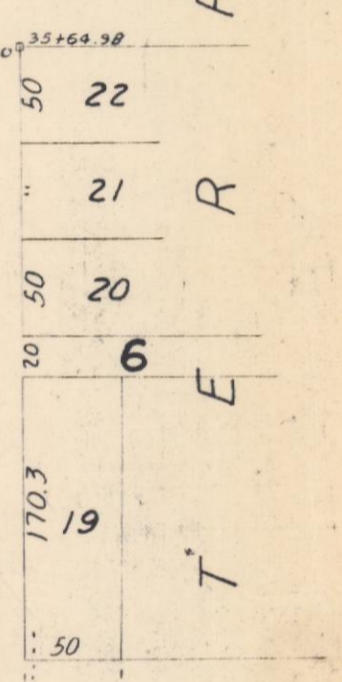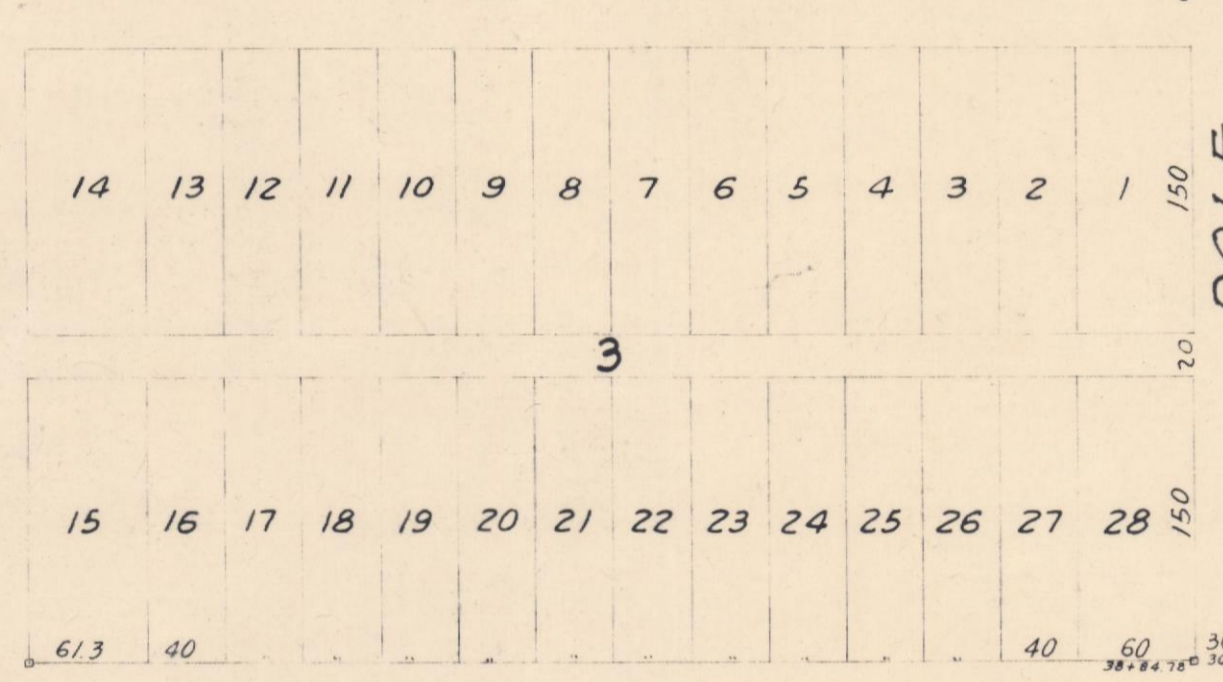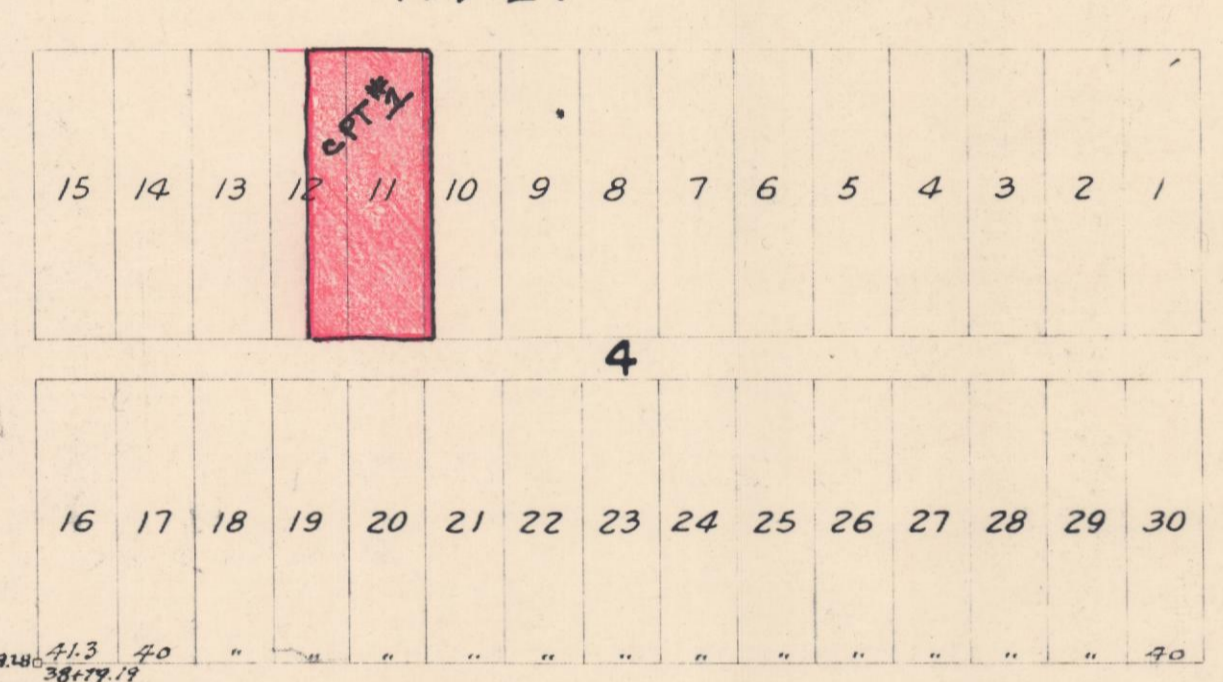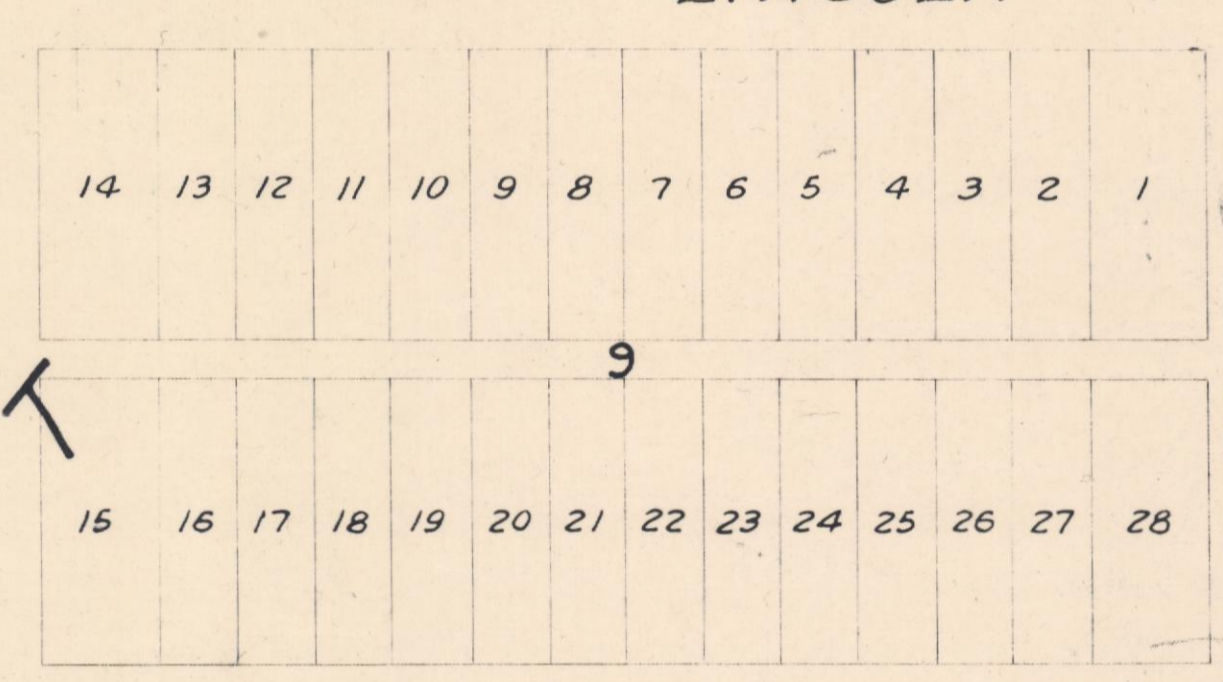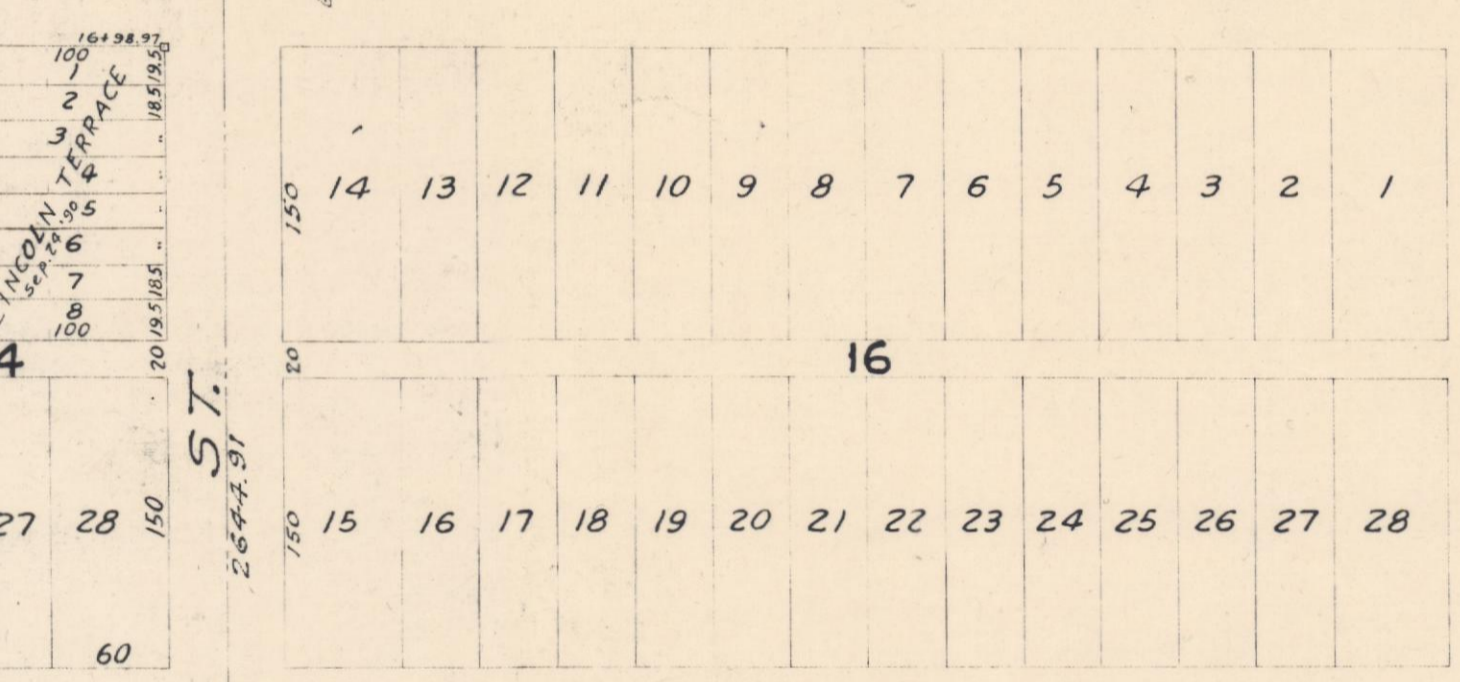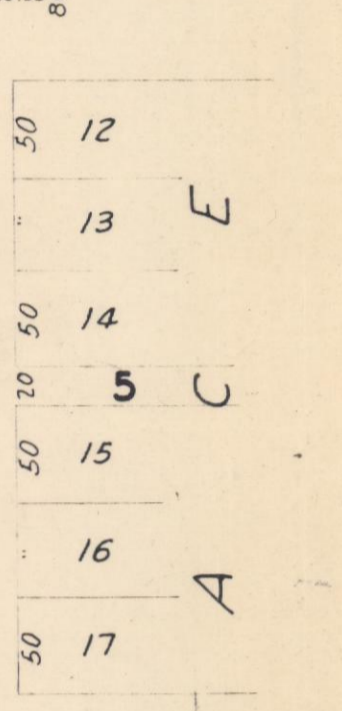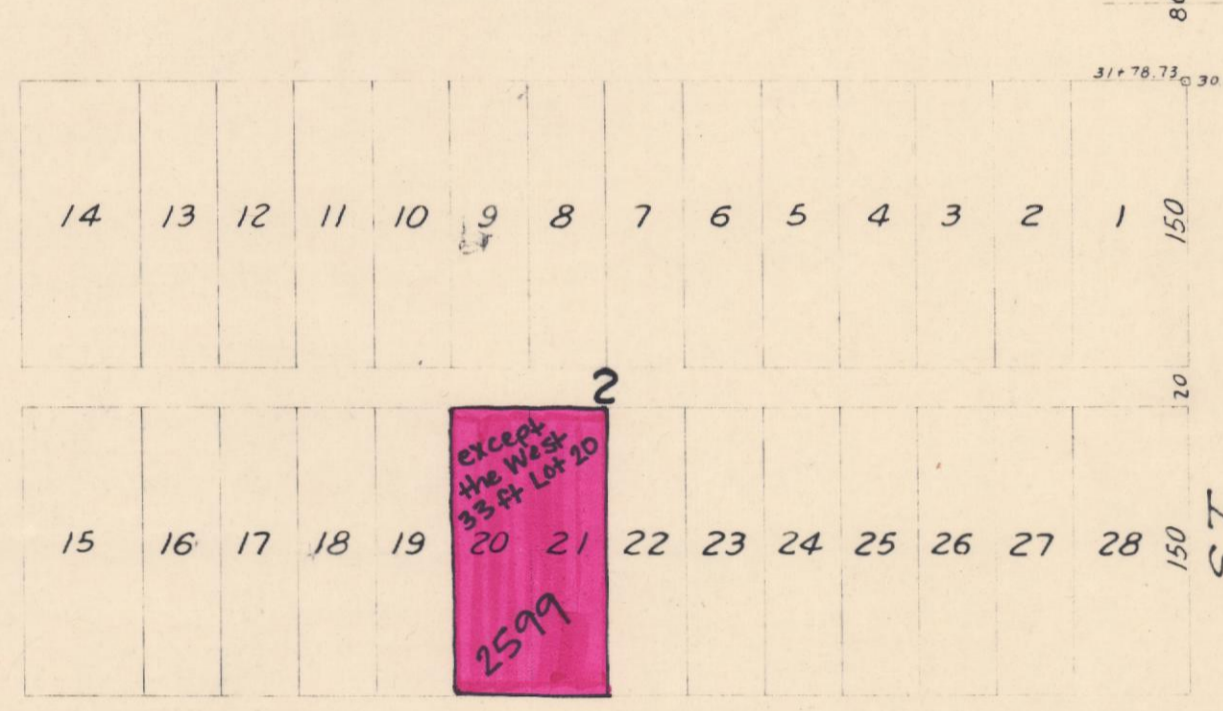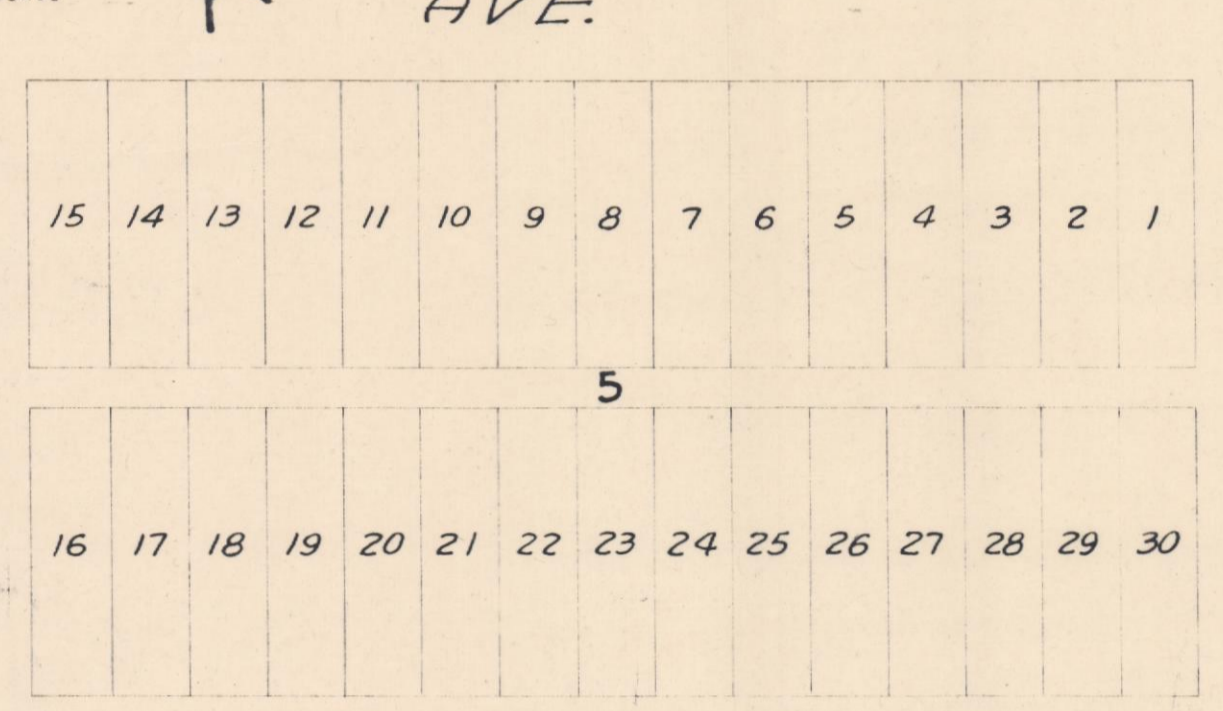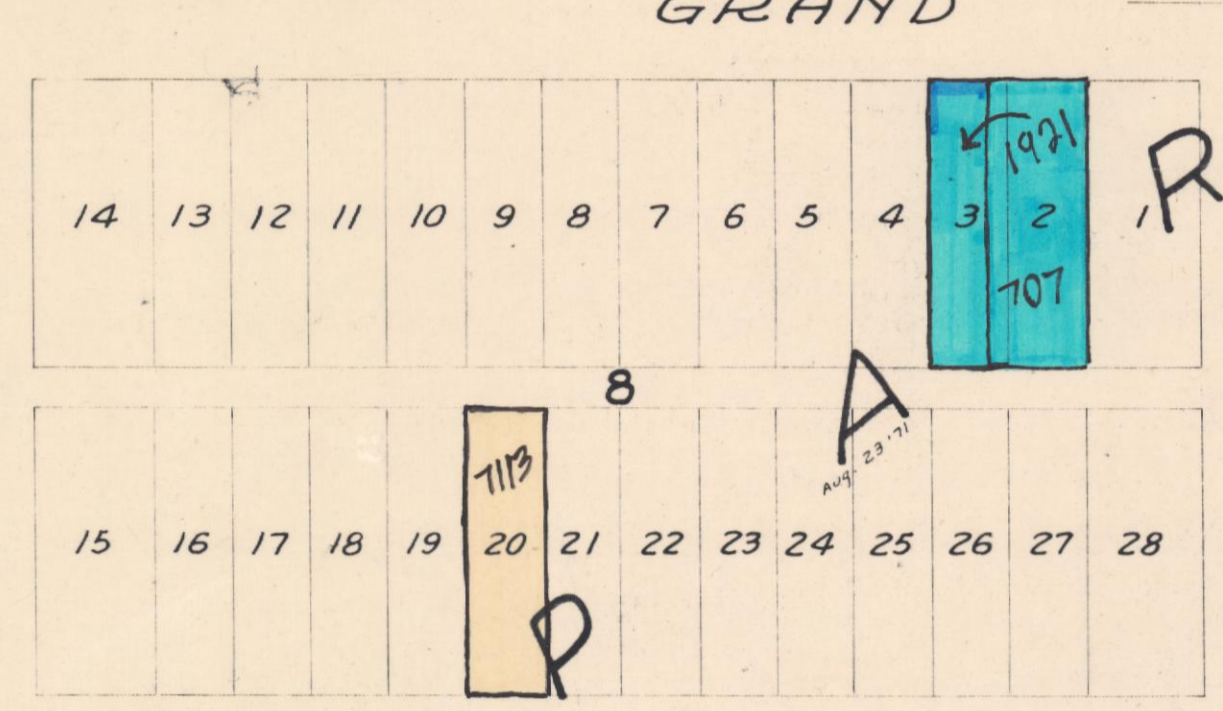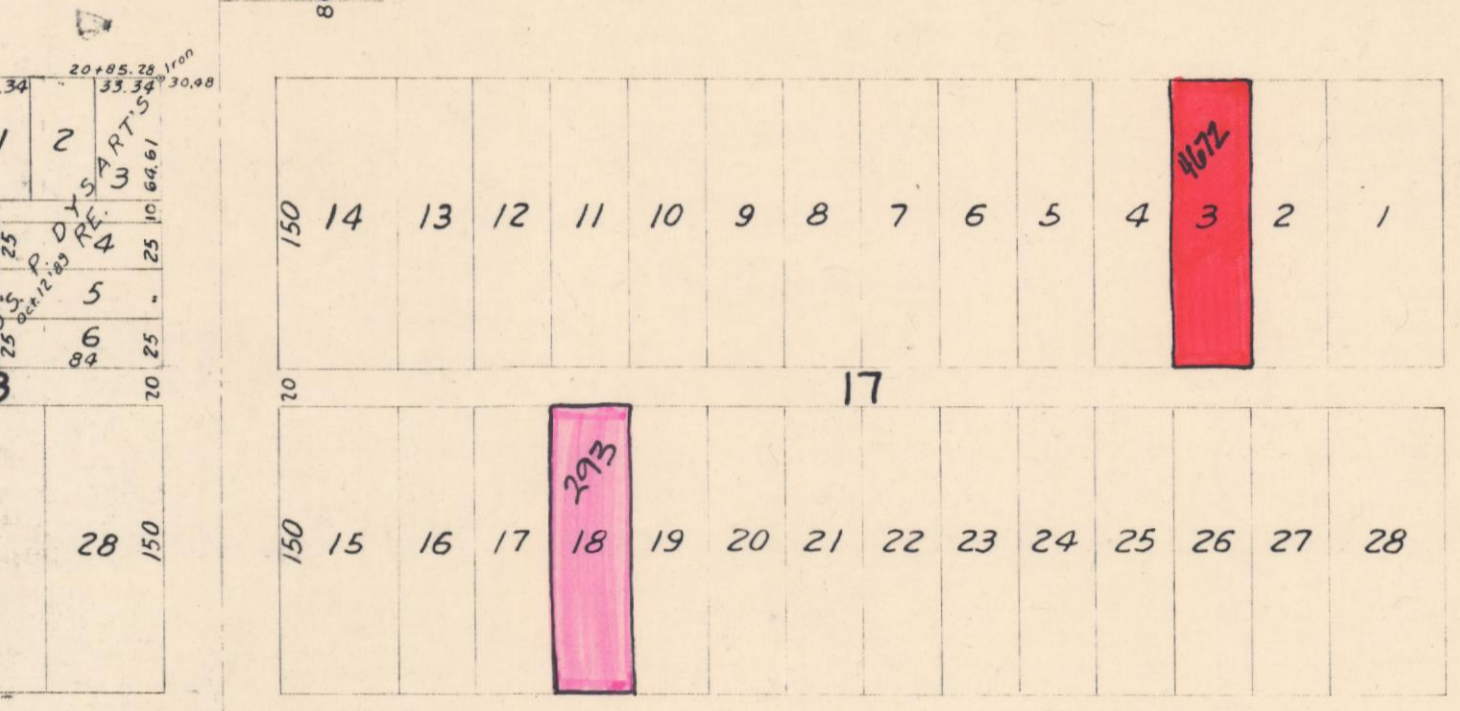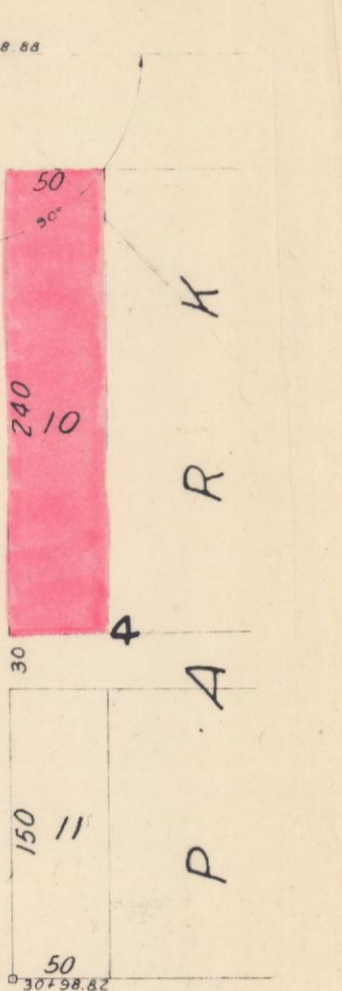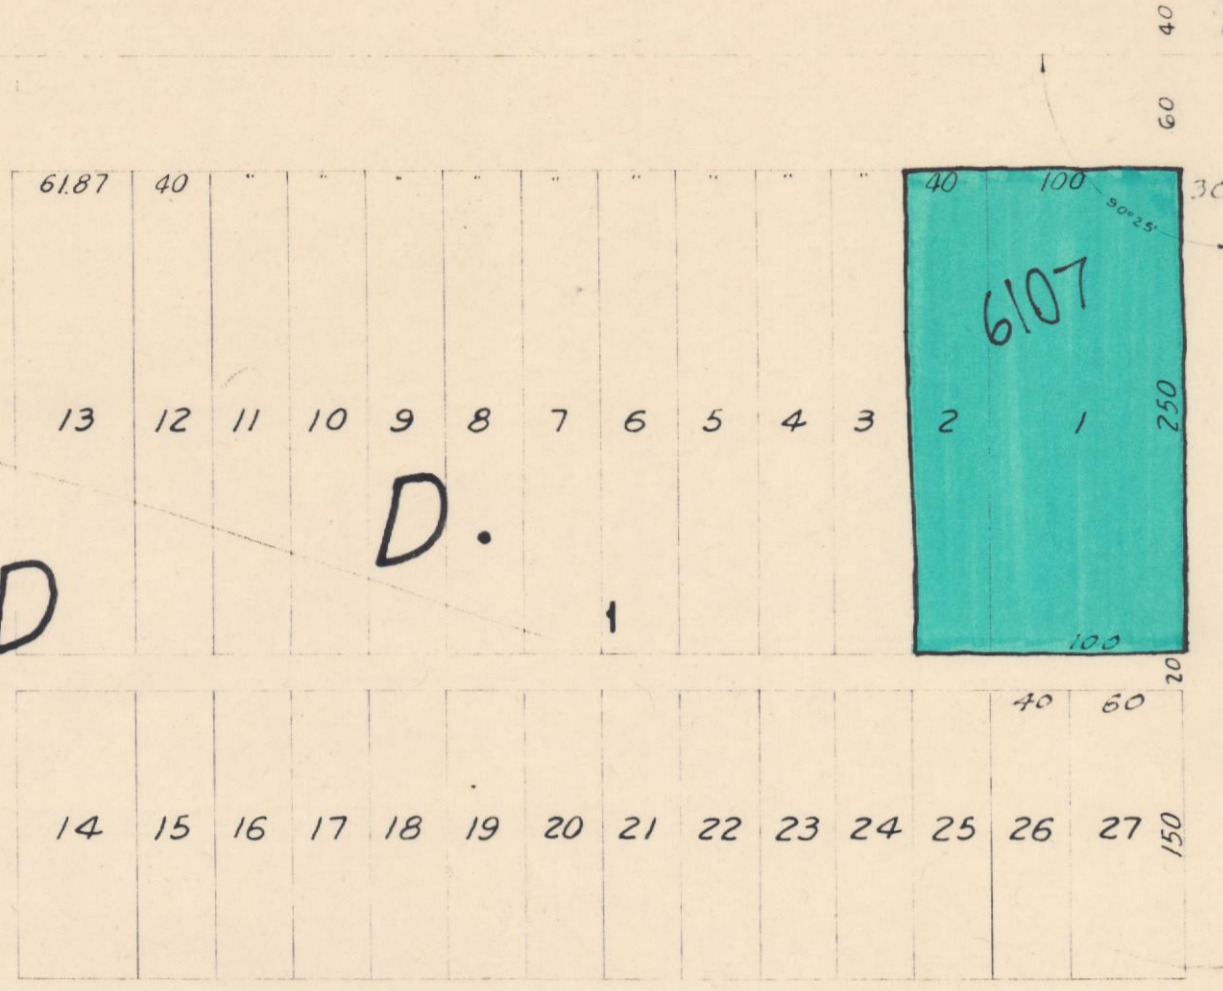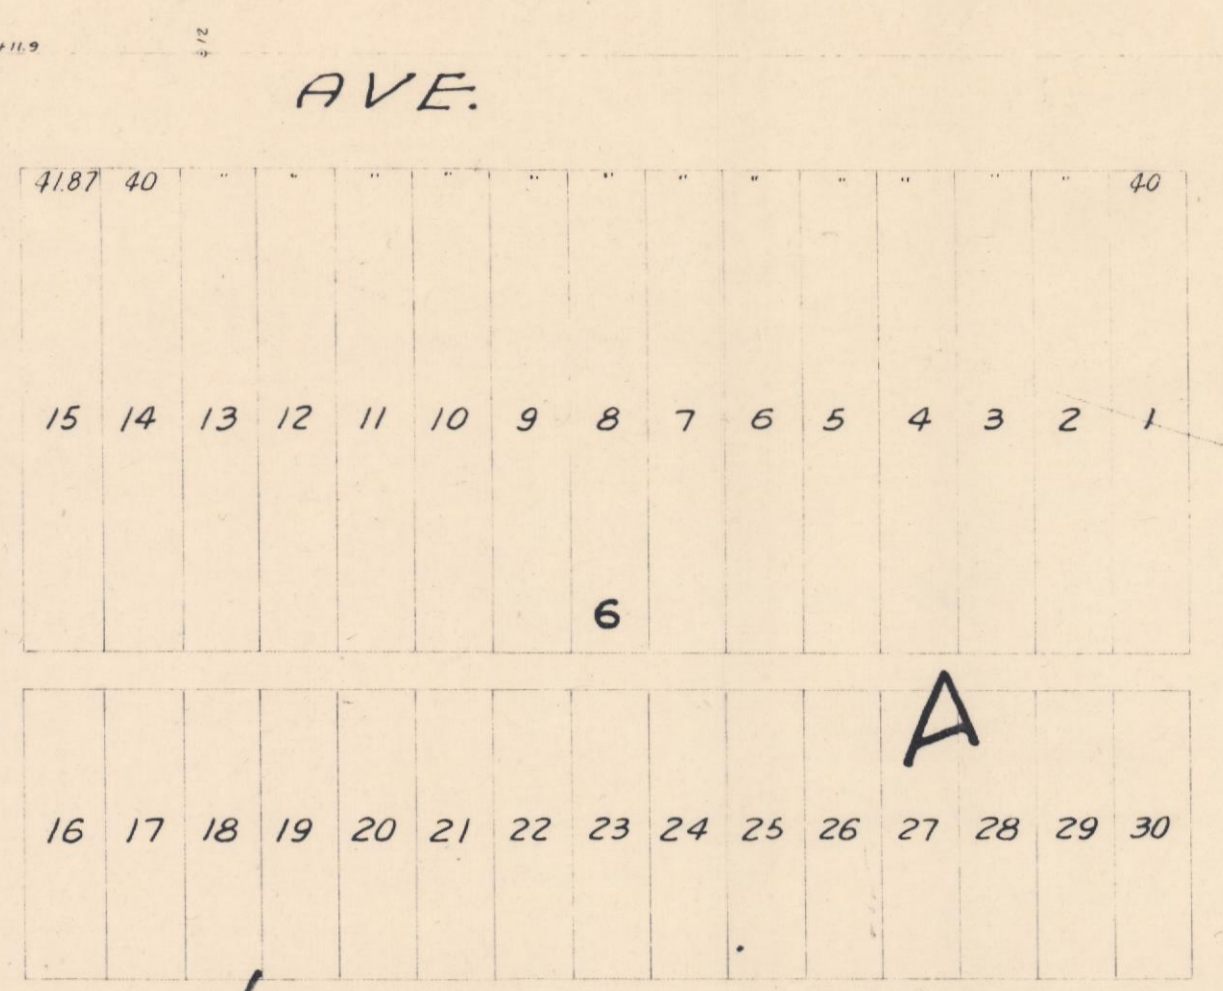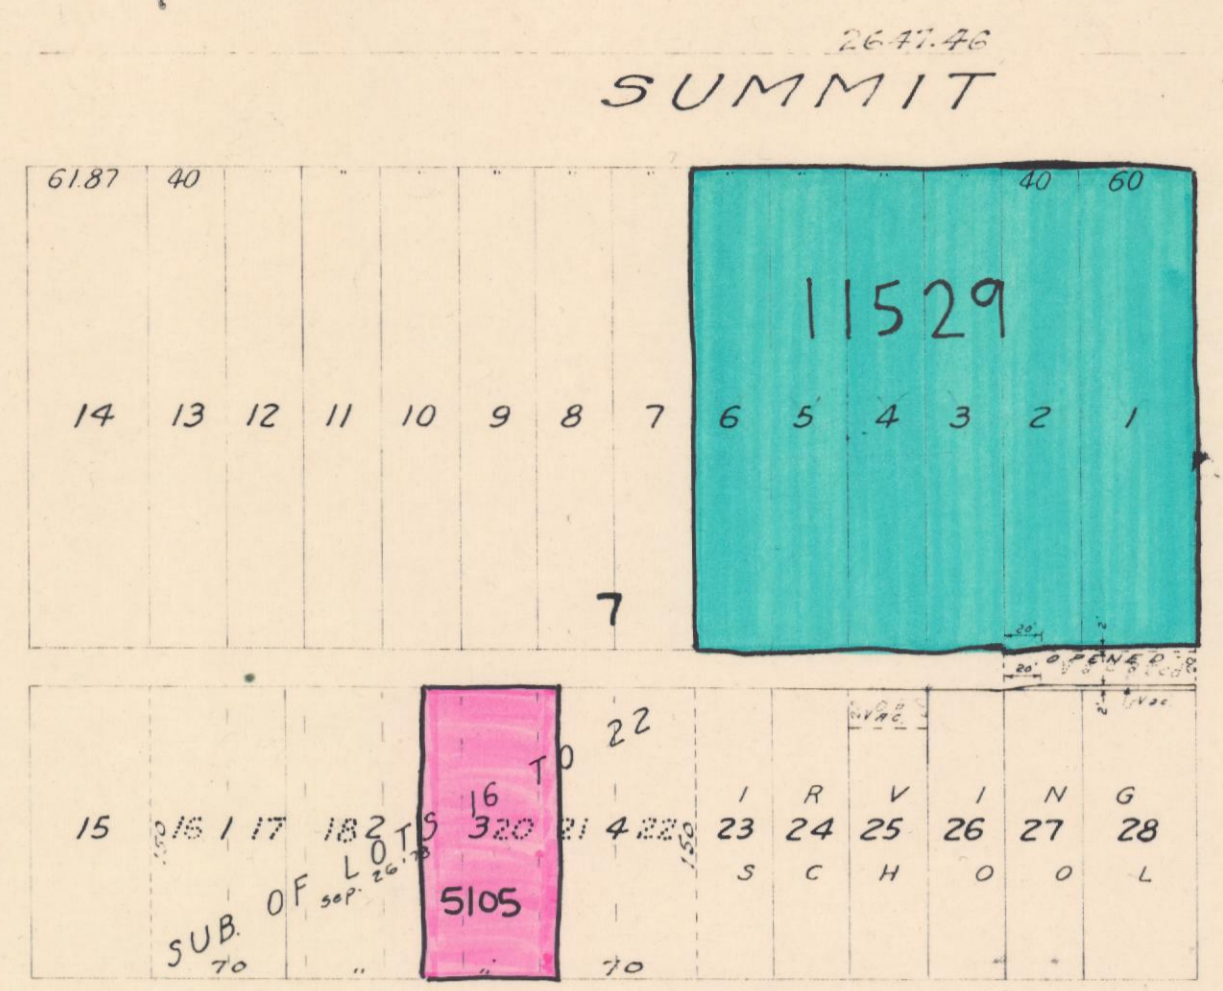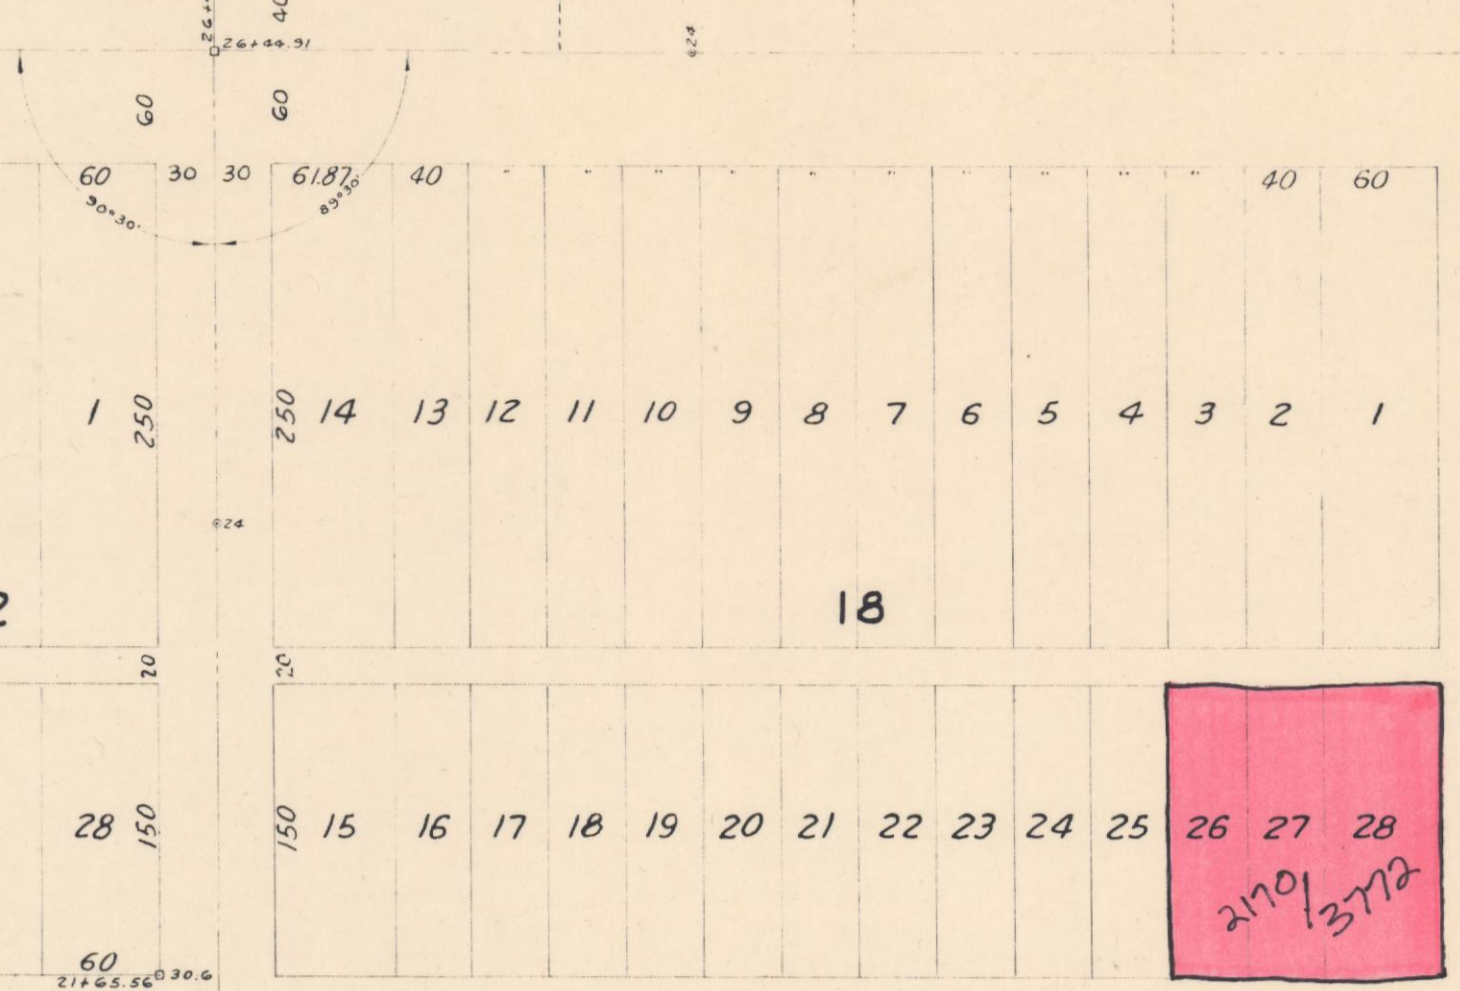

SE 1/4 2-28-23

L I N W O O D P A R K