


SE 1/4 21-28-23

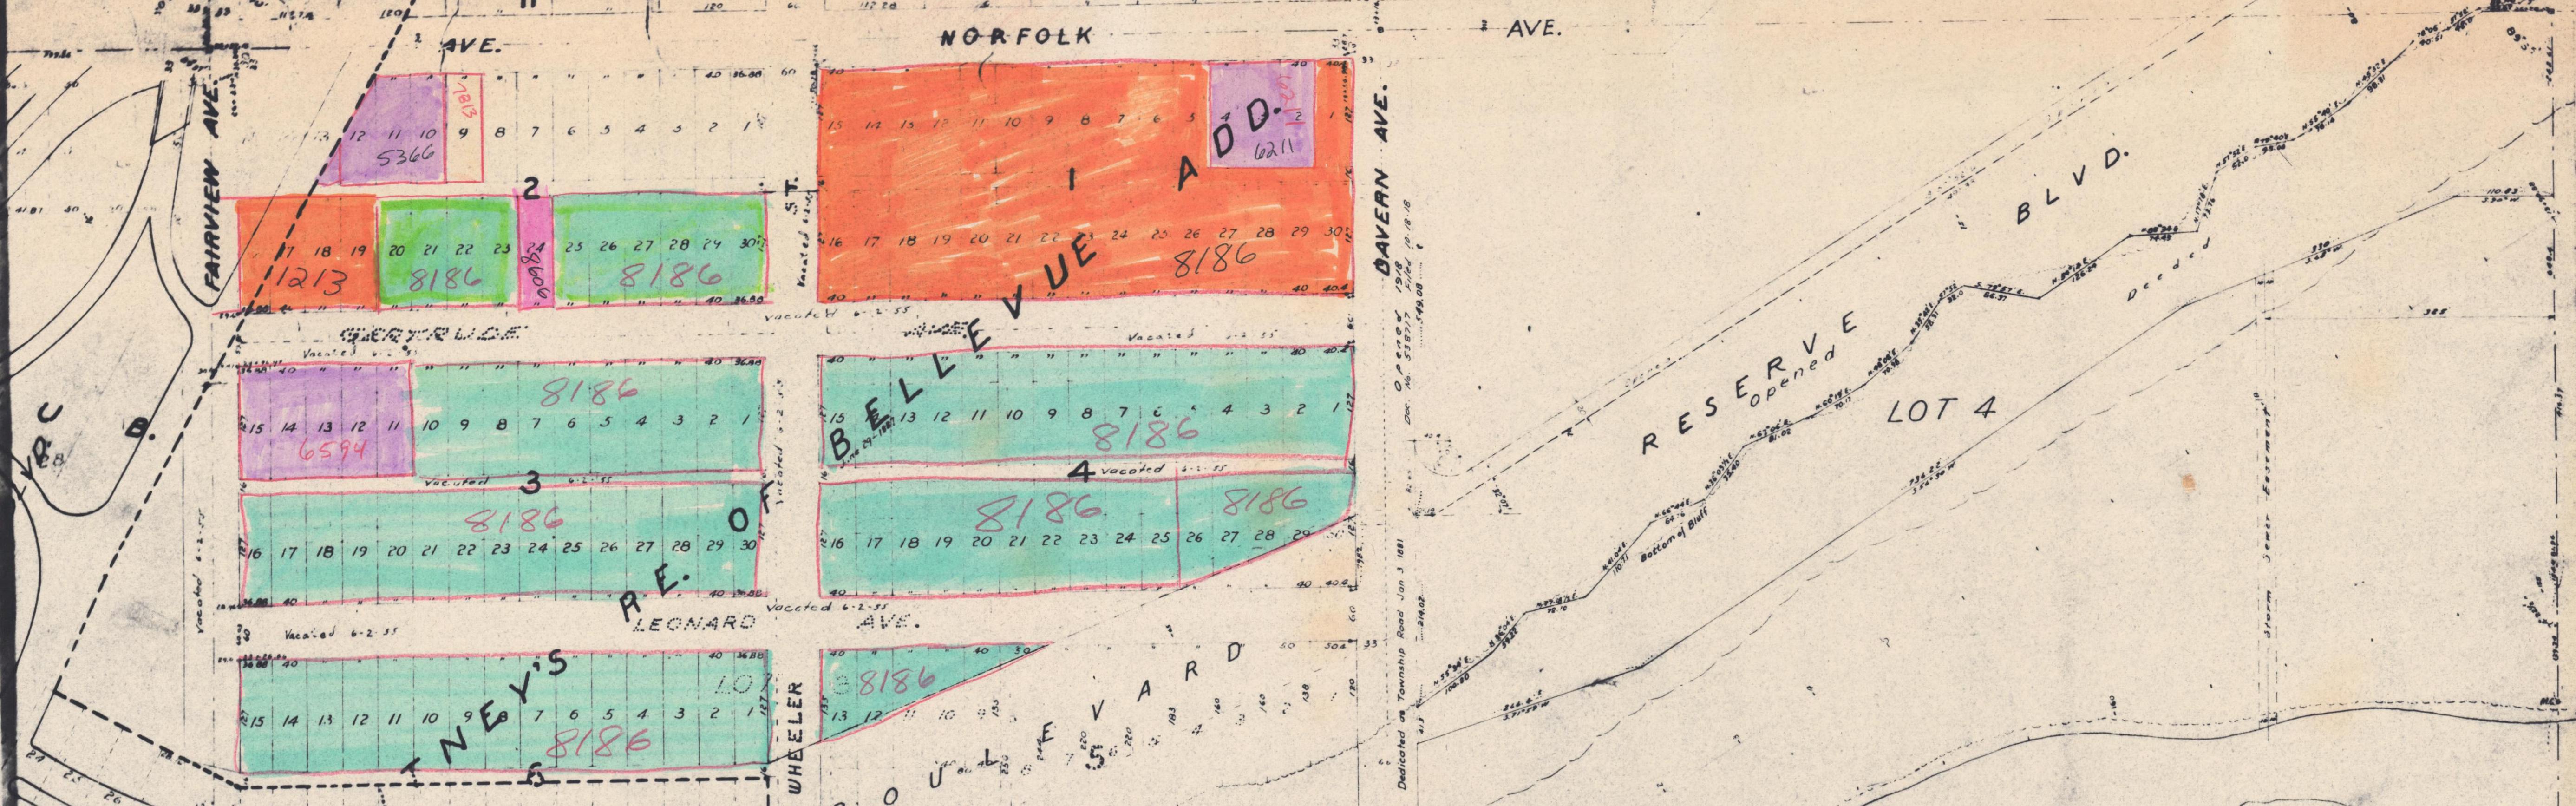

SE. 1/4 SEC. 21-28-23

SE. 1/4 SEC. 21-28-23

SE. 1/4  
21-28-23

P I K E