


S.E. 1/4 Sec. 24—29—23

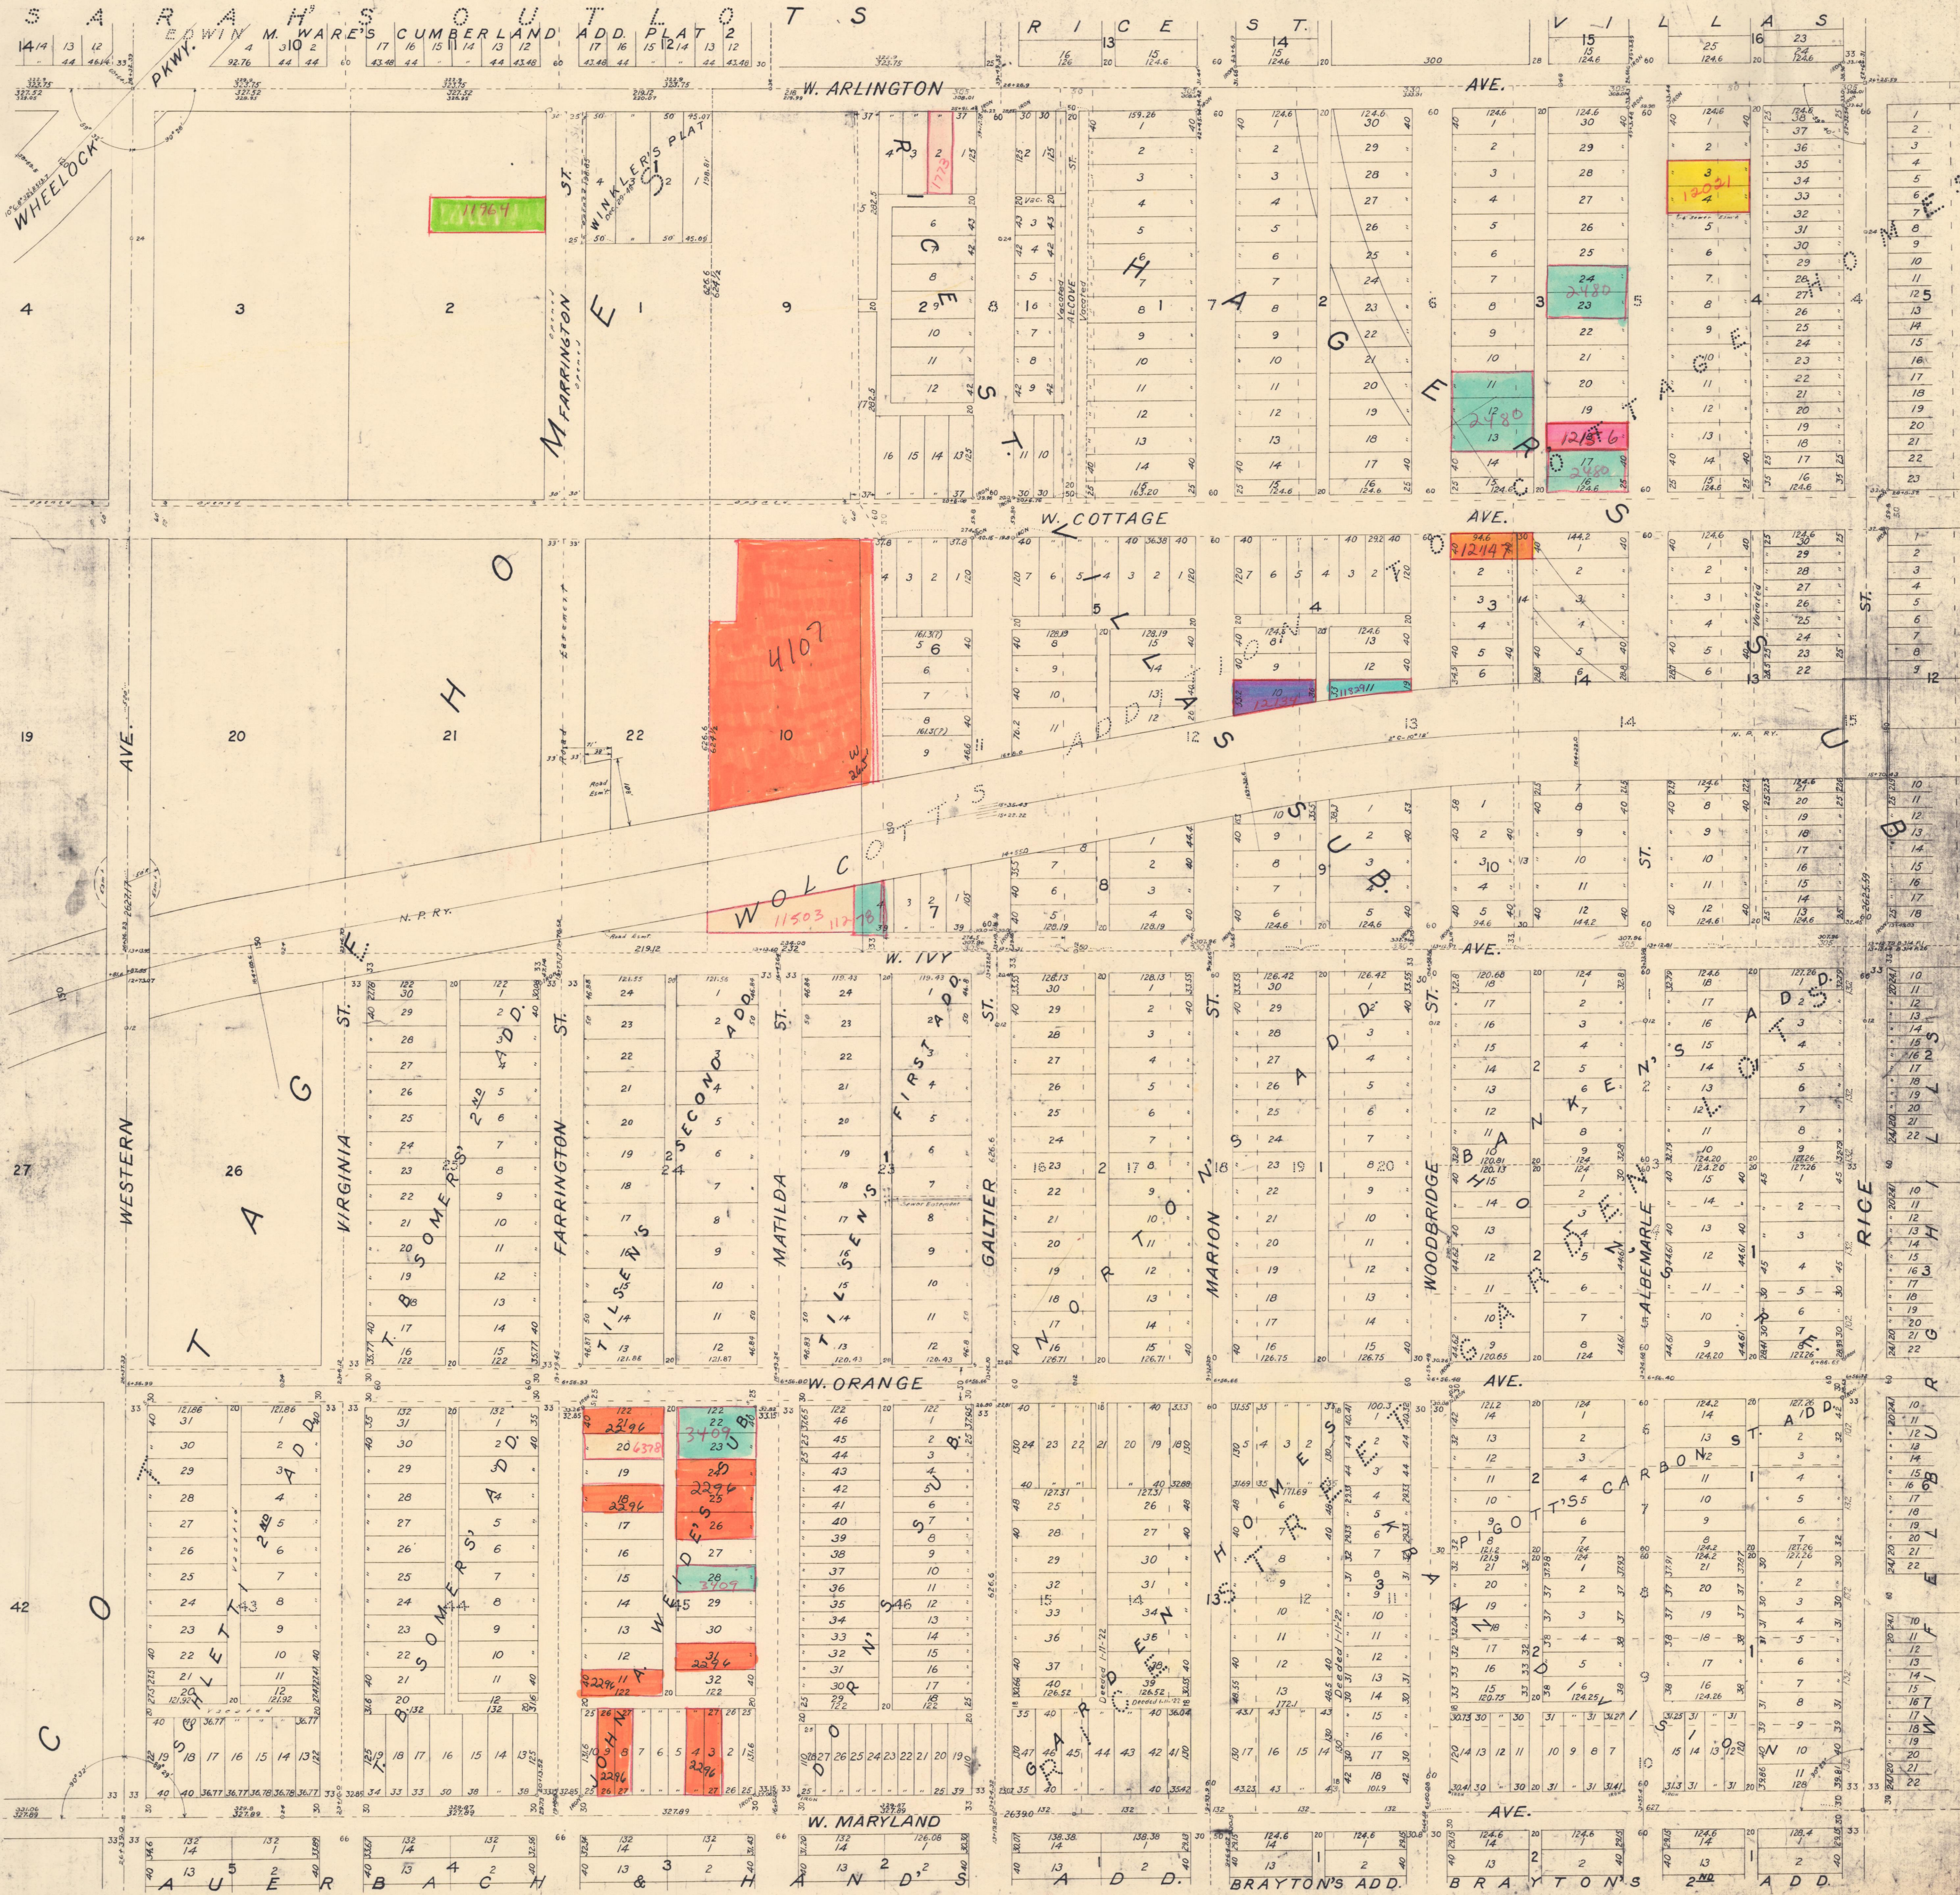

SE 1/4 24-29-23