


S. E. 1/4 Sec. 25—29—23

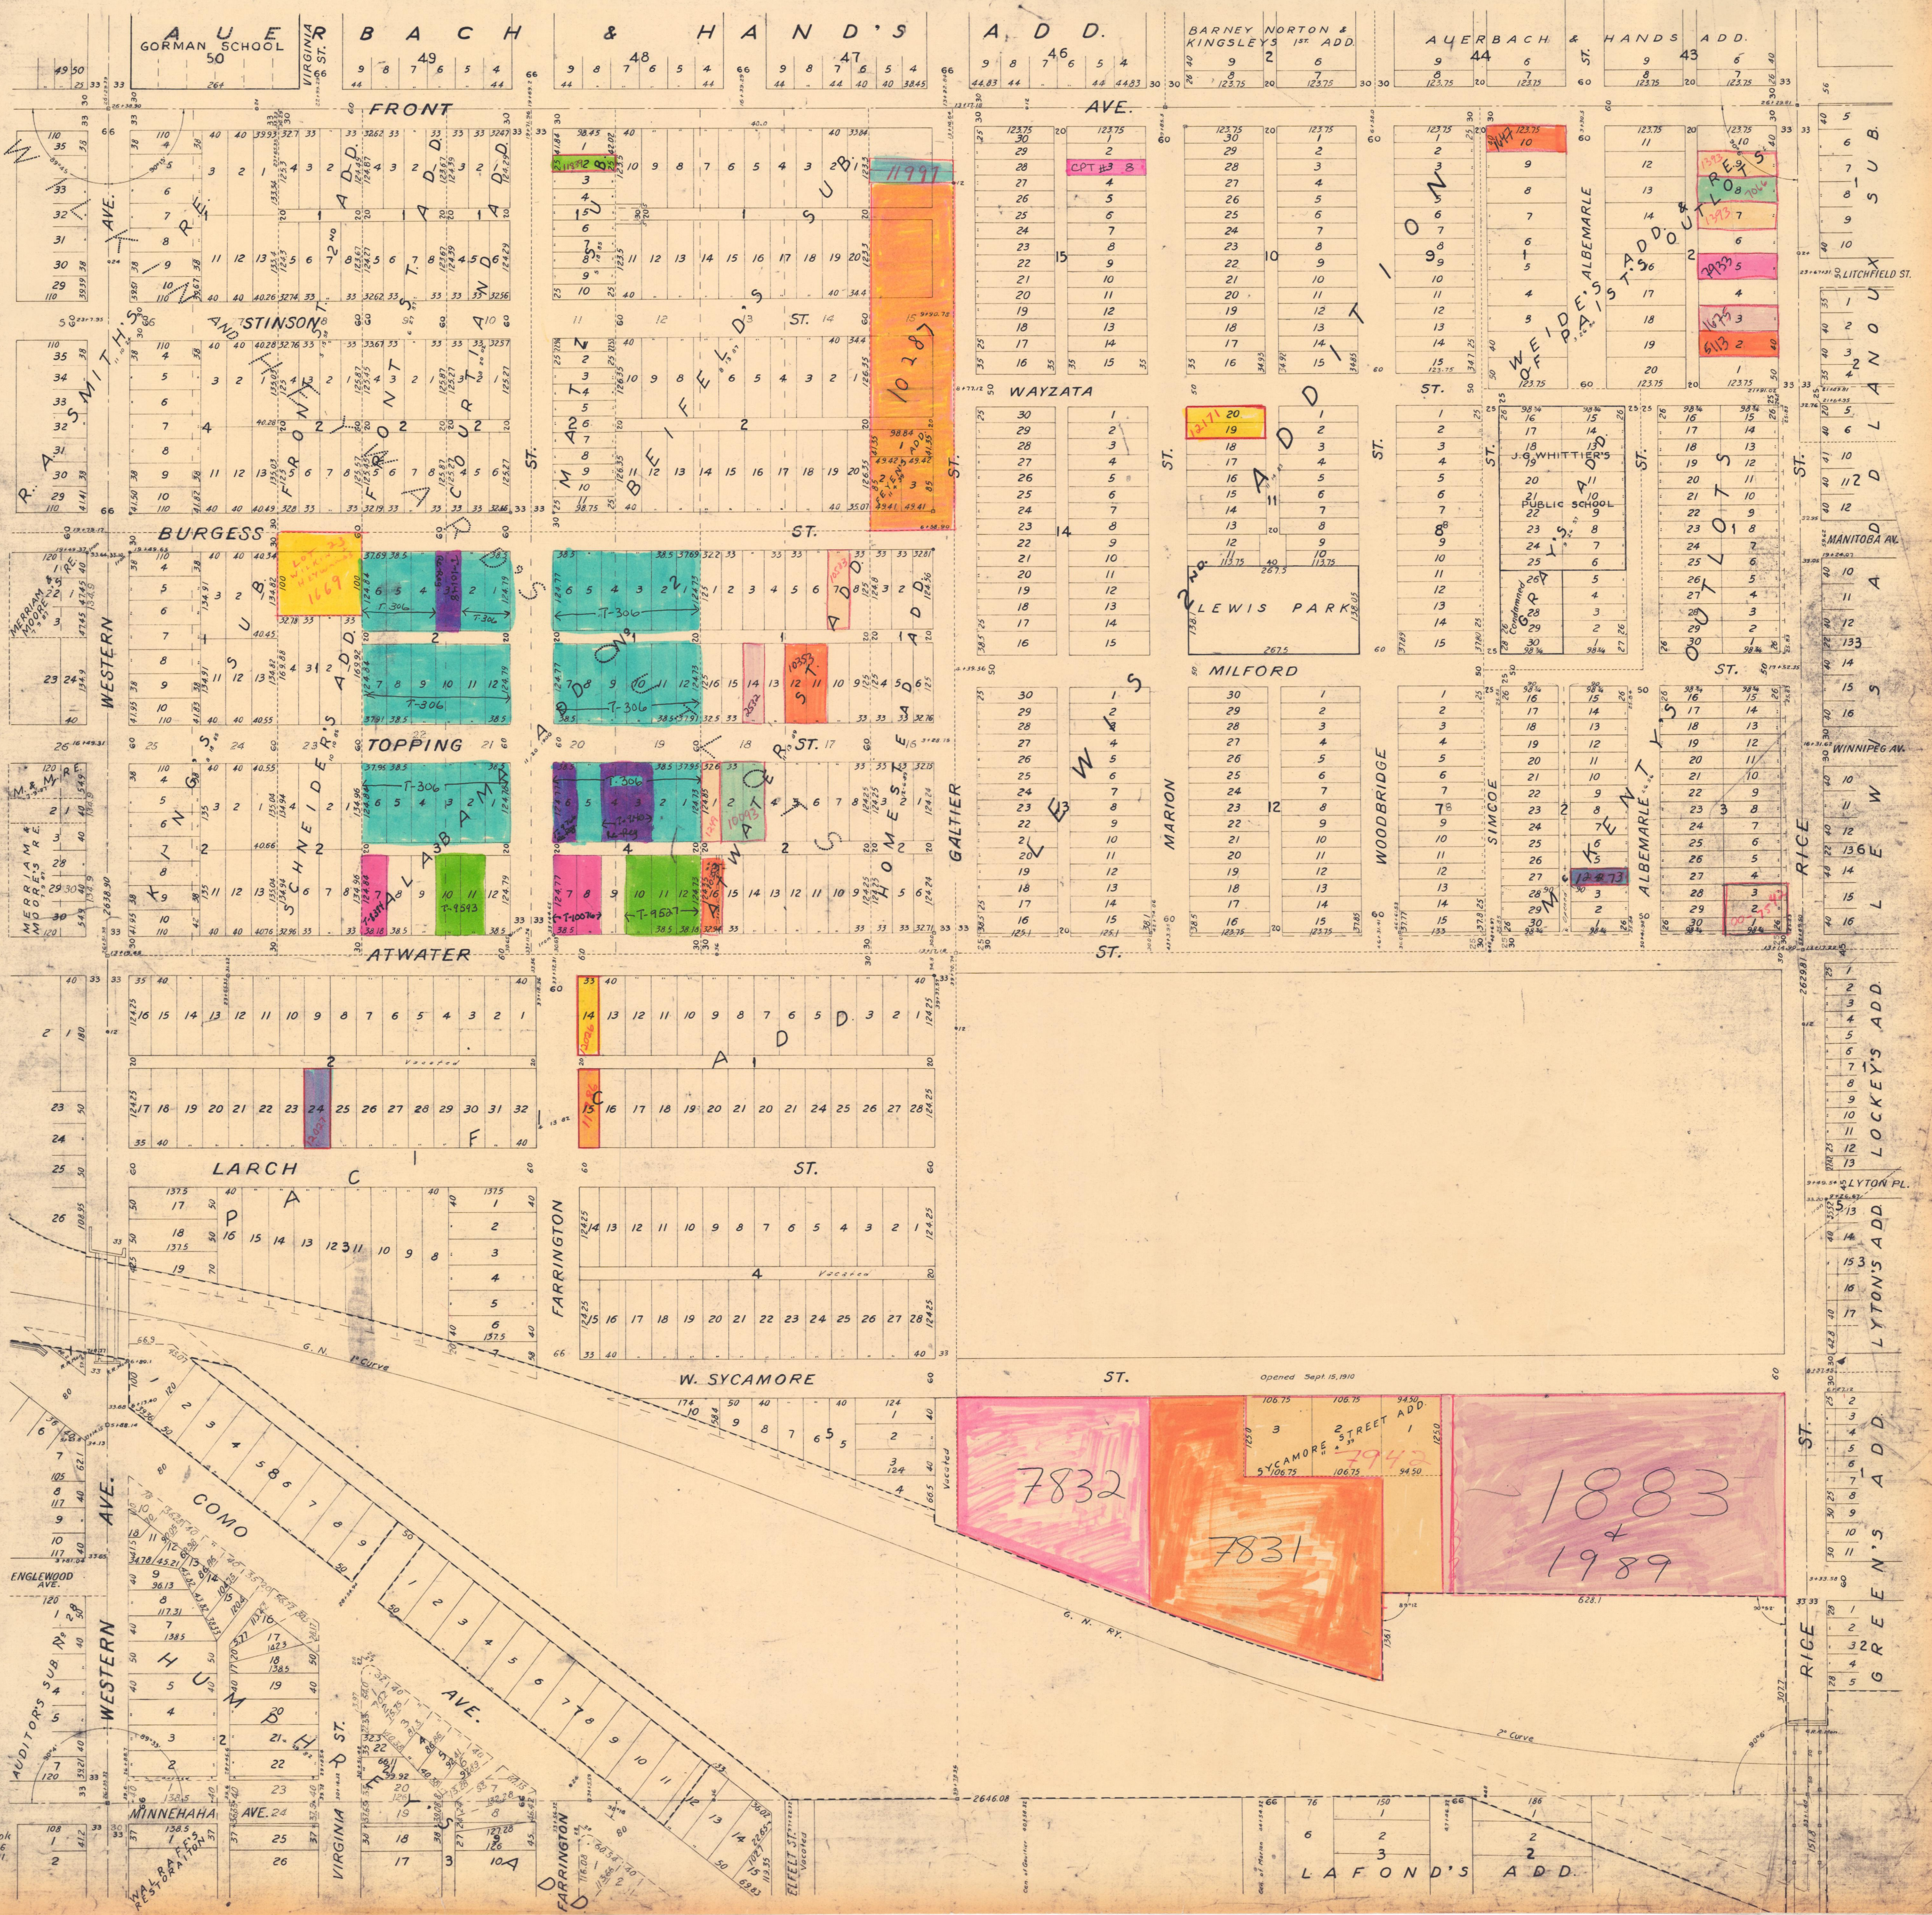

SE 1/4 25-29-23

Book 276 301

LAFOND'S ADD.

RICE ST.

GREEN'S ADD.

LYTON'S ADD.

LYTON PL.

WINNIEG AV.

MANITOBA AV.

LITCHFIELD ST.

ANON

ST.